

# **BUCKEYE TRAIL ASSOCIATION**


**FOREST SERVICE REGION 9** WAYNE NATIONAL FOREST **ATHENS UNIT** PERRY COUNTY, OHIO **ATHENS COUNTY, OHIO MORGAN COUNTY, OHIO** 

# **TRAIL CONSTRUCTION PLANS FOR** WAYNE NATIONAL FOREST TRAIL BRIDGES

### **INDEX OF SHEETS**

TITLE SHEET LOCATION MAP GENERAL NOTES GENERAL SUMMARY	1 2 3 4-5
NATURAL MATERIALS BRIDGES	
- STRUCTURE NOTES & ESTIMATED QUANTITIES	6
- SITE A - NCT ATHENS CENTRAL #3 OVER SNOW FORK	<del>7 - 10 -</del>
- SITE C - NCT ATHENS CENTRAL #2 OVER LONG RUN	<del>— 11 - 13 —</del>
GLULAM BEAM BRIDGES	
STRUCTURE NOTES & ESTIMATED QUANTITIES	14
SITE E - TRAIL OVER E BRANCH SUNDAY CREEK	15 - 19
SITE H - STONE CHURCH MAIN LOOP #3 OVER OLD STONE CHURCH CREEK	20 - 23
SITE I - NCT ATHENS CENTRAL #4 OVER ROCK RUN	24 - 27
PREFABRICATED TRUSS BRIDGES	
STRUCTURE NOTES & ESTIMATED QUANTITIES	28
SITE B - NCT ATHENS CENTRAL #1 OVER SUNDAY CREEK MAINSTEM	29 - 34
SITE D - TRAIL OVER W BRANCH SUNDAY CREEK	35 - 39
- SITE F - TRAIL OVER DANS RUN	<del>- 40 - 44 -</del>
SITE G - NCT ATHENS CENTRAL #5 OVER MONDAY CREEK	45 - 49



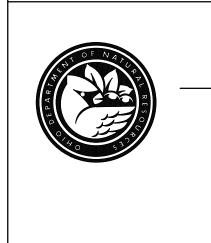

### **2014 USDA FOREST SERVICE SPECIFICATIONS**

THE STANDARD SPECIFICATIONS FOR CONSTRUCTION OF TRAILS AND TRAIL BRIDGES ON FOREST SERVICE PROJECTS OF THE US DEPARTMENT OF AGRICULTURE FOREST SERVICE SHALL GOVERN THIS IMPROVEMENT. THIS INCLUDES APPLICABLE SECTIONS AS REFERENCED HEREIN OF THE STANDARD SPECIFICATIONS FOR CONSTRUCTION OF ROADS AND BRIDGES ON FEDERAL HIGHWAY PROJECTS FP-03 BY THE US DEPARTMENT OF TRANSPORTATION FEDERAL HIGHWAY ADMINISTRATION.

#### SPECIAL PROVISIONS

NATIONWIDE PERMIT NWP 14 ELIGIBLE (NON-NOTIFYING PCN) DATED 2/12/24, SEE BID DOCUMENTS.

# WAYNE NATIONAL FOREST TRAIL BRIDGES **BUCKEYE TRAILS ASSOCIATION**

**DRAWING NAME** 

### **TITLE SHEET**

**GENERAL INFORMATION** 


BRIDGE


APPROVED FOR BID (OHIO DEPARTMENT OF NATURAL RESOURCES)

GLEN COBB, Division of Parks and Watercraft

DATE

REVISION DATE	SUBSET		
8/29/23	1 OF	5	
	SHEET		
NOT TO SCALE	1 OF	49	

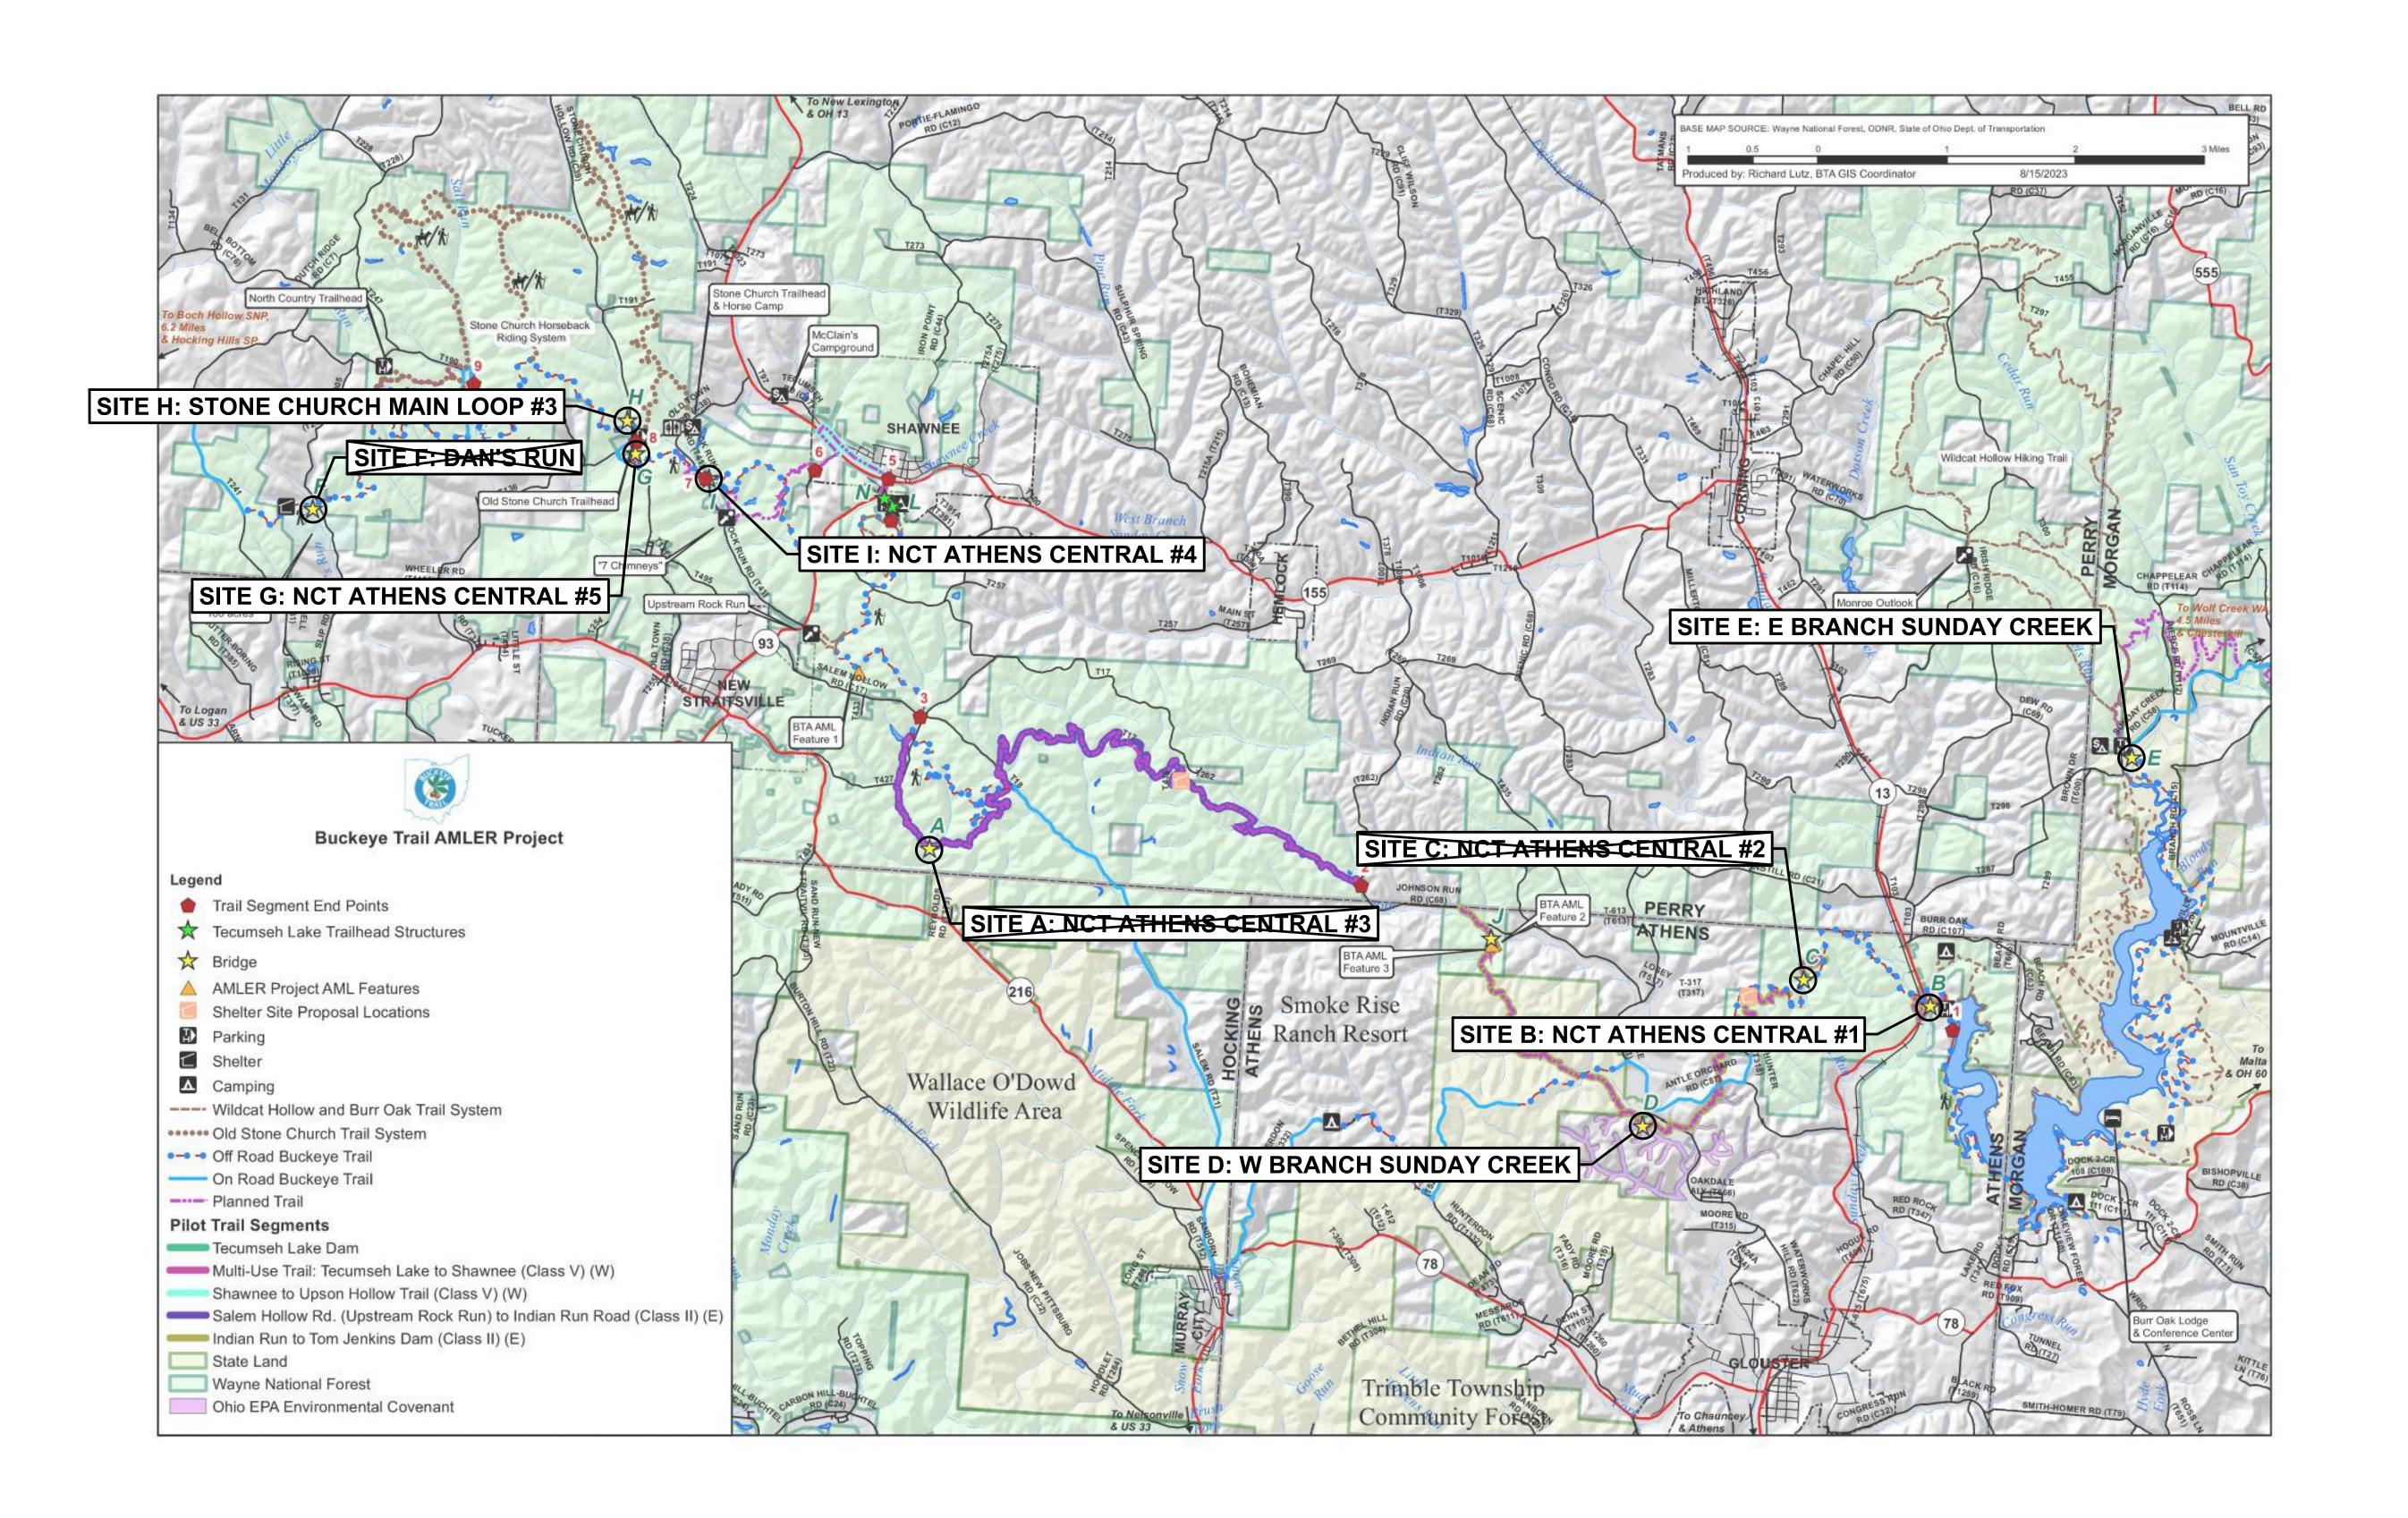

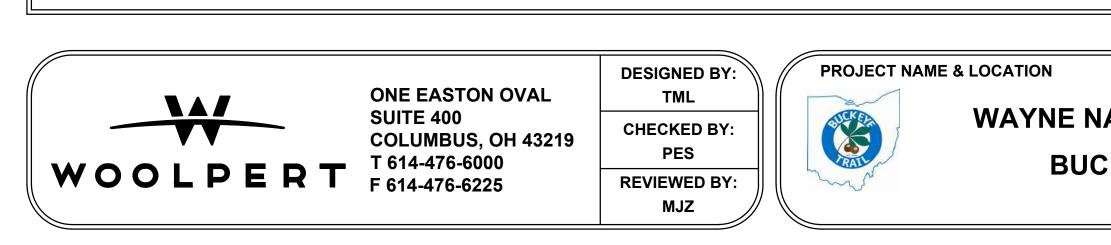


DRAWING NAME

LOCATION MAP

BRIDGE

**GENERAL INFORMATION** 

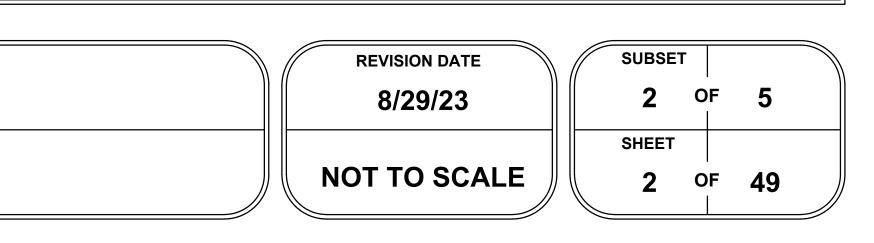

PROPERTY	<b>OWNERSHIP:</b>

THE FOLLOWING LIST PROVIDES THE PROPERTY OWNERS AND CONTACTS FOR EACH SITE. THE PROPERTY OWNER IS ALSO RESPONSIBLE FOR MAINTENANCE AND INSPECTION. US FOREST SERVICE

US FOREST SERVICE

USACE

- SITE A, NCT ATHENS CENTRAL #3: SITE B, NCT ATHENS CENTRAL #1: SITE C, NCT ATHENS CENTRAL #2: SITE D (W BRANCH SUNDAY CREEK): SITE E (E BRANCH SUNDAY CREEK): SITE F (DAN'S RUN): SITE G, NCT ATHENS CENTRAL #5:
- SITE H, STONE CHURCH MAIN LOOP #3: SITE I, NCT ATHENS CENTRAL #4:

OHIO DEPARTMENT OF NATURAL RESOURCES (ODNR)

OHIO DEPARTMENT OF NATURAL RESOURCES

#### CONTACTS:

BUCKEYE TRAILS ASSOCIATION (BTA) ANDREW BASHAW BUCKEYE TRAIL ASSOCIATION DIRECTOR director@buckeyetrail.org (740) 394-2008 127 B. WEST MAIN STREET SHAWNEE, OHIO 43782

CCU/BUCKINGHAM COAL ODNR BUCKEYE TRAILS ASSOCIATION WAYNE NATIONAL FOREST WAYNE NATIONAL FOREST WAYNE NATIONAL FOREST WAYNE NATIONAL FOREST

JASON REED

45764

ATHENS DISTRICT RANGER

13700 US-33, NELSONVILLE, OH

OHIO DEPARTMENT OF NATURAL RESOURCES (ODNR)

Jason.reed@usda.gov

(740) 447-3444

JERRY POLLOCK

PARK MANAGER

BURR OAK STATE PARK

jerry.pollock@dnr.ohio.gov

091401-1029-X.XXXX 091401-1029-X.XXXX 091401-1029-X.XXXX 091401-1029-X.XXXX

091401-1003-11.0230 091401-1029-X.XXXX

USE THE POSITIONING METHODS AND MONUMENT TYPE USED IN THE ORIGINAL SURVEY TO RESTORE ALL MONUMENTS RELATED TO PRIMARY PROJECT CONTROL THAT ARE DAMAGED OR DESTROYED BY CONSTRUCTION ACTIVITIES. RESTORE THE DAMAGED OR DESTROYED MONUMENTS IN ACCORDANCE WITH CMS 623.

**UTILITIES:** 

JEFF CALHOUN

(740) 274-4954

jeff.calhoun@dnr.ohio.gov

COLUMBUS, OH 43229

2045 MORSE ROAD BUILDING H2

THERE ARE NO KNOWN UNDERGROUND OR OVERHEAD UTILITIES WITHIN THE PROJECT CONSTRUCTION LIMITS. THE CONTRACTOR IS RESPONSIBLE FOR COORDINATION WITH 811 SERVICES FOR UTILITY LOCATION PRIOR TO ANY WORK.

### **ITEM 912: CLEARING AND GRUBBING**

DIVISION OF MINERAL RESOURCES MANAGEMENT (DMRM)

ALTHOUGH THERE ARE NO TREES OR STUMPS SPECIFICALLY MARKED FOR REMOVAL WITHIN THE LIMITS OF THE PROJECT, A LUMP SUM QUANTITY IS INCLUDED IN THE GENERAL SUMMARY FOR ITEM 91203, CLEARING AND GRUBBING. ALL PROVISIONS AS SET FORTH IN THE SPECIFICATIONS UNDER THIS ITEM ARE INCLUDED IN THE LUMP SUM PRICE BID FOR ITEM 91203, CLEARING AND GRUBBING.

### **ENDANGERED BAT HABITAT REMOVAL:**

THIS PROJECT IS LOCATED WITHIN THE KNOWN HABITAT RANGES OF THE FEDERALLY LISTED AND PROTECTED INDIANA BAT AND NORTHERN LONG-EARED BAT. NO TREES SHALL BE REMOVED UNDER THIS PROJECT FROM APRIL 1 THROUGH SEPTEMBER 30. ALL NECESSARY TREE REMOVAL SHALL OCCUR FROM OCTOBER 1 THROUGH MARCH 31. THIS REQUIREMENT IS NECESSARY TO AVOID AND MINIMIZE IMPACTS TO THESE SPECIES AS REQUIRED BY THE ENDANGERED SPECIES ACT (ESA). FOR THE PURPOSES OF THIS NOTE, A TREE IS DEFINED AS: A LIVE, DYING, OR DEAD WOODY PLANT, WITH A TRUNK 3 INCHES OR GREATER IN DIAMETER AT A HEIGHT OF 4.5 FEET ABOVE THE GROUND SURFACE, AND WITH A MINIMUM HEIGHT OF 13 FEET.

### **ENVIRONMENTAL COMMITMENTS:**

SEE BID DOCUMENTS, NATIONWIDE PERMIT 14 ELIGIBILITY DATED 2/12/24. ALL COMMITMENTS, ASSUMPTIONS OF IMPACTS, AND REQUIREMENTS ARE INCORPORATED HERE BY REFERENCE.

### **ITEM 911: EXCAVATION**


THIS ITEM INCLUDES ALL EXCAVATION REQUIRED FOR THE INSTALLATION OF THE BRIDGE FOUNDATIONS, CORRESPONDING SUPERSTRUCTURE AND APPLICABLE CHANNEL PROTECTION. CARE SHALL BE TAKEN TO DISPOSE OF WASTE MATERIAL IN ACCORDANCE WITH SPECIFICATIONS AND IN A MANNER THAT DOES NOT IMPACT "THE WATERS OF THE UNITED STATES" OR ANY ISOLATED WETLANDS, UNLESS OTHERWISE ALLOWED WITHIN THE PROJECT ENVIRONMENTAL PERMITS. ITEM 911: EXCAVATION SHALL BE PAID AS INCIDENTAL TO ITEM 965.

### **ITEM 911: BORROW**

THIS ITEM INCLUDES ALL BORROW MATERIALS NECESSARY TO CONSTRUCT THE APPROACH TRAIL UP TO THE ELEVATION OF THE BRIDGE STRUCTURE. BORROW SHALL BE ACQUIRED IN ACCORDANCE WITH APPLICABLE SPECIFICATIONS. PROPOSED BORROW SHALL NOT IMPACT "THE WATERS OF THE UNITED STATES". OR ANY ISOLATED WETLAND(S), UNLESS OTHERWISE ALLOWED WITHIN THE PROJECT ENVIRONMENTAL PERMITS.

THE CONTRACTOR SHALL NOT BORROW FROM A SITE KNOWN, OR SUSPECTED OF HAVING, CONTAMINATED SOIL OR WATER.

ITEM 911: BORROW SHALL BE PAID AS INCIDENTAL TO ITEM 965.

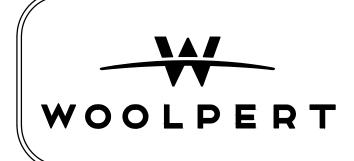

ONE EASTON OVAL **SUITE 400** COLUMBUS, OH 43219 T 614-476-6000 F 614-476-6225

**DESIGNED BY:** TML

CHECKED BY: PES **REVIEWED BY:** MJZ

**PROJECT NAME & LOCATION** 



#### SURVEYING PARAMETERS:

PRIMARY PROJECT CONTROL MONUMENTS GOVERN ALL POSITIONING PROJECTS. USE THE FOLLOWING PROJECT CONTROL, VERTICAL POSITIONING, AND HORIZONTAL POSITIONING PARAMETERS FOR ALL SURVEYING:

PROJECT CONTROL

POSITIONING METHOD: CONVENTIONAL TOTAL STATION FOR LOCAL COORDINATES LOCAL RTK AND CONVENTIONAL TOTAL STATION OFF OF VRS-ESTABLISHED MONUMENT 100 FOR GPS

MONUMENT TYPE: IRON PIN SET (IPS) WITH ALUMINUM/PLASTIC CAP, MAG NAILS

VERTICAL POSITIONING (FOR GPS COORDINATES)

ORTHOMETRIC HEIGHT DATUM: NAVD88 GEOID: GEOID18

HORIZONTAL POSITIONING (FOR GPS COORDINATES)

REFERENCE FRAME: NAD83 (2011) EPOCH: 2010.00

ELLIPSOID: GRS 80 MAP PROJECTION: LAMBERT CONIC CONFORMAL COORDINATE SYSTEM: OHIO SOUTH 3402 COMBINED SCALE FACTOR: 1.0000000 (NO SCALE FACTOR) PROJECT SCALE FACTOR: 1.0000000 (NO SCALE FACTOR) ORIGIN OF COORDINATE SYSTEM: GRID COORDINATES

UNITS ARE IN U.S. SURVEY FEET.

		SU	RVEY CON	TROL			
SITE	CONTROL POINT	TYPE	GRID NORTHING (US FEET)	GRID EASTING (US FEET)	ELEVATION (US FEET)	GPS OR LOCA COORDINATES	
А	114	IPS	5000.000	5000.000	100.000		
(NCT ATHENS	115	IPS	5062.980	5000.000	99.470	LOCAL	
CENTRAL #3)	116	IPS	5019.435	5059.290	100.310		
B (NCT ATHENS CENTRAL #1)	200	IPS	562968.07	2092728.82	704.73		
	401	MAG NAIL	562359.85	2092770.58	699.28	GPS	
	402	MAG NAIL	562716.53	2092855.59	705.89		
C (NCT ATHENS CENTRAL #2)			NOT	SURVEYED			
	100	IPS	576829.572	2054105.708	1056.709		
D (WEST BRANCH	118	IPS	557544.953	2080784.072	691.694		
SUNDAY CREEK)	119	IPS	557538.987	2080718.182	693.130	GPS	
	120	IPS	557585.048	2080703.674	693.224		
E	121	IPS	5000.000	5000.000	100.000		
(EAST BRANCH	122	IPS	4908.278	4970.464	99.810	LOCAL	
SUNDAY CREEK)	123	IPS	4976.806	5056.720	99.990		
	100	IPS	576829.572	2054105.708	1056.709		
-	110	IPS	582917.913	2026176.439	786.206	-	
F (DAN'S RUN)	111	IPS	582943.761	2026276.381	788.181	GPS	
	112	IPS	582867.740	2026132.346	795.136	-	
	113	IPS	582871.829	2026206.924	785.753	-	
	100	IPS	576829.572	2054105.708	1056.709		
G (NCT ATHENS	107	IPS	585131.103	2039349.125	747.394		
CENTRAL #5)	108	IPS	585196.406	2039362.668	746.793	- GPS	
	109	IPS	585073.955	2039375.529	746.695	-	
	100	IPS	576829.572	2054105.708	1056.709		
H	104	IPS	586497.584	2038997.466	751.127		
(STONE CHURCH MAIN LOOP #3)	105	IPS	586481.565	2038942.822	750.910	GPS	
	106	IPS	586562.477	2039004.661	751.357	1	
	100	IPS	576829.572	2054105.708	1056.709		
 (NOT ATHENS	101	IPS	583949.536	2042450.409	764.013	1	
(NCT ATHENS CENTRAL #4)	102	IPS	584027.594	2042497.238	763.660	GPS	
n • Z	103	IPS	584026.548	2042408.304	763.191	1	

#### **ABBREVIATIONS:**

ABUT.	_	ABUTMENT
В/	_	BOTTOM OF
BRG(S).	_	BEARING(S)
c/c	_	CENTER TO
Ć.J.	_	CONSTRUCT
C.J. Ç	_	CENTERLINE
CONST.	_	CONSTRUCT
DIA.	_	
DL	_	DEAD LOAD ELEVATION EXISTING
EL.	_	ELEVATION
EX.	—	EXISTING
F.A.	_	FORWARD A
F/F	—	FACE TO FAR SIDE FOOTING HIGH WATEF IRON PIN S
F.S.	—	FAR SIDE
FTG.	—	FOOTING
HW	—	HIGH WATER
IPS	—	IRON PIN S
MAX.	—	MAXIMUM MINIMUM NOMINAL
MIN.	—	MINIMUM
NOM.	—	NOMINAL
0.C.	_	ON-CENTER
0/0	_	OUT TO OU
PCPP	_	PERFORATE
PL	_	PLATE
PROP.	—	PROPOSED
R.A.	—	REAR ABUT SQUARE
SQ.	_	SQUARE
STA.		STATION
Т/	-	TOP OF
TBD	_	
TYP.	_	TYPICAL
W/	—	WITH

DRAWING NAME

#### **GENERAL NOTES**

WAYNE NATIONAL FOREST TRAIL BRIDGES **BUCKEYE TRAILS ASSOCIATION** 

**GENERAL INFORMATION** 

BRIDGE

CENTER TION JOINT ΓΙΟΝ


ABUTMENT ACE

SET

ED CORRUGATED PLASTIC PIPE

TMENT

TERMINED

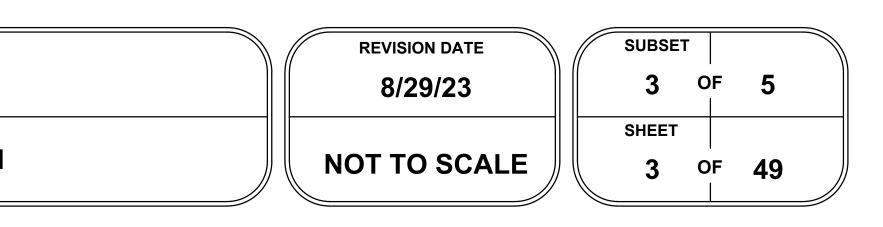

		GRAND	ITEM		JM.	SHEET NU	
DESCRIPTION	UNIT	TOTAL	EXT	ITEM	28	14	
STRUCTURE OVER 20 FOOT SPAN (SITE E – TRAIL OVER E. BRANCH SUNDAY (							
	LF DRILLED SHAFTS	94	56501	565		94	
	LF ROCK SOCKET	12	56502	565		12	
	MOBILIZATION	LS	90701	907		LS	
	CLEARING AND GRUBBING	LS	91203	912		LS	
	SF RIPRAP SURFACING, TYPE	554	91318	913		554	
	STAIRWAY, TYPE STAIRCASE	LS	96306	936		LS	
GTH 61'-6"	GLULAM STRINGER TRAIL B	LS	96302	963		LS	
REINFORCED CONCRETE ABUTMENT ON DRILLED SHAFT	2 TRAIL BRIDGE SUBSTRUCTU	EA	96501	965		2	
STRUCTURE OVER 20 FOOT SPAN (SITE I – NCT ATHENS CENTRAL #4 OVER ROO							
	MOBILIZATION	LS	90701	907		LS	
	CLEARING AND GRUBBING	LS	91203	912		LS	
	SF GEOSYNTHETIC SURFACING,	100	91322	913		100	
	CY FOUNDATION PREPARATION,	3	91830	918		3	
	GLULAM STRINGER TRAIL B	LS	96302	963		LS	
TIMBER SILL ON GEOCELL PAD		EA	96501	965	_	2	
			56561	505		2	
STRUCTURE OVER 20 FOOT SPAN (SITE D – TRAIL OVER W. BRANCH SUNDAY (							
	LF DRILLED SHAFTS	102	56501	565	102		
	LF ROCK SOCKET	20	56502	565	20		
	MOBILIZATION	LS	90701	907	LS		
	CLEARING AND GRUBBING	LS	91203	912	LS		
	SF RIPRAP SURFACING, TYPE	362	91318	913	362		
STEEL TRUSS, LENGTH 60'-0"		LS	96402	964	LS		
REINFORCED CONCRETE ABUTMENT ON DRILLED SHAFT		2	96501	965	2		
		-	00001				
STRUCTURE OVER 20 FOOT SPAN (SITE G - NCT ATHENS CENTRAL #5 OVER MONE							
	LF DRILLED SHAFTS	68	56501	565	68		
	LF ROCK SOCKET	12	56502	565	12		
	MOBILIZATION	LS	90701	907	LS		
	CLEARING AND GRUBBING	LS	91203	912	LS		
	SF RIPRAP SURFACING, TYPE	501	91318	913	501		
STEEL TRUSS, LENGTH 60'-0"	PREFABRICATED TRAIL BRID	LS	96402	964	LS		
	EACH TRAIL BRIDGE SUBSTRUCTU	2	96501	965	2		



ONE EASTON OVAL SUITE 400 COLUMBUS, OH 43219 DESIGNED BY: TML CHECKED BY: PES

**REVIEWED BY:** 

MJZ



# WAYNE NATIONAL FOREST TRAIL BRIDGES **BUCKEYE TRAILS ASSOCIATION**


DRAWING NAME

**GENERAL SUMMARY - BASE BIDS** 

BRIDGE

**GENERAL INFORMATION** 

	SEE SHEET NO.
Y CREEK)	
I CREEK)	
ROCK RUN)	
Y CREEK)	
NDAY CREEK)	

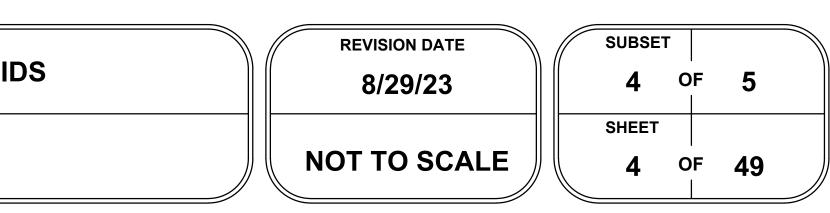

		GRAND	ITEM		IM.	SHEET NU		
DESCRIPTION	UNIT	TOTAL	EXT	ITEM	28		14	6
STRUCTURE OVER 20 FOOT SPAN (ALTERNATE 1 – SITE H – STONE CHURCH MAIN LOOP #3 OVER								
ATION		LS	90701	907			LS	
NG AND GRUBBING		LS	91203	912			LS	
ITHETIC SURFACING, TYPE GEOCELL (994.04)	SF	137	91322	913		,	137	
ATION PREPARATION, UNDERCUT CONTINGENCY, 4 CY	CY	4	91830	918			4	
D, TYPE BD4	EACH	4	94501	945			4	
STRINGER TRAIL BRIDGE, LENGTH 36'-6"		LS	96302	963			LS	
BRIDGE SUBSTRUCTURE, TYPE: TIMBER SILL ON GEOCELL PAD	EACH	2	96501	965			2	
STRUCTURE OVER 20 FOOT SPAN (ALTERNATE 2 – SITE A – NCT ATHENS CENTRAL #3 (								
ATION		LS	90701	907				LS
NG AND GRUBBING		LS	91203	912				LS
ITHETIC SURFACING, TYPE GEOCELL	SE.	69	91322	913				69
ATION PREPARATION, UNDERFUL CONTINGENCY, 5 CY		5	91830	918				5
LE LOG STRINGER TRAIL BRIDGE, TOTAL LENGTH = $36^{\circ}-6^{\circ}$			96105	961				LS
AY, TYPE OVERLAPPING TIMBER STEPS		LS	96306	963				LS
BRIDGE SUBSTRUCTURE, TYPE: TIMBER SILL ON GEOCELL PAD	EACH	1	96501	965				1
BRIDGE SUBSTRUCTURE, TYPE: TIMBER SILL ON GABION BASKET		1	96501	965				1
STRUCTURE OVER 20 FOOT SPAN (ALTERNATE 3 – SITE F – TRAIL OVER DAN								_
) SHAFTS	LF	57	56501	565	57			
SOCKET		12	50502	565	12			
		LS	90701	907	LS			
NG AND GRUBBING		LS	91203	912	LS			
SURFACING, TYPE C	SF	171	01310	913	171			
RICATED TRAIL BRIDGE, TYPE: STEEL TRUSS, LENGTH 60'-0"		LS	96302	963	21			
BRIDGE SUBSTRUCTURE, TYPE: REINFORCED CONCRETE ABUTMENT ON DRILLED SHAFT	EACH	2	96501	965	2			
STRUCTURE OVER 20 FOOT SPAN (ALTERNATE 4 – SITE B – NCT ATHENS CENTRAL $\#1$ OV								
) SHAFTS	LF	100	56501	565	100			
ATION		LS	90701	907	LS			
NG AND GRUBBING		LS	91203	912	LS			
SURFACING, TYPE C	SF	471	91318	913	471			
AY, TYPE STAIRCASE		LS	96306	936	LS			
RICATED TRAIL BRIDGE, TYPE: STEEL TRUSS, LENGTH 60'-0"		LS	96402	954	LS			
BRIDGE SUBSTRUCTURE, CONCRETE ABUTMENT ON SPREAD FOOTING	EACH	2	96501	965	2			
STRUCTURE OVER 20 FOOT SPAN (ALTERNATE 5 – SITE C – NCT ATHENS CENTRAL #2						_		
ATION		LS	90701	907				LS
NG AND GRUBBING			91203	912				LS
THETIC SURFACING, TYPE GEOCELL	SF	122	91322	913	+			122
ATION PREPARATION, UNDERCUT CONTINUENCY, Z CY		3	91830	918	+			3
LE LOG STRINGER TRAIL BRIDGE, TOTAL LENGTH 36'-0"		LS	91830	961	+			LS
AY, TYPE OVERLAPPING TIMBER STEPS		LS	96306	963				LS
BRIDGE SUBSTRUCTURE, TYPE: TIMBER SILL ON GEOCELL PAD	EACH	F	96501	965				2
(1)			30001	300		-		



ONE EASTON OVAL SUITE 400

DESIGNED BY: TML

CHECKED BY: PES **REVIEWED BY:** MJZ

**PROJECT NAME & LOCATION** 

mys



# WAYNE NATIONAL FOREST TRAIL BRIDGES **BUCKEYE TRAILS ASSOCIATION**


DRAWING NAME

### **GENERAL SUMMARY - ALTERNATES**

BRIDGE

# **GENERAL INFORMATION**

	SEE SHEET NO.
R OLD STONE CHURCH CREEK)	
OVER SNOW FORK)	
OVER SNOW FORK)	
ANS RUN)	
OVER SUNDAY CREEK)	
2 OVER LONG RUN)	
	1

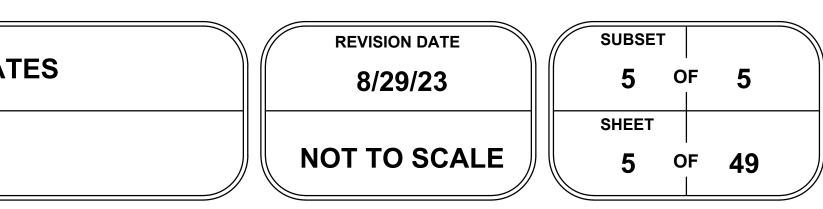

#### STANDARD DRAWINGS

ER TO U.S. DEPARTMENT OF AGRICULTURE FOREST SERVICE STANDARD TRAIL PLANS: LOG STRINGER TRAIL BRIDGE 96 965 -RAIL BRIDGE SUBSTRUCTURES

#### DESIGN SPECIEICATIONS:

- THIS STRUCTURE SHALL CONFORM TO THE FOLLOWING SPACIFICATIONS: THE 2009 AASHTO GUIDE SPECIFICATIONS FOR THE DESIGN OF PEDESTRIAN BRIDGE INCLUDING THE 2015 INTERIMS
- THE 2020 AASHTO LRFD BRIDGE DESIGN SPECIFICATION, 9TH EDITION
  THE 2014 FSH 7709.56b- TRANSPORTATION STRUCTURES HANDBOOK, CHAPTER 80 TRAIL BRIDGE DESIGN
- THE 2018 NATIONAL DESIGN SPECIFICATION FOR WOOD CONSTRUCTION

MATERIALS AND CONSTRUCTION OF THIS STRUCTURE SNALL BE IN ACCORDANCE WITH THE STANDARD SPECIFICATION FOR CONSTRUCTION OF TRAILS AND TRAIL BRIDGES ON FOREST SERVICE PROJECTS DATED 10-30-2014, AND APPLICABLE SECTIONS AS REFERENCED HEREIN OF THE STANDARD SPECIFICATIONS FOR CONSTRUCTION OF ROADS AND BRIDGES ON FEDERAL HIGHWAY PROJECTS FP-03 BY THE U.S. DEPARTMENT OF TRANSPORTATION FEDERAL HIGHWAY ADMINISTRATION.

#### **DESIGN LOADING:**

PEDESTRIAN LOADING: 0.090 KSF

#### **DESIGN STRESSES:**

TIMBER BEAMS: SITE A: BENDING, Fb' = 1,778 PSI SHEAR, Fv' = 356 PSI MODULUS OF ELASTICITY, E' = 1,200,000 PSI SITE C: BENDING, Fb' = 1,182 PSI SHEAR. Fv' = 335 PSI MODULUS OF ELASTICITY, E' = 1,000,000 PSI

#### LOG MEMBERS:

SITE A:

LOGS USED FOR STRINGERS SHALL BE PINE WITH MINIMUM, PEELED, MID-SPAN LOG DIAMETER AS NOTED FOR THE INDICATED SPAN. NATIVE TREES TO BE USED FOR BRIDGE STRINGERS SHALL BE STRAIGHT, SOUND, AND FREE OF DEFECTS AND ROT. STRINGERS SHALL BE CHOSEN FROM TREES WITH RELATIVELY FEW LIMBS, AND HAVE NO KNOT GREATER THAN 3-INCH IN DIAMETER LOGS SHALL BE DAPPED AT ENDS TO CREATE A LEVEL BEARING SURFACE AT SUPPORTS TAKING CARE TO AVOID OVER CUTTING. HEWN UPPER SURFACE OF LOGS TO PROVIDE A LEVEL TREAD SURFACE REFER. TO PLANS FOR HEWN DETAILS.

SITE C:

LOGS USED FOR STRINGERS SHALL BE OAK WITH MINIMUM, PEELED, MID-SPAN LOG DIAMETER AS NOTED FOR THE INDICATED SPAN. NATIVE TREES TO BE USED FOR BRIDGE STRINGERS SHALL BE STRAIGHT, SOUND, AND FREE OF DEFECTS AND ROT. STRINGERS SHALL BE CHOSEN FROM TREES WITH RELATIVELY FEW LIMBS, AND HAVE NO KNOT GREATER THAN 3-INCH IN DIAMETER LOGS SHALL BE DAPPED AT ENDS TO CREATE A LEVEL BEARING SURFACE AT SUPPORTS TAKING CARE TO AVOID OVER CUTTING. HEWN UPPER SURFACE OF LOGS TO PROVIDE A LEVEL TREAD SURFACE REFER. TO PLANS FOR HEWN DETAILS.

#### TIMBER AND LUMBER:

SOLID SAWN TIMBER MEMBERS SHALL CONFORM TO THE REQUIREMENTS OF THE GRADING RULES AGENCY FOR THE SPECIES, TYPE, AND GRADE SPECIFIED BELOW.

- DECK PLANKS, SILLS, AND BACKING PLANKS SOUTHERN PINE ROUGH SAWN NO.1 GRADE, TREATED, GRADING RULES AGENCY - WWPA, WCLIB
- <u>RUNNING PLANKS</u> - SOUTHERN PINE ROUGH SAWN NO.2 GRADE, TREATED, GRADING RULES AGENCY - WWPA, WCLIB RAILS & POSTS
- WESTERN RED CEDAR, S4S, SELECT STRUCTURAL GRADE GRADING RULES AGENCY WWPA, WCLIB
- HEM FIR/DOUGLAS FIR, S4S, NO.1 GRADE, TREATED, GRADING RULES AGENCY WWPA, WCLIB - SOUTHERN PINE ROUGH SAWN NO.1 GRADE, TREATED, GRADING RULES AGENCY - WWPA, WCLIB

#### **TREATMENT:**


PRESERVATIVE TREATMENT SHALL BE IN ACCORDANCE WITH THE CURRENT AMERICAN MOOD PROTECTION ASSOCIATION (AWPA) SPECIFICATIONS USING THE TREATMENT MATERIALS LISTED BELOW. TREATMENT WILL COMPLY WITH THE STITUTE (WWPI) "BEST MANAGEMENT REQUIREMENTS OF THE CURRENT EDITION OF WESTERN WOOD PRESERVERS PRACTICES FOR THE USE OF TREATED WOOD IN AQUATIC ENVIRONMENTS

- DECKING, RUNNING PLANKS, & RAILING SYSTEM
- AWPA USE CATEGORY SYSTEM (U1) FOR USE CATEGORY FC GROUND CONTACT EXTREME DUTY (UC4C), TYPE CuN, MCA, OR OTHER WATERBORNE PRÉSERVATIVE STRINGERS, SILLS, BACKING PLANKS, CRIBS, 8 BER WALLS
- AWPA USE CATEGORY SYSTEM (U1) FOR USE CATEGORY 4C GROUND CONTACT EXTREME DUTY (UC4C), TYPE CuN

#### FIELD TREATMENT

COPPER NAPHTHENATE (22 SOLUTION) SHALL BE FURNISHED FOR FIELD TREATING OF WOOD. ALL ABRASIONS AND FIELD CUTS - APPROVE BY THE C.O.R. — SHALL BE CAREFULLY TRIMMED AND GIVEN THREE BRUSH COATS OF THE FIELD TREATMENT S UTION. WHERE APPROVED, FIELD DRILLING OF BOLT, SCREW OR NAIL HOLES IS REQUIRED. THE FILLED WITH PRESERVATIVE PRIOR TO INSERTING THE FASTENERS HOLES SHALL BE

IF UNTREATED LOG STRINGERS, SHALL ALSO RECEIVE THREE BRUSH COATS OF THE FIELD TREATMENT PRIOR THE END ALLATION OF THE BACKING PLANKS.

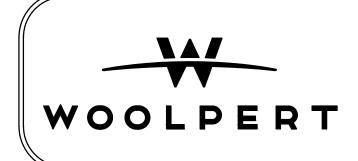

**ONE EASTON OVAL SUITE 400** COLUMBUS, OH 43219 T 614-476-6000 F 614-476-6225

**DESIGNED BY:** RAR

CHECKED BY: MJZ **REVIEWED BY:** TML

**PROJECT NAME & LOCATION** 



### HARDWARE AND STRUCTURAL STEEL:

GALVANIZED HARDWARE SHALL MEET THE REQUIREMENTS OF AASHTO M270, GRADE 36, WITH NUTS AND BOLTS CONFORMING TO ASTM A307, GRADE A. USE GALVANIZED ASTM F436 WASHERS AGAINST WOOD UNLESS OTHERWISE NOTED.

WHEN STRUCTURAL STEEL IS TO BE WELDED, THE WELDING PROCEDURE SHALL BE IN ACCORDANCE WITH AWS D1.1 AND SHALL BE SUITABLE FOR THE GRADE OF STEEL AND INTENDED USE OR SERVICE.

#### **FABRICATION**:

SUBMIT SHOP DRAWINGS FOR ALL MANUFACTURED BRIDGE COMPONENTS (EXCEPT TIMBER RUNNING PLANKS). SHOW ALL DIMENSIONS AND FABRICATION DETAILS FOR ALL CUT OR BORED TIMBER.

TREES TO BE USED FOR STRINGERS SHALL BE PEELED AND THEN HAVE AN ADDITIONAL 1/2-INCH OF THE OUTER SAPWOOD REMOVED PRIOR TO BEING USED FOR STRINGERS.

#### FOUNDATION BEARING RESISTANCE:

SITE A: ABUTMENT FOUNDATIONS, AS DESIGNED, PRODUCE A MAXIMUM STRENGTH LIMIT STATE BEARING PRESSURE OF 1.26 KIPS PER SQUARE FOOT. THE FACTORED DESIGN BEARING RESISTANCE IS 1.50 KIPS PER SQUARE FOOT.

SITE C: ABUTMENT FOUNDATIONS, AS DESIGNED, PRODUCE A MAXIMUM STRENGTH LIMIT STATE BEARING PRESSURE OF 1.39 KIPS PER SQUARE FOOT. THE FACTORED DESIGN BEARING RESISTANCE IS 1.50 KIPS PER SQUARE FOOT.

### FOUNDATION MATERIAL:

THE CONTRACTOR SHALL RETAIN THE SERVICES OF "QUALIFIED TECHNICIAN" DEFINED AS A GEOTECHNICAL ENGINEER. GEOTECHNICAL TECHNICIAN, GEOLOGIST, OR OTHER INDIVIDUAL TRAINED IN THE FIELD IDENTIFICATION AND CLASSIFICATION OF SOILS (COMPLETED THE ODOT "SOIL AND ROCK CLASSIFICATION" COURSE OR THE NHI COURSE 32079 SUBSURFACE INVESTIGATION QUALIFICATION.

CAVATION AND PRIOR TO THE CONSTRUCTION OF THE GABION FOUNDATIONS, THE QUALIFIED TECHNICIAN AFTFF AFTER EXCAVATION AND PRIOR TO THE CONSTRUCTION OF THE GABION FOUNDATIONS, THE GOALIFIED TECHNICIAN SHALL INSPECT THE BOTTOM SURFACE OF THE EXCAVATION. IF ANY AREAS OF THE SOIL ARE DETERMINED BY THE OBALIFIED TECHNICIAN TO BE UNSUITABLE, THEN THE EXCAVATION SHALL BE UNDERCUT IN 1 FOOT INCREMENTS UNTIL SUITABLE MATERIALS ARE ENCOUNTERED OR TO A MAXIMUM DEPTH OF 3 FEET AND FILLED WITH SUITABLE MATERIALS UP TO THE LEVEL OF THE PROPOSED BOTTOM OF FOUNDATION ELEVATION AND COMPACTED IN ACCORDANCE WITH SPECIFICATIONS 911.20. IF UNSUITABLE MATERIALS ARE STILL PRESENT AFTER A 3 FOOT UNDERCUT, THE ENGINEER SHALL BE CONTACTED BEFORE WORK PROCEEDS. THE QUALIFIED TECHNICIAN SHALL DOCUMENT THE SUBSURFACE CONDITION WITH PHOTOGRAPHS AND ANY FIELD TESTING RESULTS PERFORMED AND SUBMIT THE RESULTS AND PHOTOGRAPHS TO THE ENGINEER.

A QUANTITY OF 8 CY IS PROVIDED IN THE PLANS FOR UNDERCUT CONTINGENCY. PAYMENT FOR UNDERCUT SHALL INCLUDE ALL COSTS ASSOCIATED WITH THE UNDERCUTTING, FILLING, AND COMPACTION, INCLUDING ALL LABOR, EQUIPMENT, MATERIALS, AND INCIDENTALS TO COMPLETE THE WORK. THIS ITEM SHALL ONLY BE USED IF DIRECTED IS ITEM SHALL ONLY BE USED IF DIRECTED BY THE ENGINEER AND SHALL BE PAID FOR UNDER ITEM 1830 FOUNDATION PREPARATION: UNDERCUT CONTINGENCY. ON A PER CUBIC YARD BASIS.

# GEOSYNTHETIC SURFACING TYPE GEOCELL:

THE INTENT OF THIS ITEM IS TO PROVIDE A LIGHTWEIGHT SLOPE PROTECTION T PROTECT THE EMBANKMENT AROUND THE ABUTMENTS. THE CONTRACTOR SHALL PROVIDE AND INSTALL A GEOCELL PRODUCT THAT IS SPECIFICALLY DESIGNED FOR SLOPE STABILIZATION OF EMBANKMENTS UP TO A 1:1 SLOPE. THE CONTRACTOR SHALL SUBMIT THE SUPPORTING DOCUMENTATION FROM THE MINUFACTURER INCLUDING APPROPRIATENESS FOR APPLICATION, INSTALLATION RECOMMENDATIONS, AND WFILL REQUIREMENTS. THE GEOCELL SHALL BE INSTALLED AND INFILLED PER THE MANUFACTURER RECOMMENDATIONS.


# WAYNE NATIONAL FOREST TRAIL BRIDGES **BUCKEYE TRAILS ASSOCIATION**


#### DRAWING NAME **STRUCTURE NOTES - NATURAL MATERIALS BRIDGES**

BRIDGE

#### NATURAL MATERIALS

HEWN LOG TO PROVIDE FLAT -SURFACE FOR BEARING AND

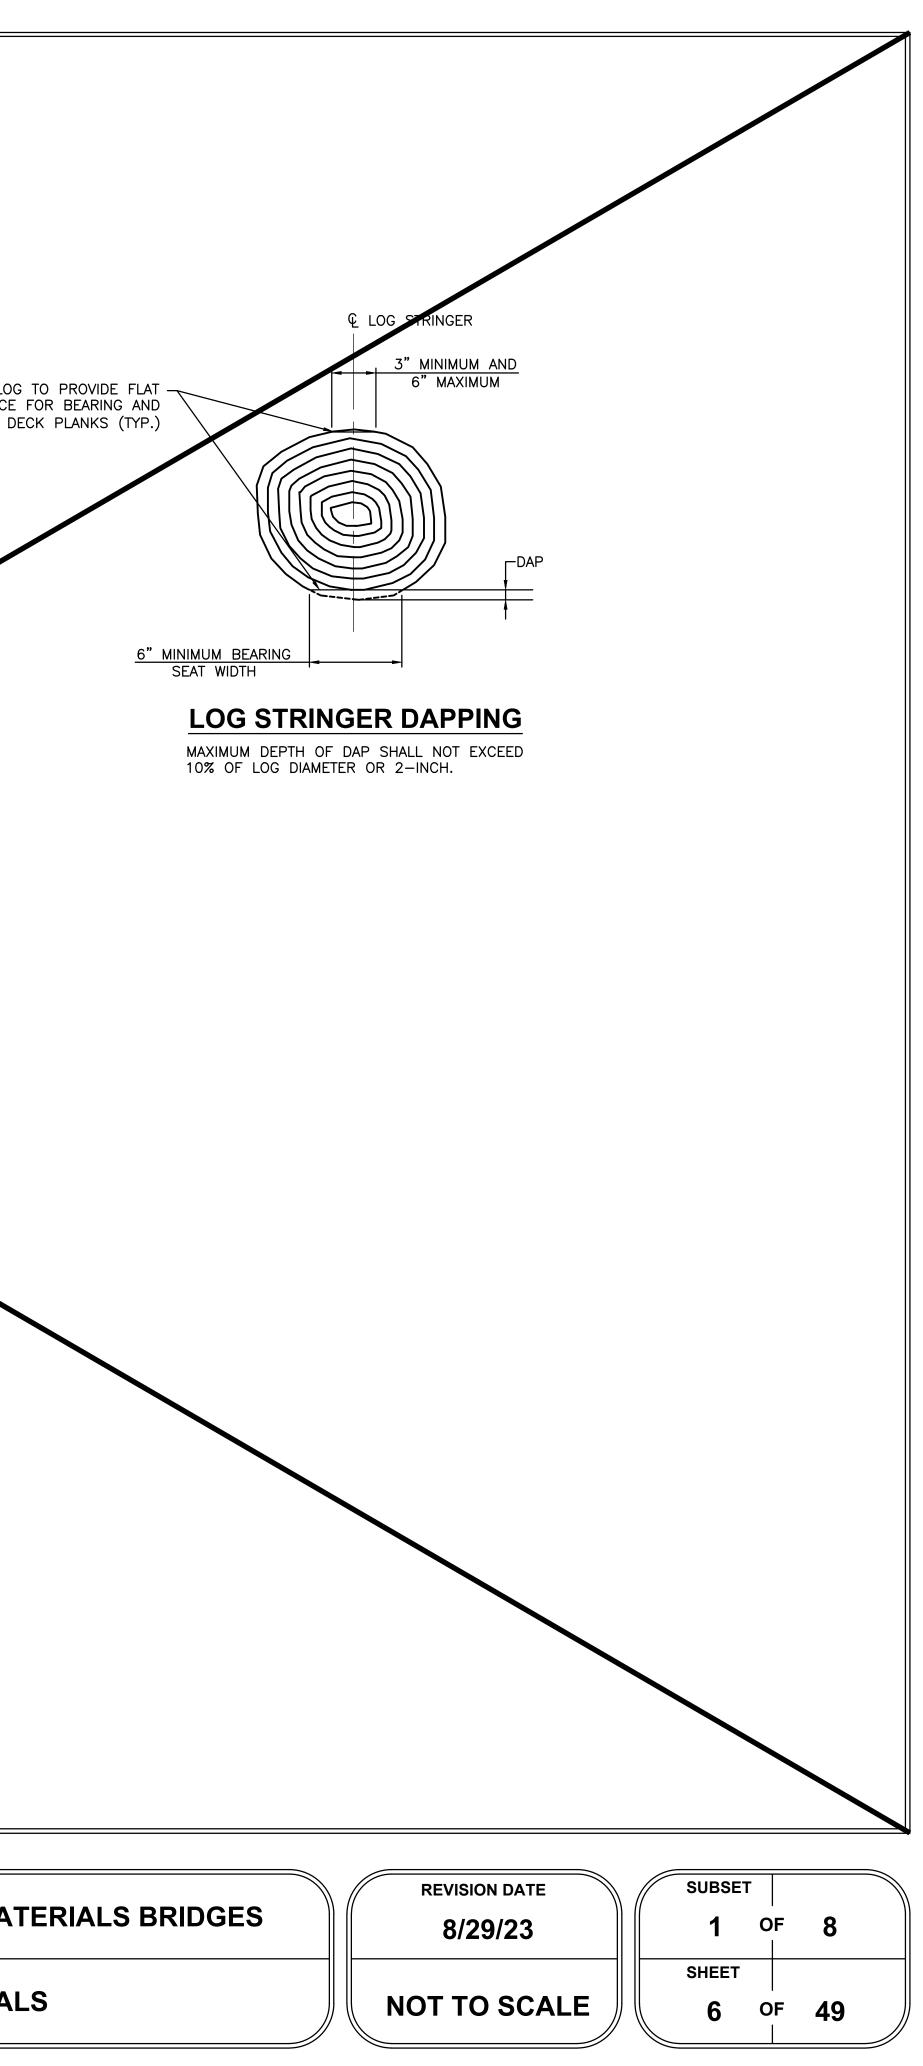

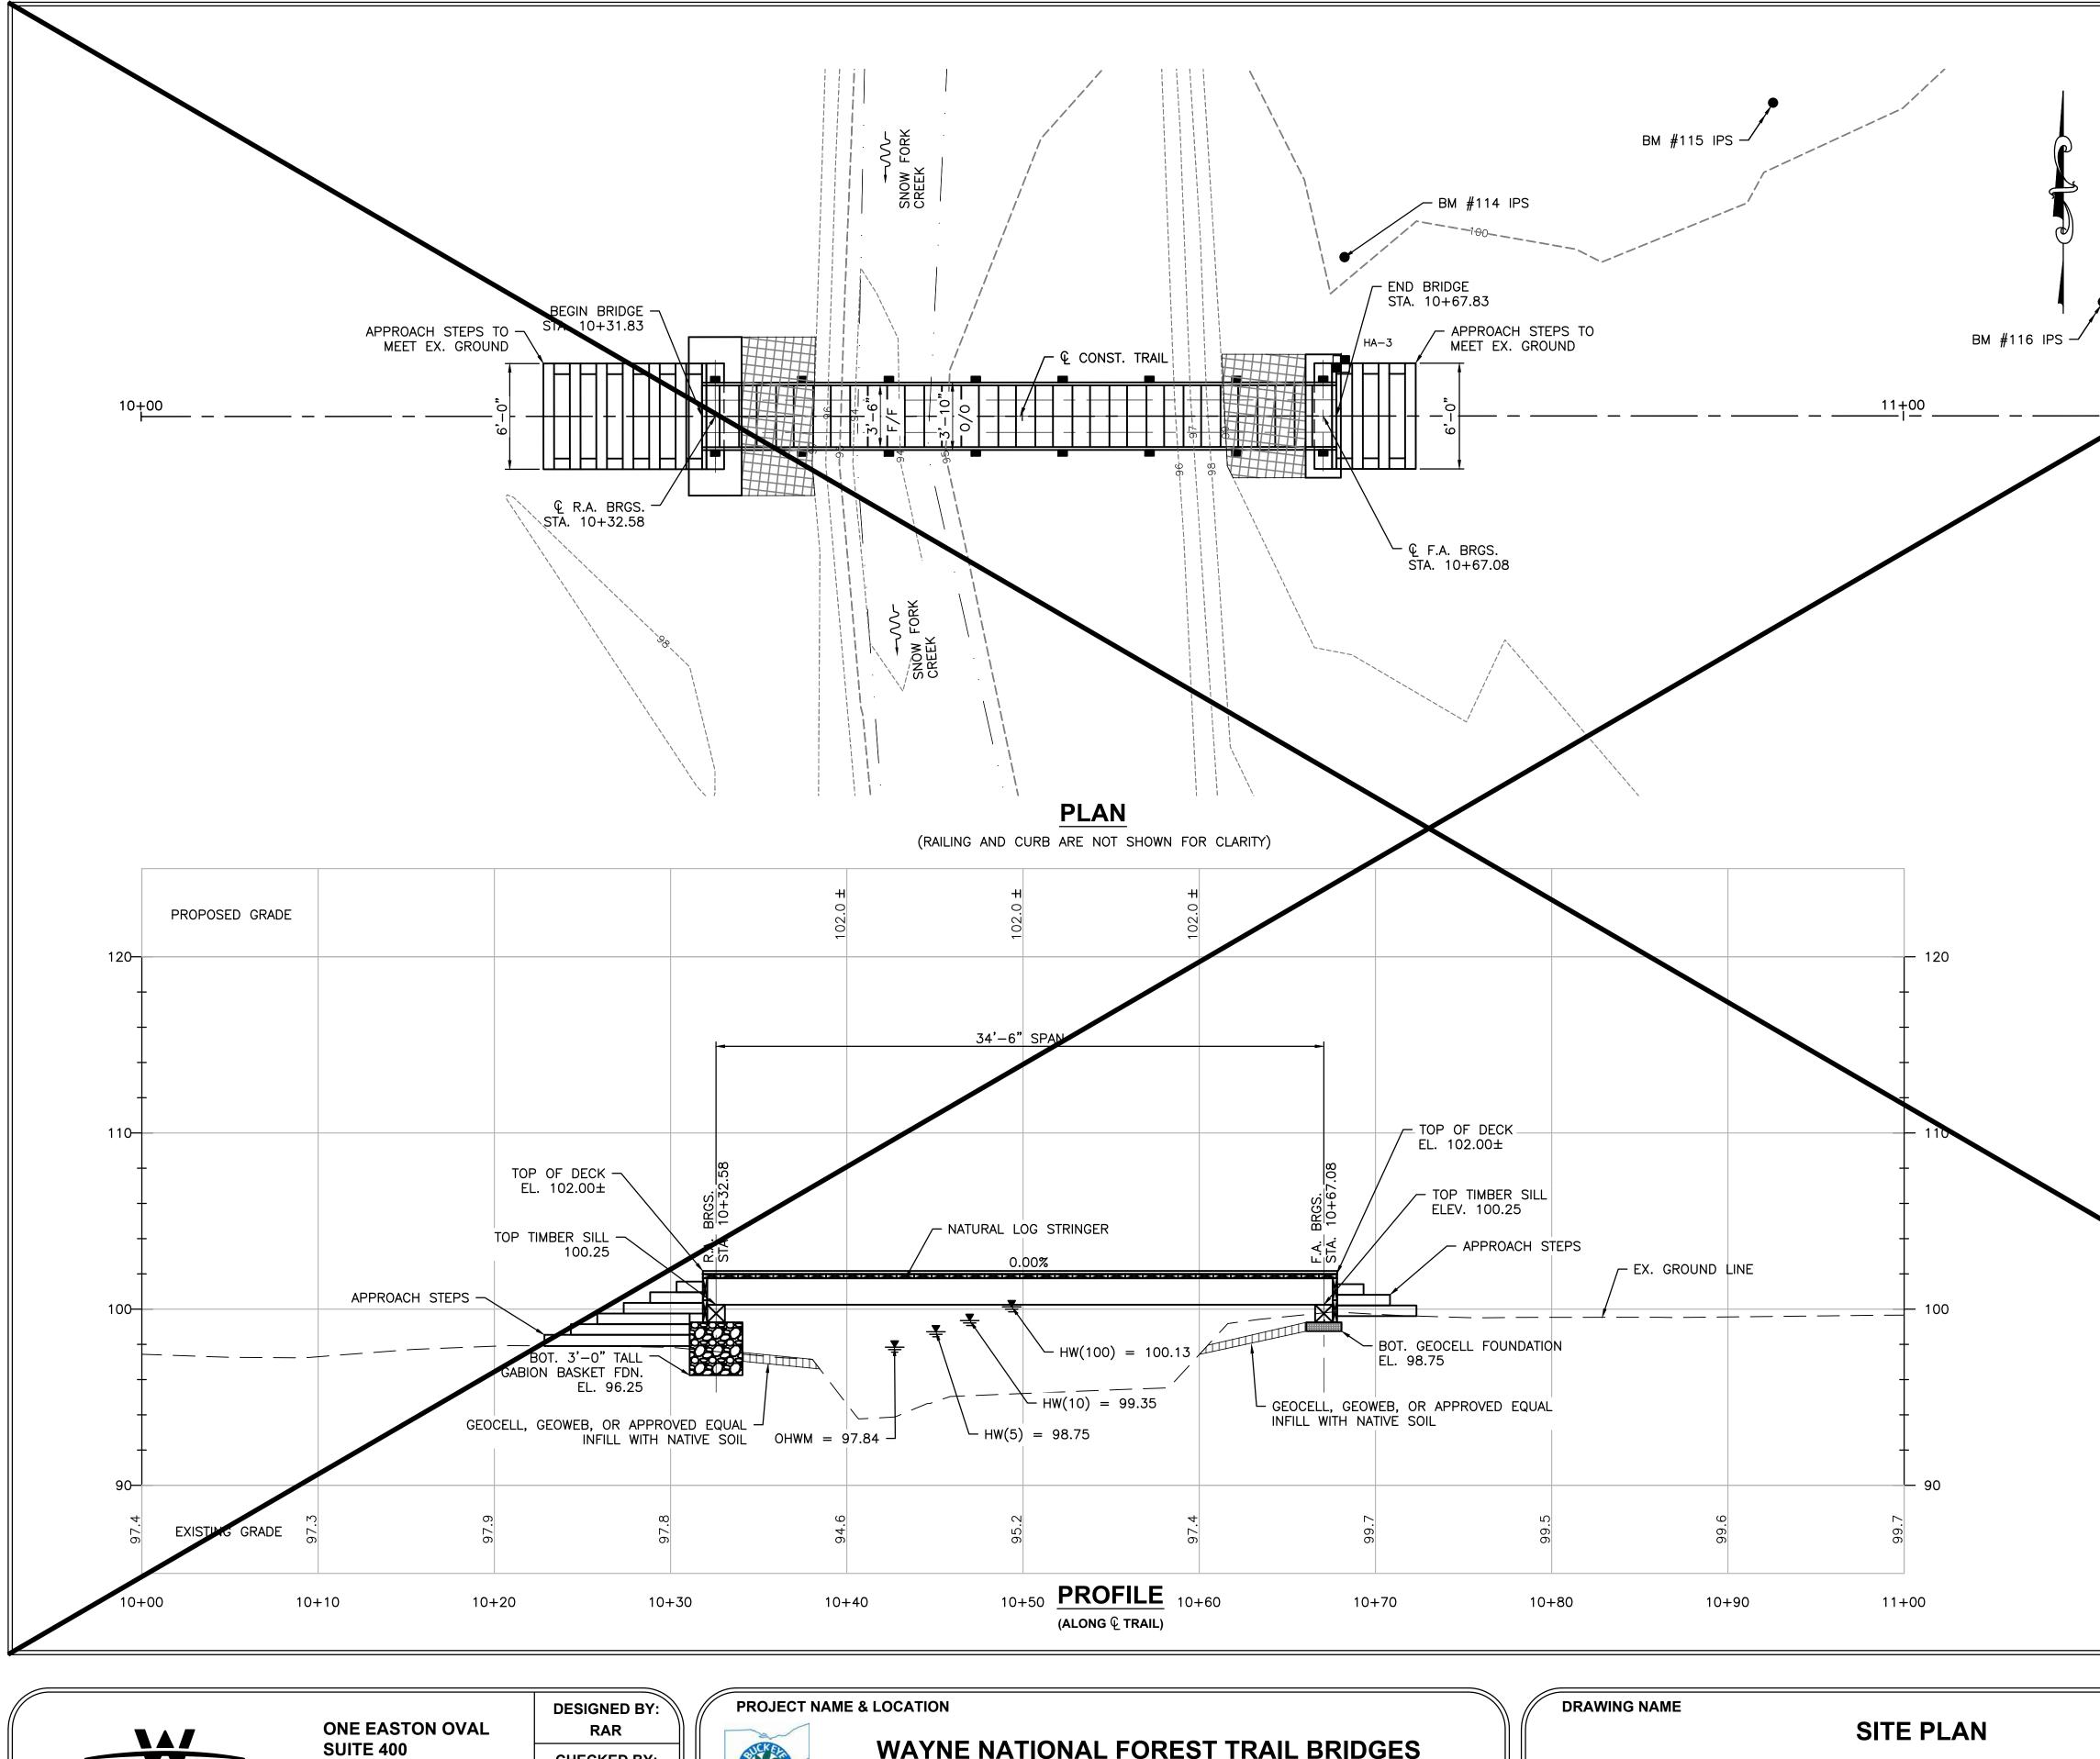

CHECKED BY:

MJZ

**REVIEWED BY:** 

TML

COLUMBUS, OH 43219


**WOOLPERT** T 614-476-6000 F 614-476-6225


BRIDGE


SITE PLAN


SITE A - NCT ATHENS CENTRAL #3 OVER SN

POINT. BM#114	DESCRIPTION	NORTHING	EASTING	ELEV.	STATION	OFFS
	IRON PIN	5000	5000	100	10+68.29	9.02
BM#115 BM#116	IRON PIN IRON PIN	5062.98 5019.435	5000 5068.29	99.47 100.71	10+75.63 11+29.44	71.57
B.A	BEGIN ALIGNMENT	4933.2298 4965.5832	4983.0782	SEE PROFILE	10+00.00 10+32.58	0' 0'
CL R.A. CL F.A.	POINT ALONG ALIGNMENT POINT ALONG ALIGNMENT	4965.5832 4999.848	4986.8758 4990.9377	SEE PROFILE	10+32.58 10+67.08	0'
E.A.		5082.2071	5000.5648		11+50.00	0'
JR ADDI	TIONAL BENCHMARK INFOR	RMATION, SEE	GENERAL NU	IES SHEET 3/	49.	
	EGEND BORING LOCATION					
	6" THICK GEOCELL / GEOCELL, GEOWEB,	ARMORING, FIL OR APPROVED	LED WITH NA	TIVE SOIL (99 L SHALL BE	4.04). INSTALLED	
-	IN ACCORDANCE WIT					
н	YDRAULIC DA	ТА				
	AINAGE AREA = $1.51$ SQ.		<b>3</b> 70 FT/S			
QQ	(5) = 324.00  CFS (10) = 449.00  CFS (25) = 634.00  CFS	v (0) = V (10) = V (25)	4.18 FT/S	SCOUP OUT	IGN	
Q Q	(10) = 449.00  CFS (25) = 634.00  CFS (100) = 960.00  CFS	v (25) = V (100)=	4.03 FI/S 5.13 FT/S	SCOUR CHE FEMA	UK.	
STI	RUCTURE CLEARS THE 10	0-YEAR HIGH	WATER ELEVA	ATION BY 0.12	2 FEET.	
ST	RUCTURE IS NOT LOCATE	D IN FEMA RE	GULATED ZON	E.		
		ROPOS	ED STR	UCTUR	E	
	TYPE: 2 NATU	$\overline{}$				
	TYPE: 2 NATU GEOCEL	RAL LOG, LOG L FOOTINGS	STRINGER TH			
	TYPE: 2 NATU	RAL LOG, LOG L FOOTINGS	STRINGER TH			
	TYPE: 2 NATU GEOCEL SPANS: 34'–6"	RAL LOG, LOG L FOOTINGS C/C TIMBER	STRINGER TH			
	TYPE: 2 NATU GEOCEL SPANS: 34'–6" ROADWAY: 3'–6"	RAL LOG, LOG L FOOTINGS C/C TIMBER F/F RAILING	STRINGER TH			
	TYPE: 2 NATU GEOCEL SPANS: 34'–6"	RAL LOG, LOG L FOOTINGS C/C TIMBER F/F RAILING	STRINGER TH			
	TYPE: 2 NATU GEOCEL SPANS: 34'-6" ROADWAY: 3'-6" LOADING: 0.090	RAL LOG, LOG L FOOTINGS C/C TIMBER F/F RAILING KSF PEDESTRI	STRINGER TH	RAIL BRIDGE (		
	TYPE: 2 NATU GEOCEL SPANS: 34'–6" ROADWAY: 3'–6"	RAL LOG, LOG L FOOTINGS C/C TIMBER F/F RAILING KSF PEDESTRI	STRINGER TH	RAIL BRIDGE (		
	TYPE: 2 NATU GEOCEL SPANS: 34'-6" ROADWAY: 3'-6" LOADING: 0.090	RAL LOG, LOG L FOOTINGS C/C TIMBER F/F RAILING KSF PEDESTRI	STRINGER TH	RAIL BRIDGE (		
	TYPE: 2 NATU GEOCEL SPANS: 34'-6" ROADWAY: 3'-6" LOADING: 0.090	RAL LOG, LOG L FOOTINGS C/C TIMBER F/F RAILING KSF PEDESTRI	STRINGER TH SILL IAN 39° 33' 42.12 82° 12' 21.96	RAIL BRIDGE (		
	TYPE: 2 NATU GEOCEL SPANS: 34'-6" ROADWAY: 3'-6" LOADING: 0.090	RAL LOG, LOG L FOOTINGS C/C TIMBER F/F RAILING KSF PEDESTRI TITUDE S NGITUDE 8 REVISION D	STRINGER TH SILL IAN 39° 33' 42.12 82° 12' 21.96	RAIL BRIDGE ( 2" N 5" W SU	ON STUB	8
	TYPE: 2 NATU GEOCEL SPANS: 34'-6" ROADWAY: 3'-6" LOADING: 0.090	RAL LOG, LOG L FOOTINGS C/C TIMBER F/F RAILING KSF PEDESTRI TITUDE S NGITUDE 8	STRINGER TH SILL IAN 39° 33' 42.12 82° 12' 21.96	RAIL BRIDGE ( 2" N 5" W SU	DN STUB	8
	TYPE: 2 NATU GEOCEL SPANS: 34'-6" ROADWAY: 3'-6" LOADING: 0.090	RAL LOG, LOG L FOOTINGS C/C TIMBER F/F RAILING KSF PEDESTRI TITUDE S NGITUDE 8 REVISION D	STRINGER TH SILL IAN 39° 33' 42.12 82° 12' 21.96	RAIL BRIDGE (	DN STUB	8

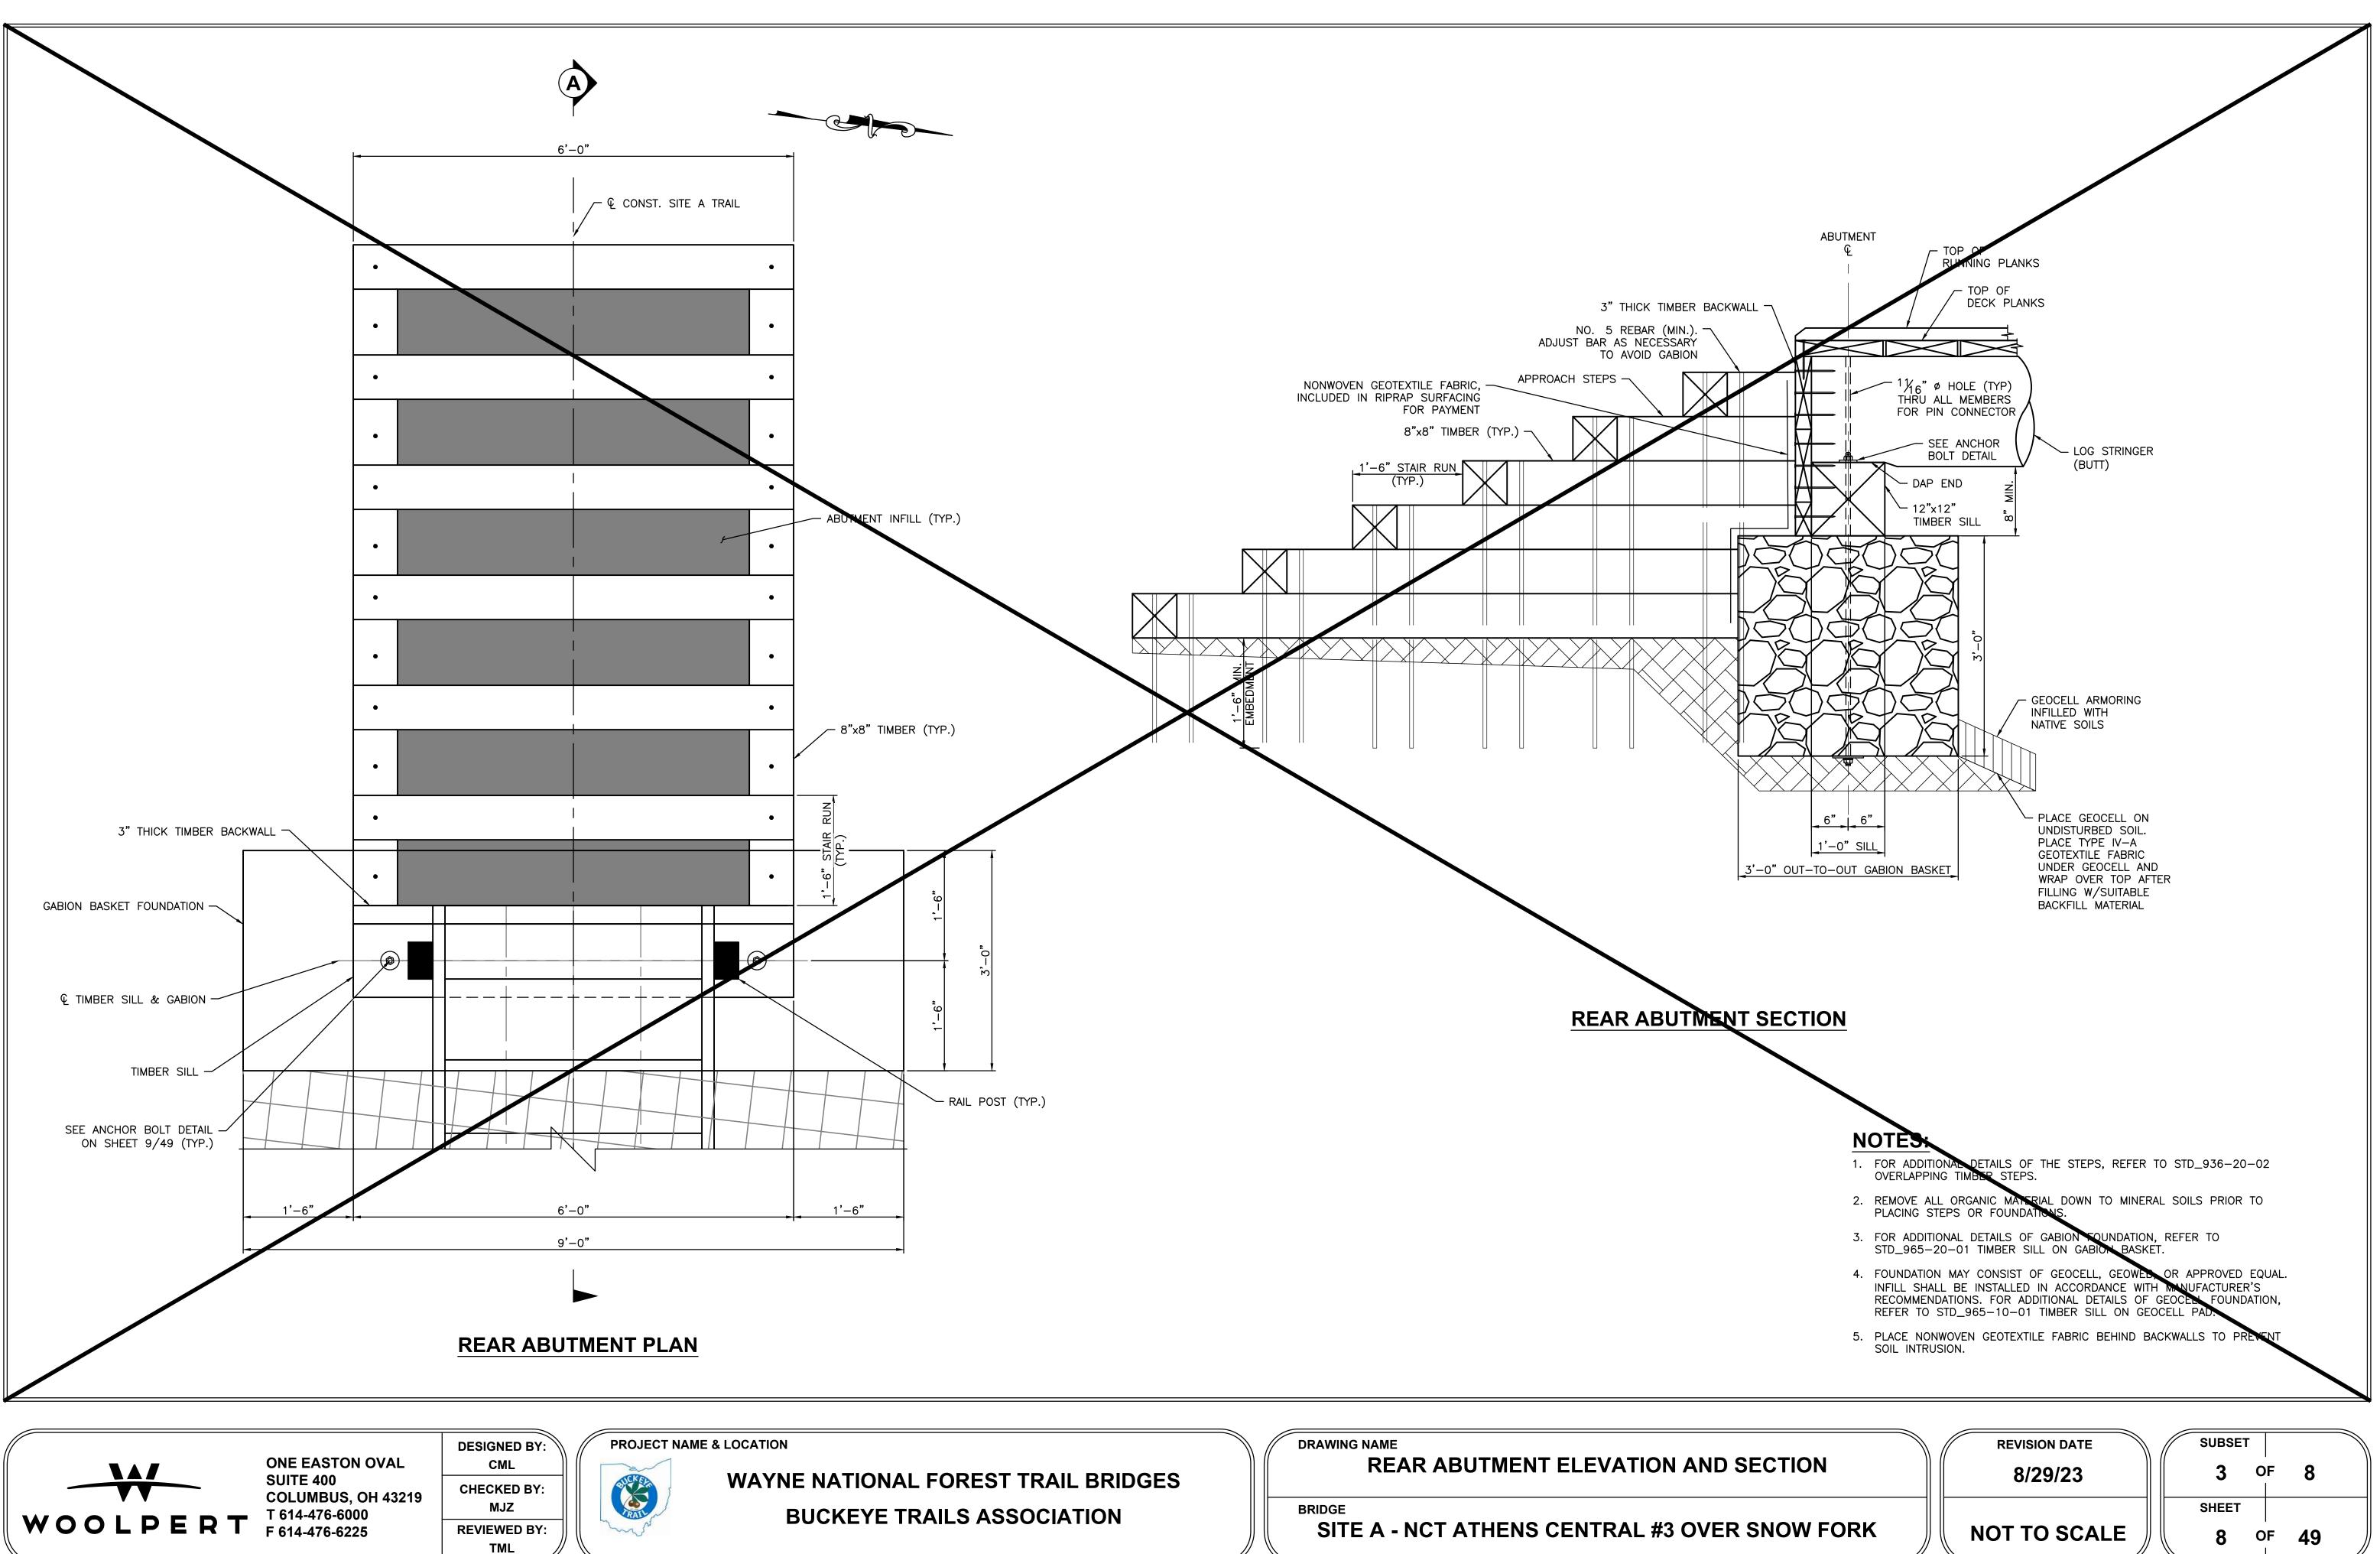


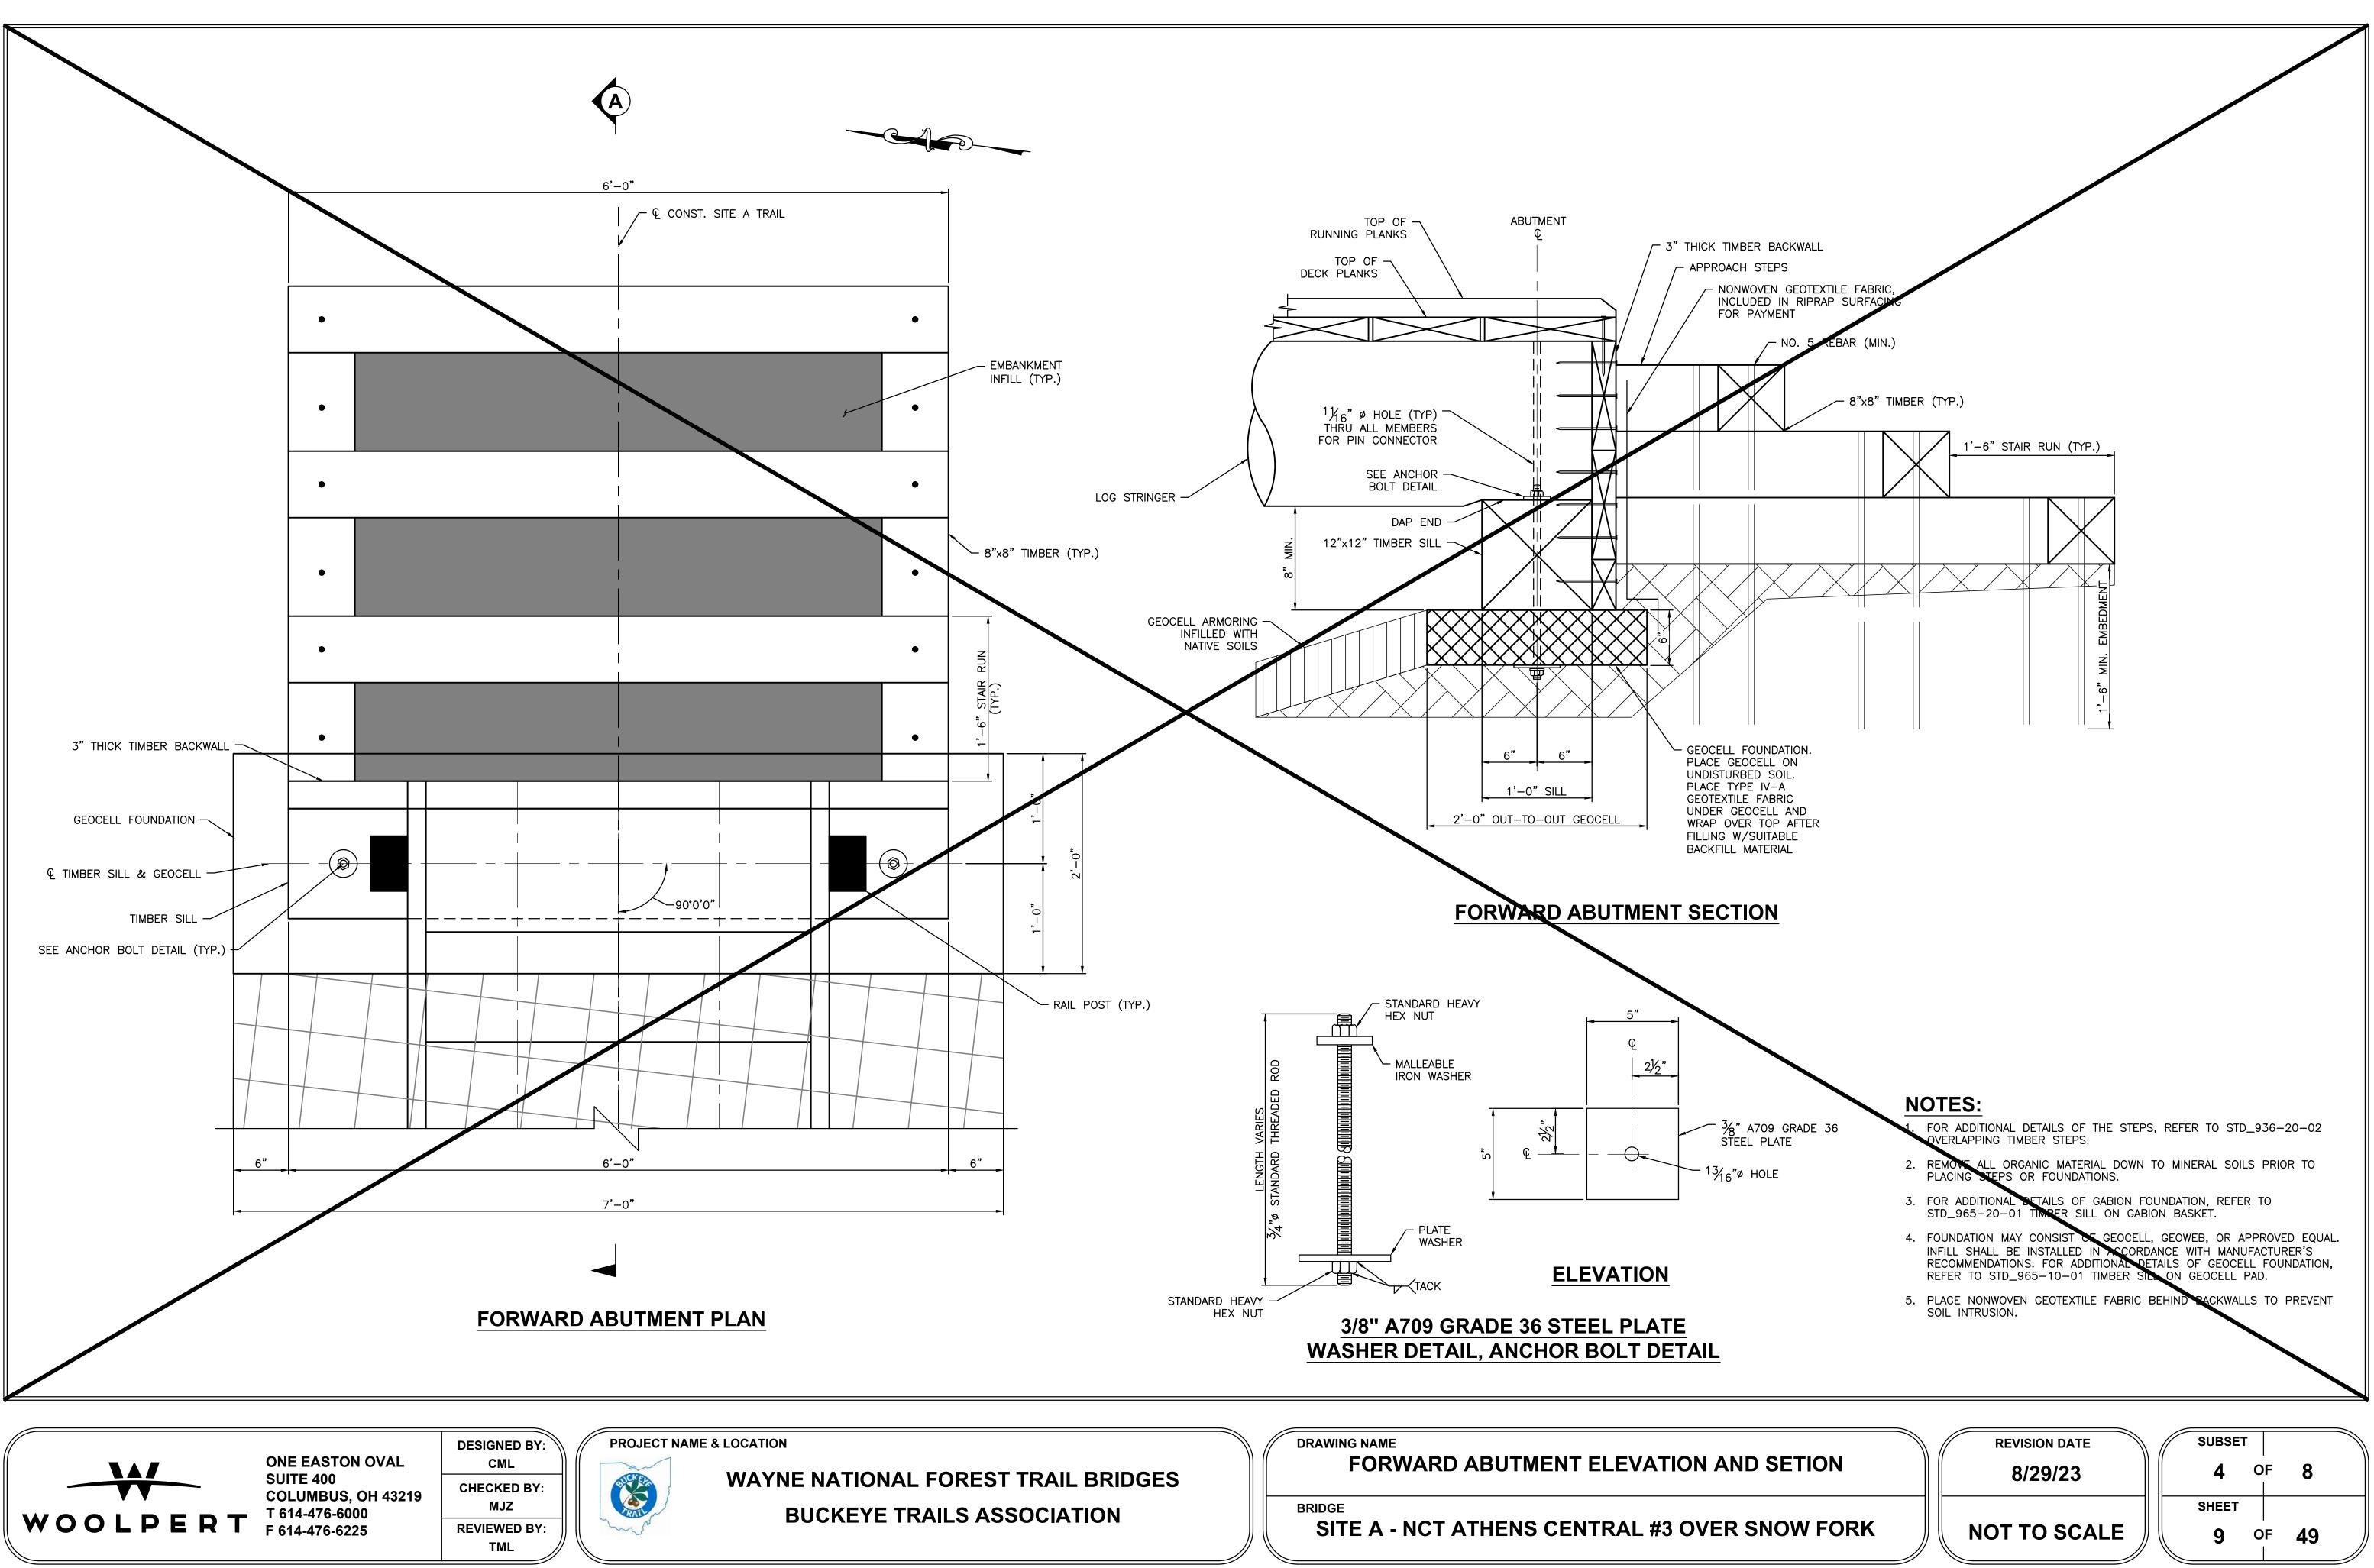


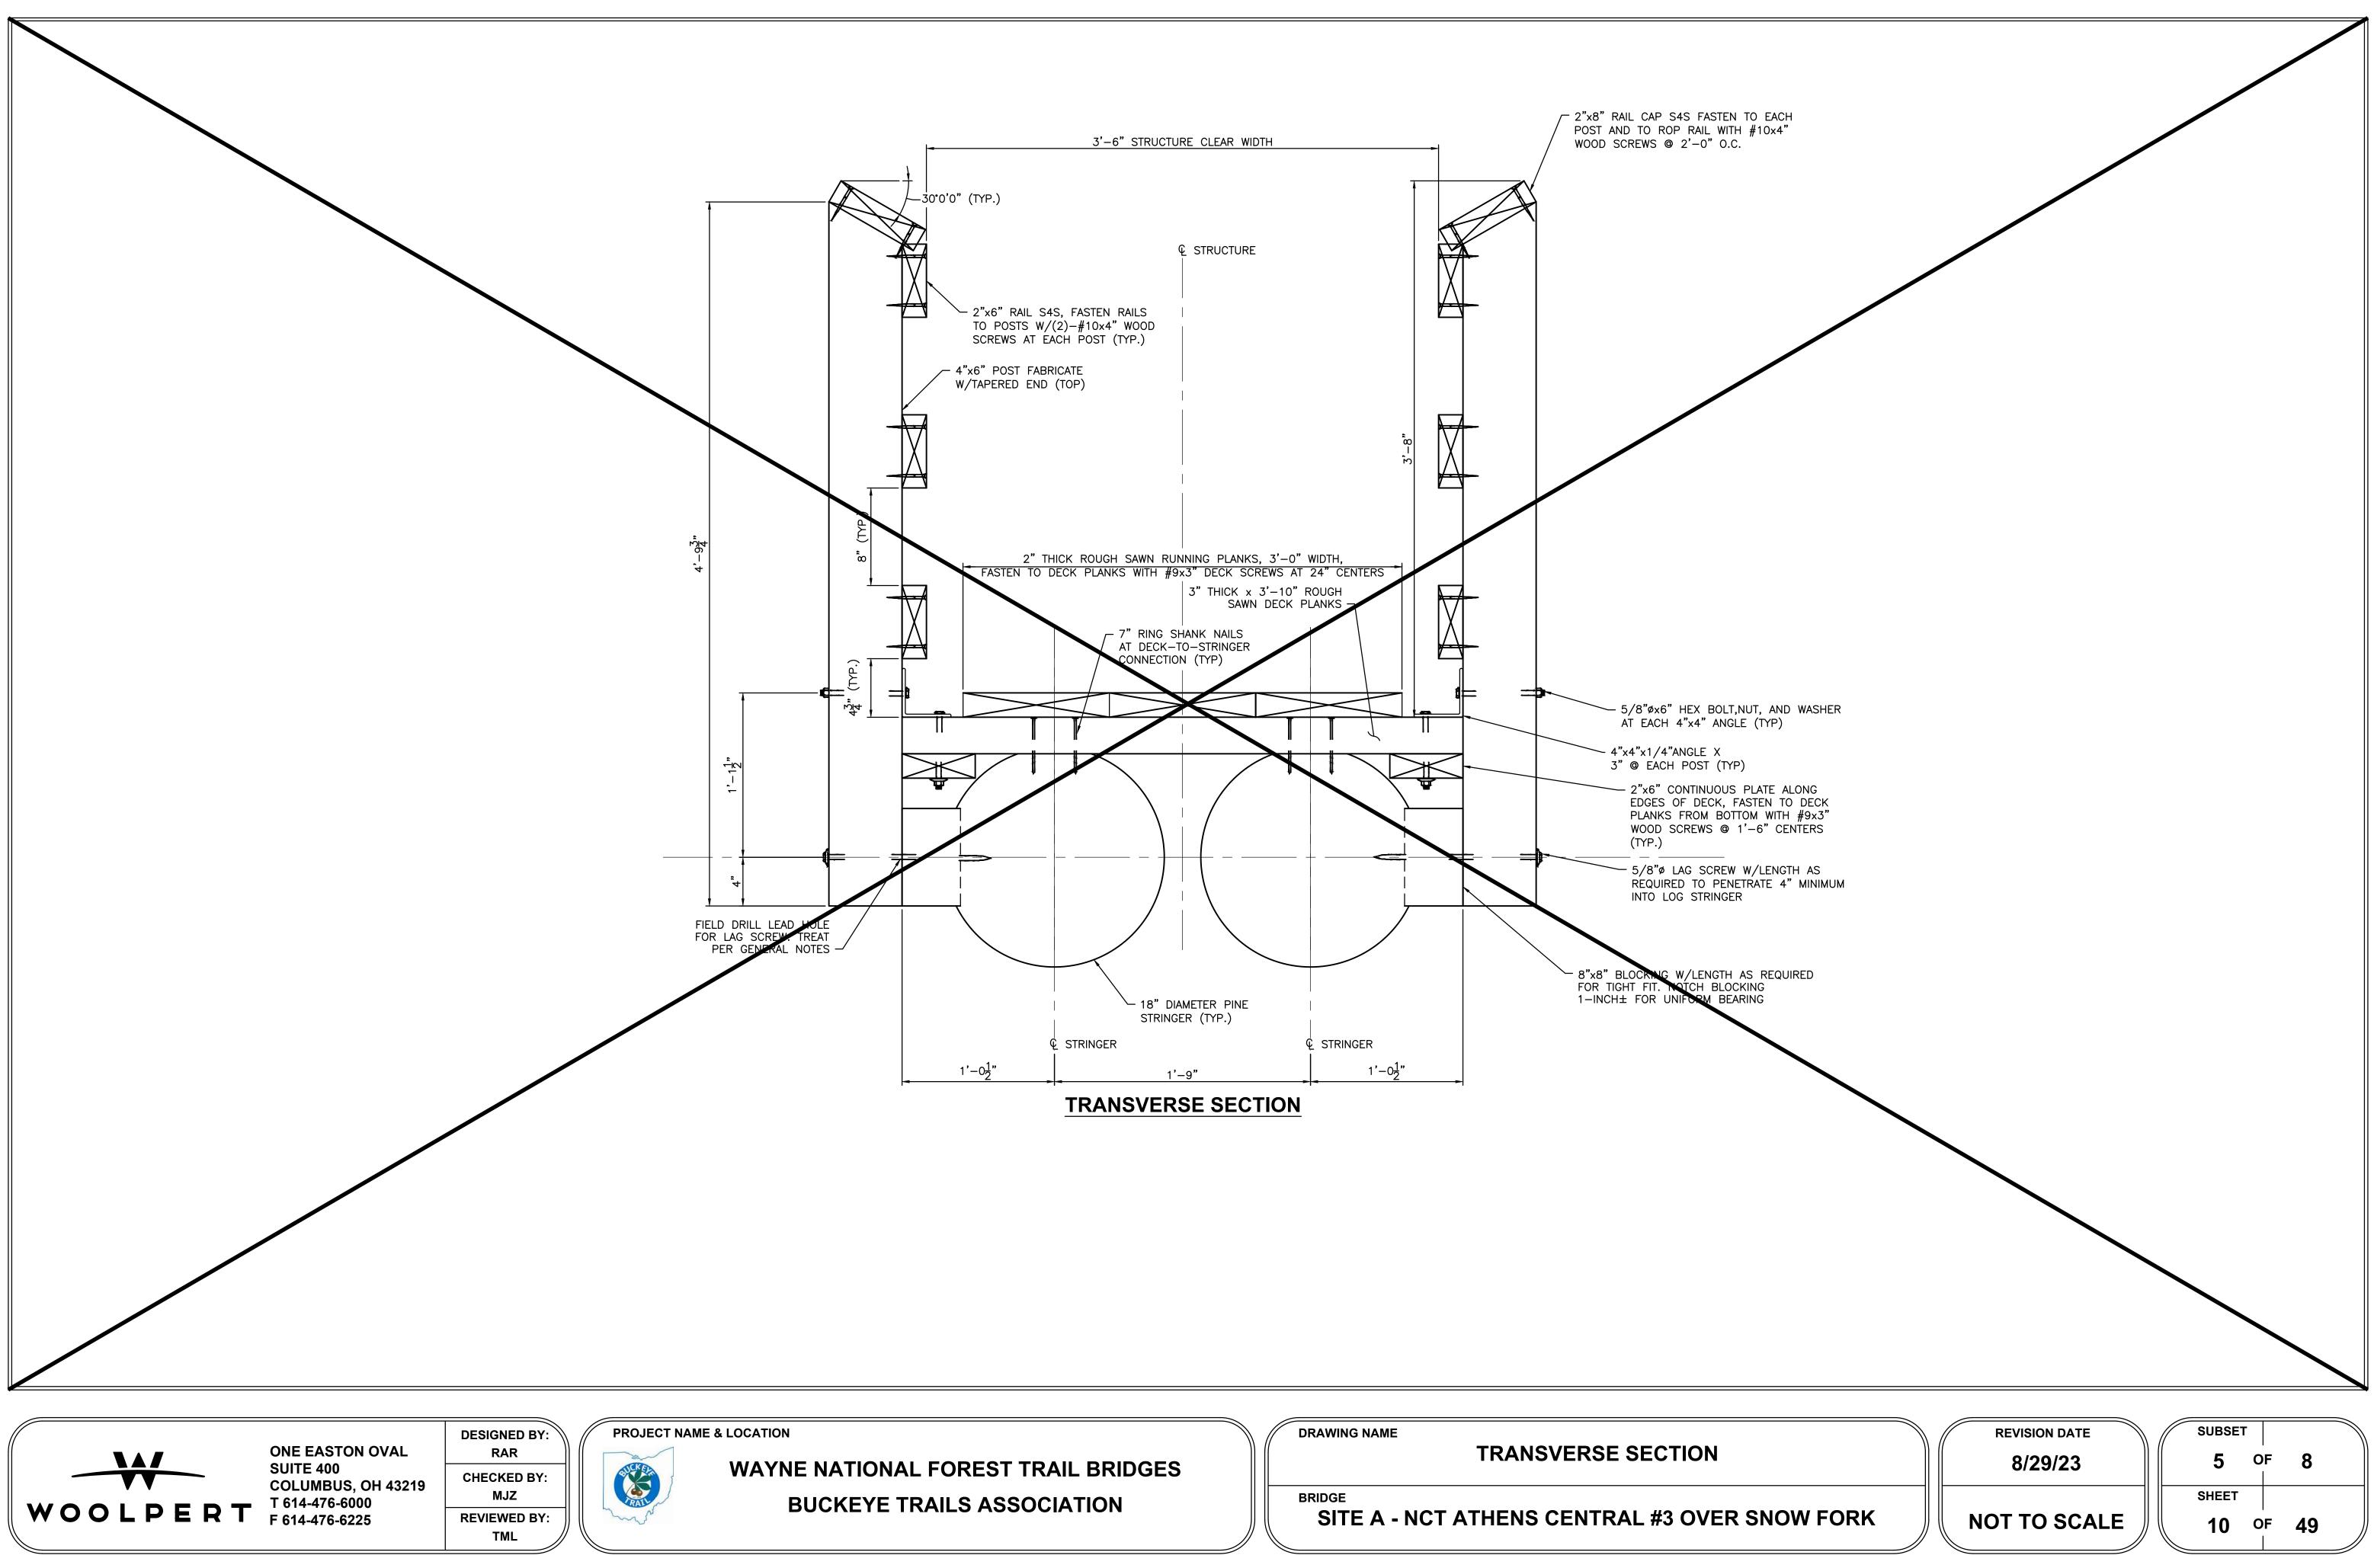

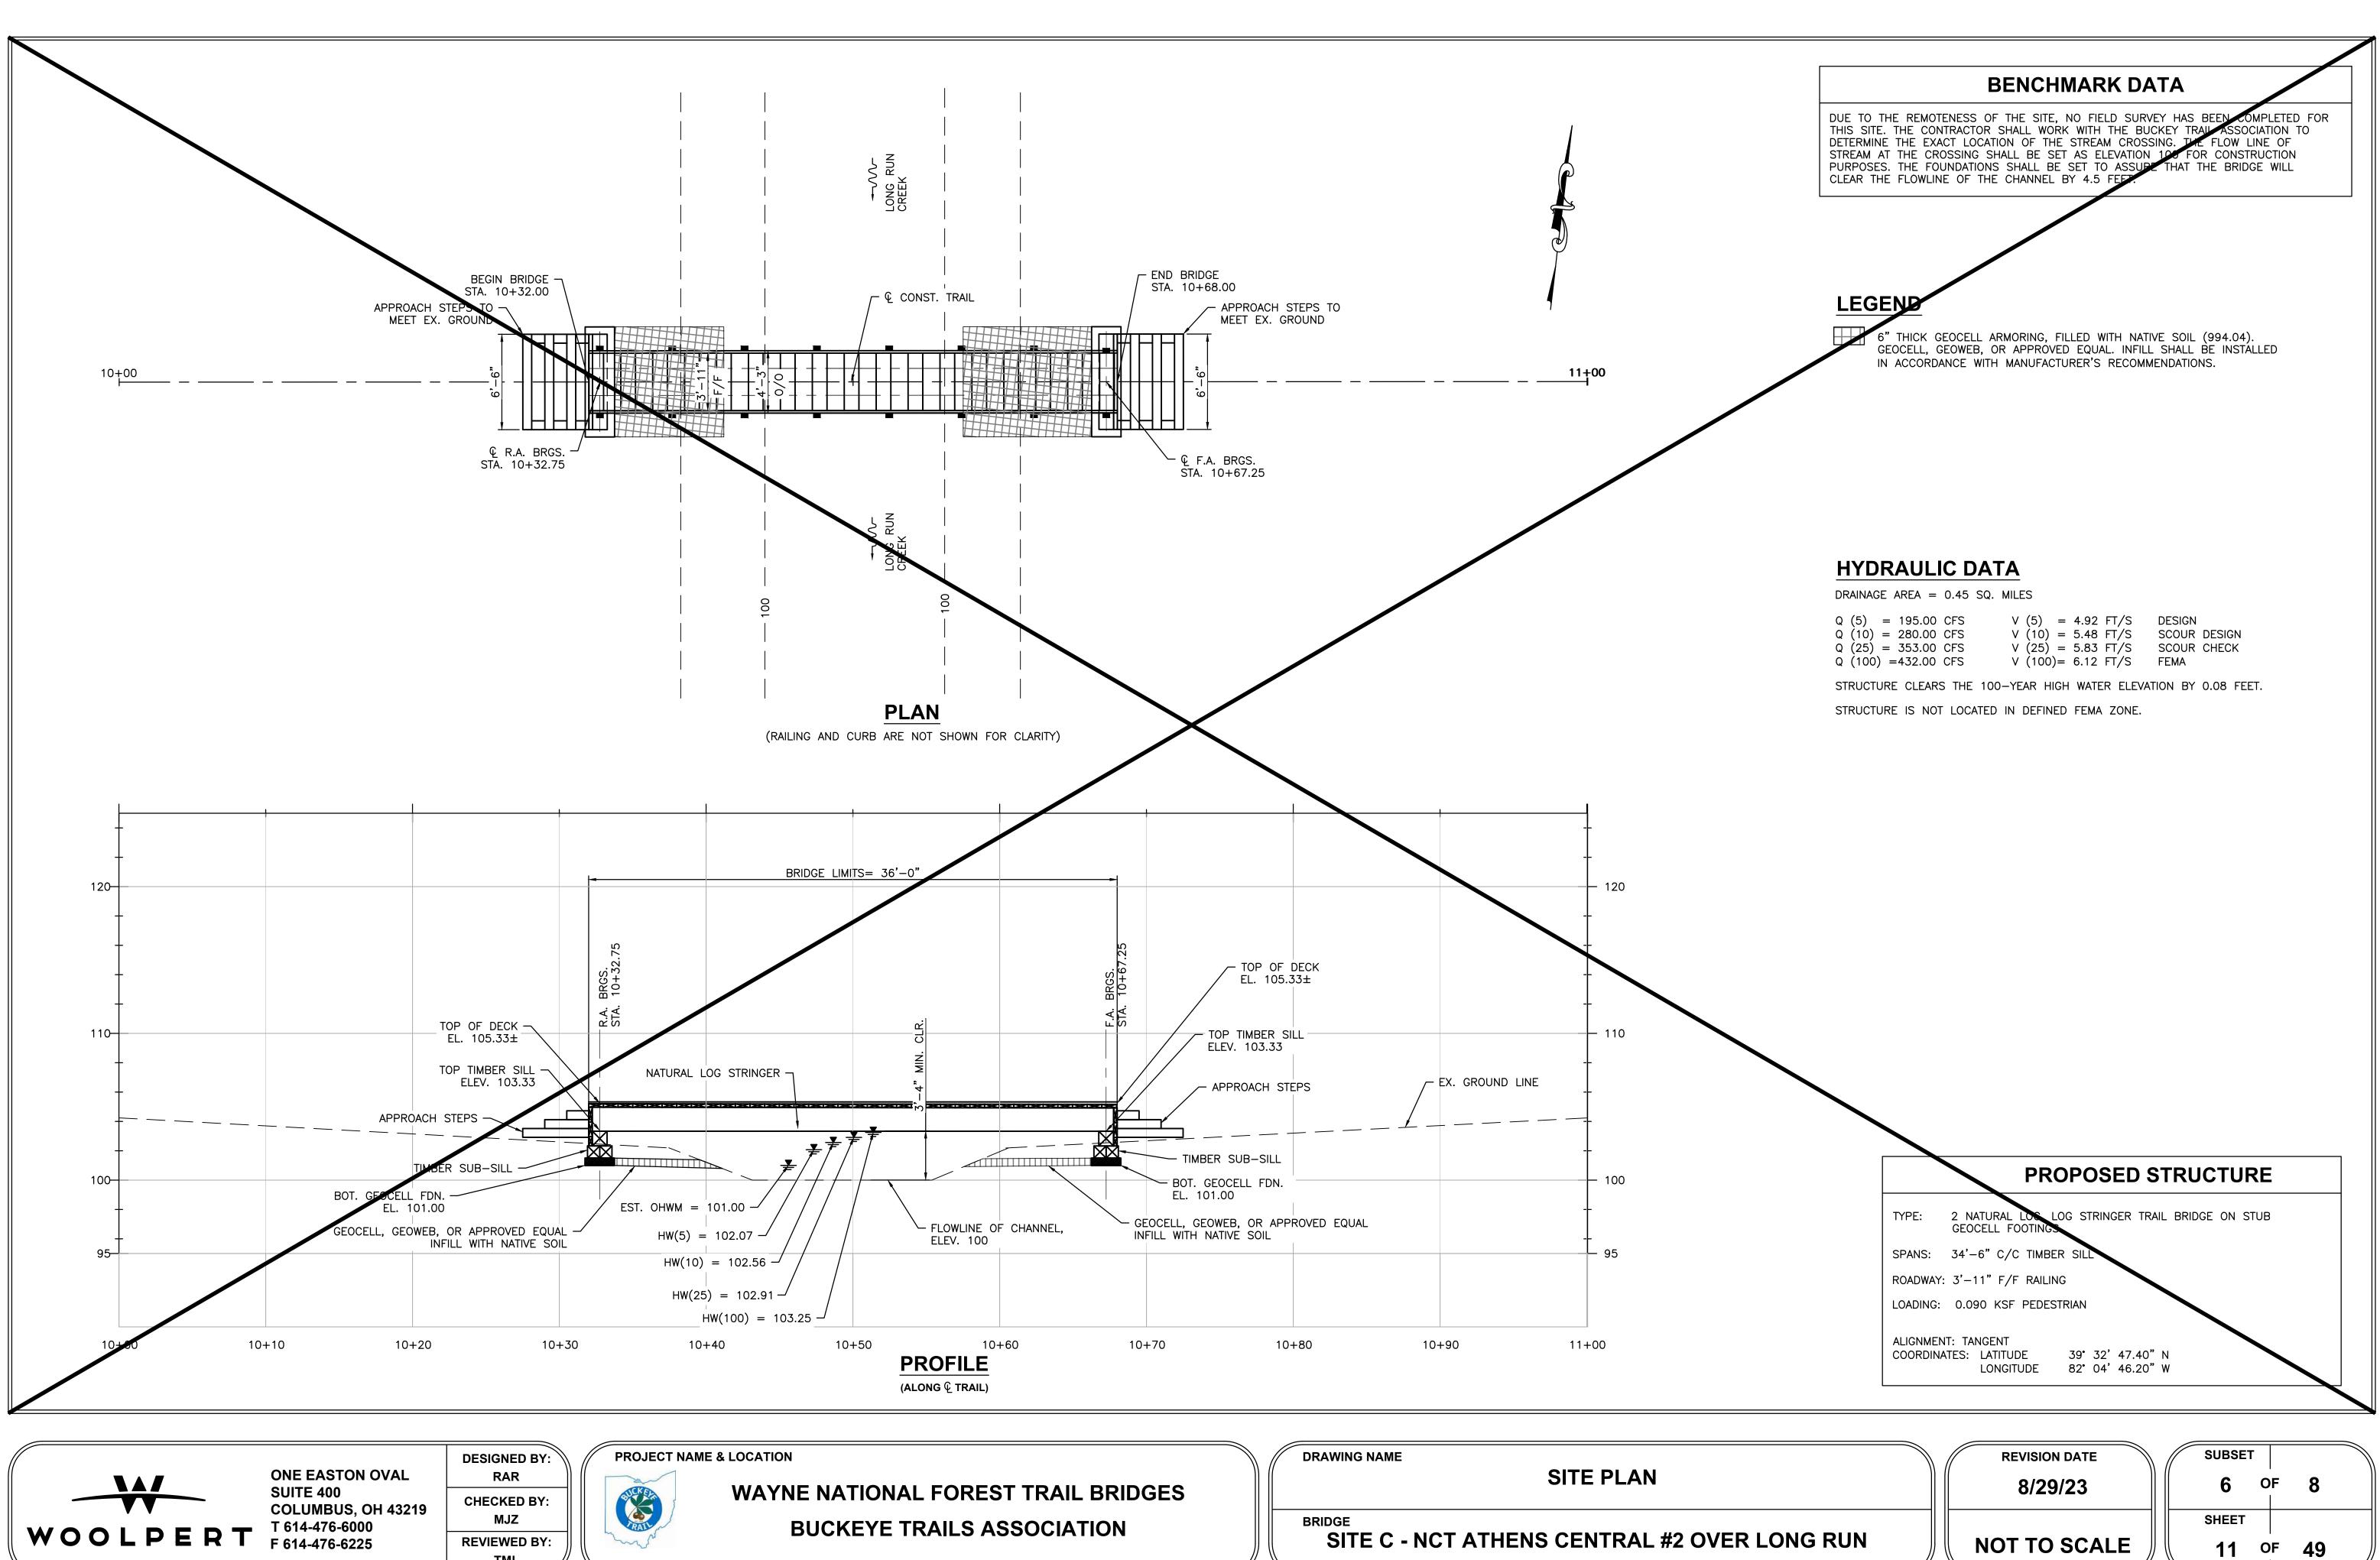

TML

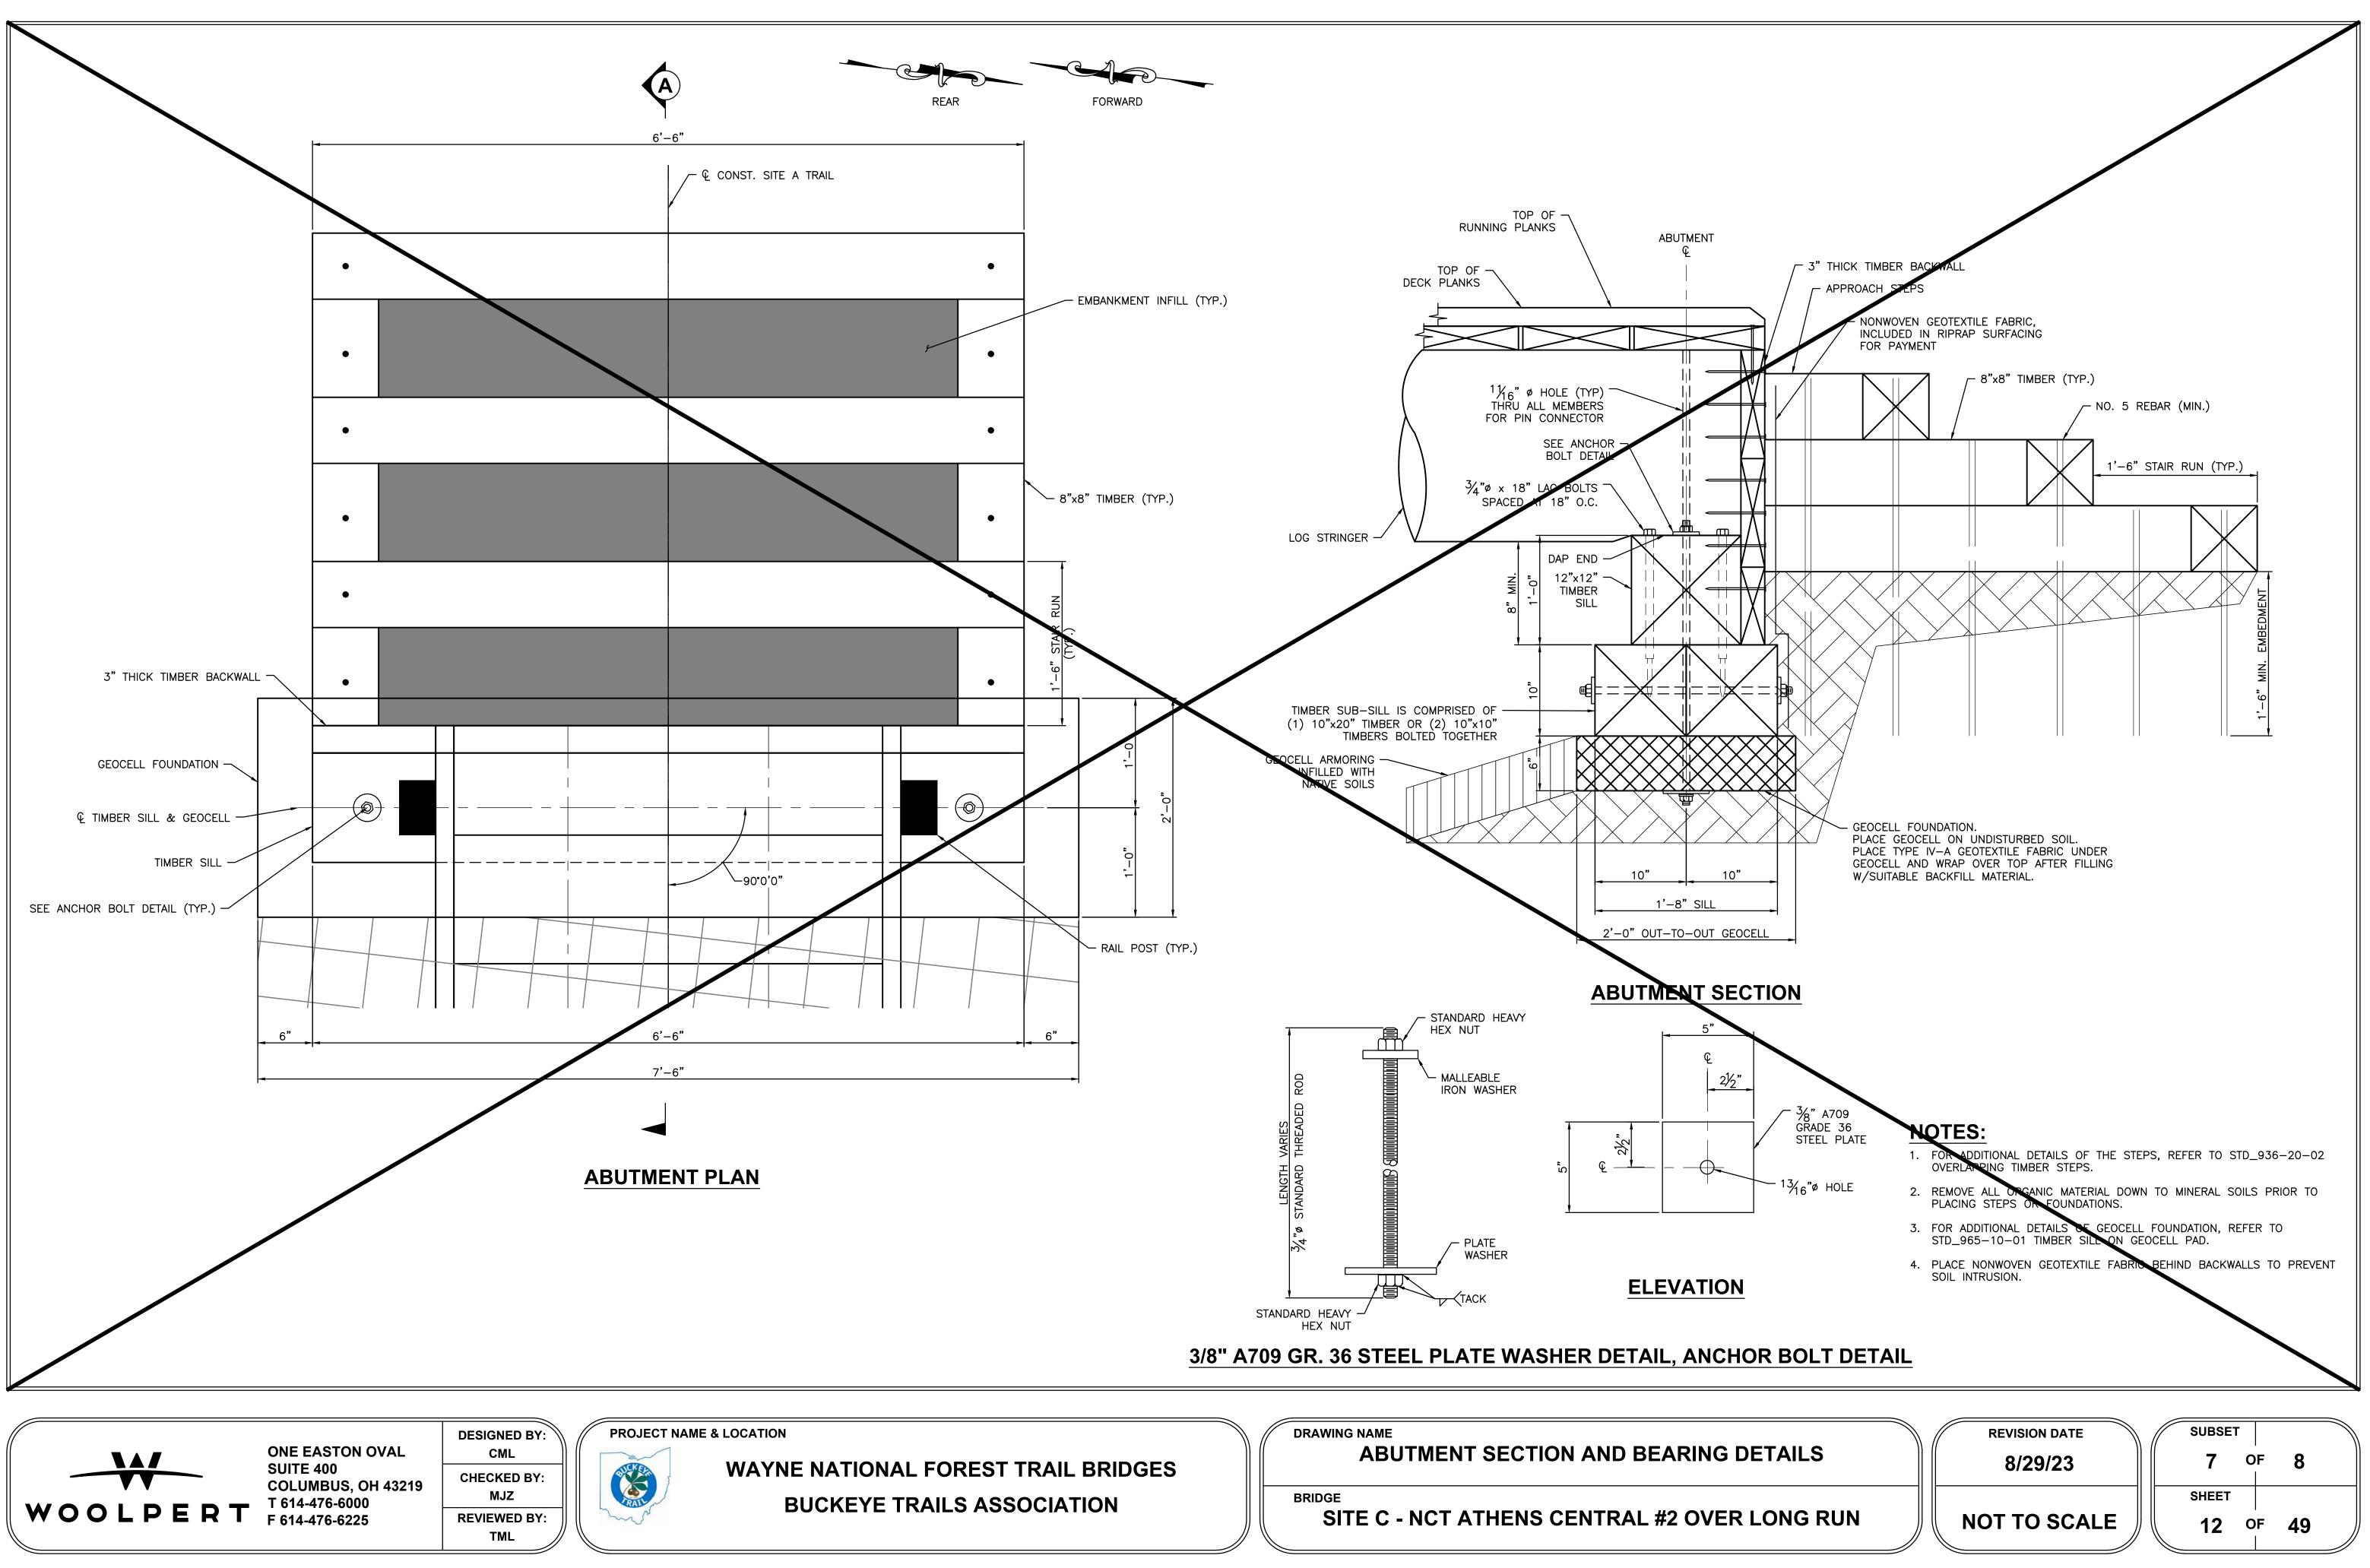

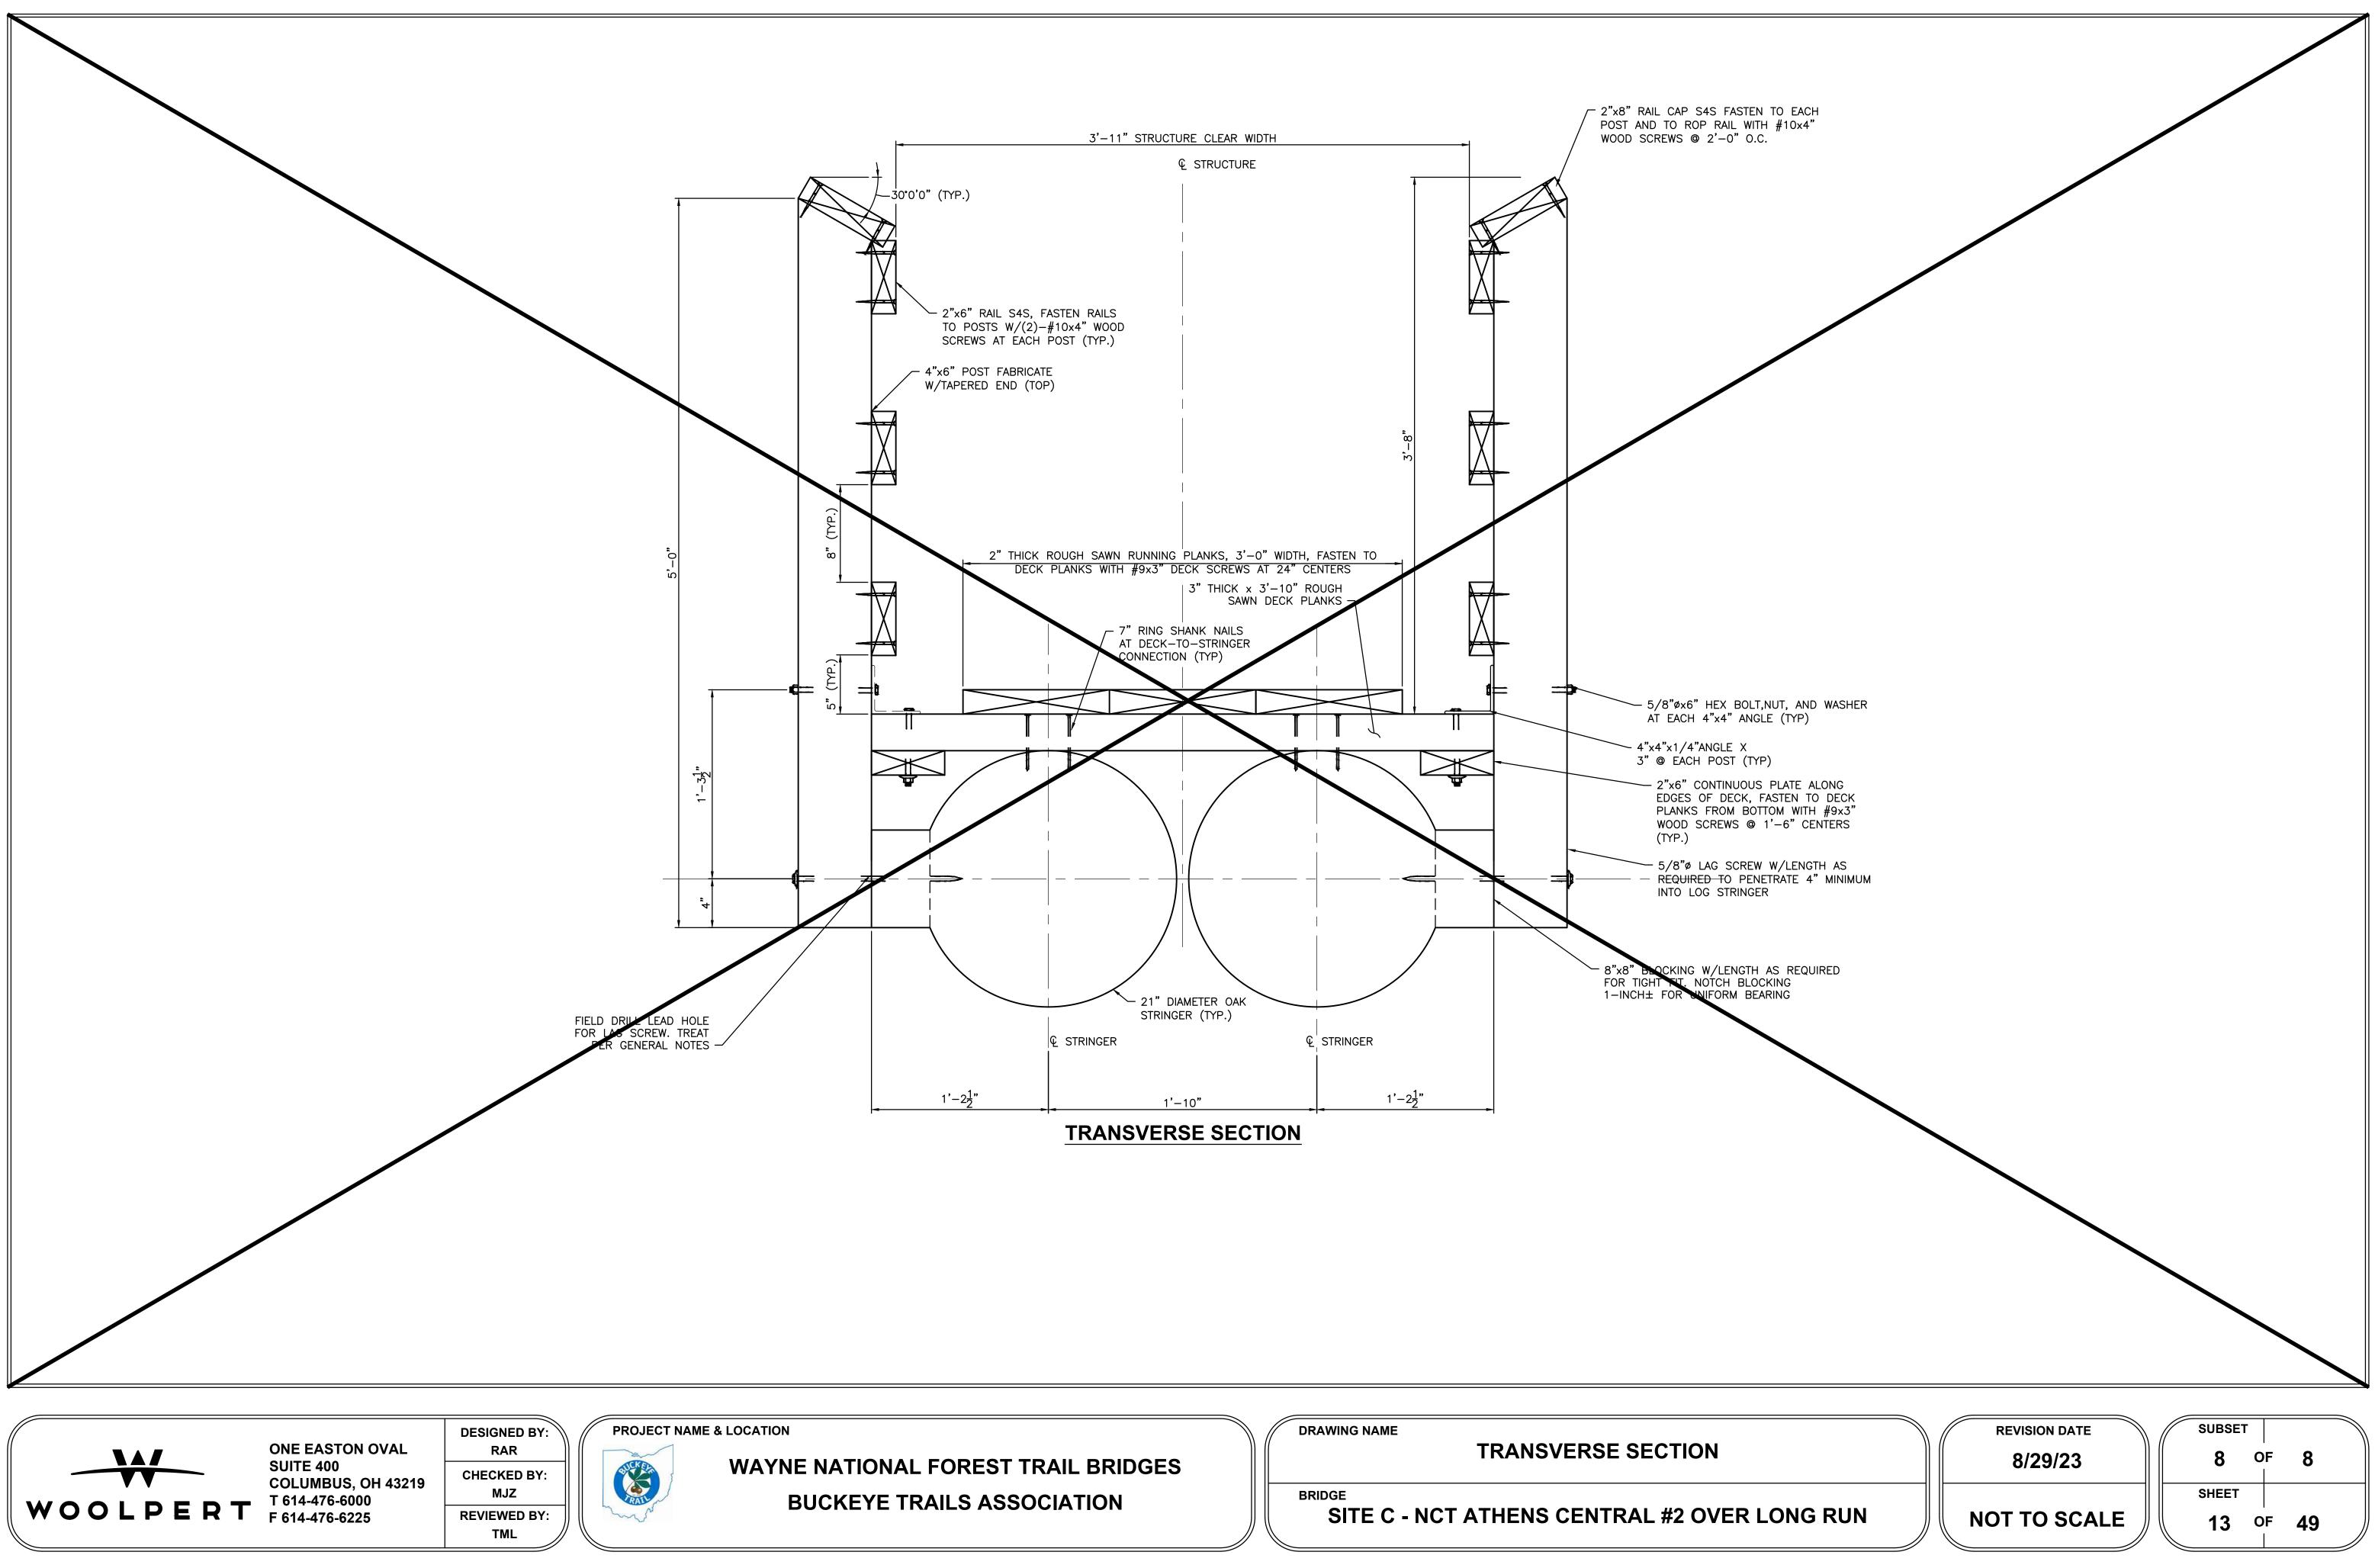

#### **DESIGN SPECIFICATIONS:**

THIS STRUCTURE SHALL CONFORM TO THE FOLLOWING SPACIFICATIONS:

- THE 2009 AASHTO GUIDE SPECIFICATIONS FOR THE DESIGN OF PEDESTRIAN BRIDGE INCLUDING THE 2015 INTERIMS
  THE 2020 AASHTO LRFD BRIDGE DESIGN SPECIFICATION, 9TH EDITION
  THE 2014 FSH 7709.56b- TRANSPORTATION STRUCTURES HANDBOOK, CHAPTER 80 TRAIL BRIDGE DESIGN
- THE 2014 FSH 7709.30D- TRANSPORTATION STRUCTURES HANDBOOK, CHAPTER 80 TRAIL BRIDGE DESIGN - THE 2018 NATIONAL DESIGN SPECIFICATION FOR WOOD CONSTRUCTION

MATERIALS AND CONSTRUCTION OF THIS STRUCTURE SHALL BE IN ACCORDANCE WITH THE STANDARD SPECIFICATION FOR CONSTRUCTION OF TRAILS AND TRAIL BRIDGES ON FOREST SERVICE PROJECTS DATED 10-30-2014, AND APPLICABLE SECTIONS AS REFERENCED HEREIN OF THE STANDARD SPECIFICATIONS FOR CONSTRUCTION OF ROADS AND BRIDGES ON FEDERAL HIGHWAY PROJECTS FP-03 BY THE U.S. DEPARTMENT OF TRANSPORTATION FEDERAL HIGHWAY ADMINISTRATION.

#### **DESIGN LOADING:**

PEDESTRIAN LOADING: 0.090 KSF EQUESTRIAN LOADING: 1,000 LBS ON A FOUR INCH SQUARE (SITE H ONLY)

#### **DESIGN STRESSES:**

CONCRETE CLASS A - COMPRESSIVE STRENGTH 4.0 KSI (ABUTMENT)

CONCRETE CLASS A, WITH  $\frac{3}{4}$ " MAX. AGGREGATE SIZE - COMPRESSIVE STRENGTH 4.5 KSI (DRILLED SHAFTS)

CONCRETE REINFORCING: REINFORCING STEEL – MINIMUM YIELD STRENGTH 60 KSI TIMBER BEAMS: SITE E: BENDING, Fb' = 3,386 PSI SHEAR, Fv' = 410 PSI MODULUS OF ELASTICITY, E' = 1,416,100 PSI SITE H: BENDING, Fb' = 3,542 PSI SHEAR, Fv' = 410 PSI MODULUS OF ELASTICITY, E' = 1,416,100 PSI SITE I: BENDING, FB' = 3,967 PSI SHEAR, FV' = 410 PSI MODULUS OF ELASTICITY, E' = 1,416,100 PSI

#### TIMBER AND LUMBER:

SOLID SAWN TIMBER MEMBERS SHALL CONFORM TO THE REQUIREMENTS OF THE GRADING RULES AGENCY FOR THE SPECIES, TYPE, AND GRADE SPECIFIED BELOW. GLULAM MEMBERS SHALL CONFORM TO THE AMERICAN NATIONAL STANDARD, STANDARD SPECIFICATIONS FOR STRUCTURAL GLUED LAMINATED TIMBER OF SOFTWOOD SPECIES (ANSI 117) FOR THE COMBINATION, SPECIES, USE, AND APPEARANCE SPECIFIED BELOW.

- GLULAM BEAMS AND DIAPHRAGMS
- COMBINATION SYMBOL 24F-V3, SPECIES SP/SP, WET USE, TREATED, INDUSTRIAL APPEARANCE DECK PLANKS, SILLS, AND BACKING PLANKS
- SOUTHERN PINE ROUGH SAWN NO. 1 GRADE, TREATED, GRADING RULES AGENCY WWPA, WCLIB
- <u>RUNNING PLANKS</u> - SOUTHERN PINE ROUGH SAWN NO. 1 GRADE, TREATED, GRADING RULES AGENCY - WWPA, WCLIB
- RAILS & POSTS - WESTERN RED CEDAR, S4S, SELECT STRUCTURAL GRADE GRADING RULES AGENCY - WWPA, WCLIB
- HEM FIR/DOUGLAS FIR, S4S, NO. 1 GRADE, TREATED, GRADING RULES AGENCY WWPA, WCLIB
- SOUTHERN PINE ROUGH SAWN NO. 1 GRADE, TREATED, GRADING RULES AGENCY WWPA, WCLIB
  SOUTHERN PINE, S4S, NO. 2 GRADE, GRADING RULES AGENCY SPIB

#### **TREATMENT:**

PRESERVATIVE TREATMENT SHALL BE IN ACCORDANCE WITH THE CURRENT AMERICAN WOOD PROTECTION ASSOCIATION (AWPA) SPECIFICATIONS USING THE TREATMENT MATERIALS LISTED BELOW. TREATMENT WILL COMPLY WITH THE REQUIREMENTS OF THE CURRENT EDITION OF WESTERN WOOD PRESERVERS INSTITUTE (WWPI) "BEST MANAGEMENT PRACTICES FOR THE USE OF TREATED WOOD IN AQUATIC ENVIRONMENTS".

- DECKING, RUNNING PLANKS, & RAILING SYSTEM
- AWPA USE CATEGORY SYSTEM (U1) FOR USE CATEGORY 4C GROUND CONTACT EXTREME DUTY (UC4C), TYPE CuN, MCA, OR OTHER WATERBORNE PRESERVATIVE
- BEAMS, DIAPHRAGMS, SILLS, BACKING PLANKS, CRIBS, & TIMBER WALLS
- AWPA USE CATEGORY SYSTEM (U1) FOR USE CATEGORY 4C GROUND CONTACT EXTREME DUTY (UC4C) CuN

#### FIELD TREATMENT:

COPPER NAPHTHENATE (2% SOLUTION) SHALL BE FURNISHED FOR FIELD TREATING OF WOOD. ALL ABRASIONS AND FIELD CUTS – APPROVED BY THE C.O.R. – SHALL BE CAREFULLY TRIMMED AND GIVEN THREE BRUSH COATS OF THE FIELD TREATMENT SOLUTION. WHERE APPROVED, FIELD DRILLING OF BOLT, SCREW OR NAIL HOLES IS REQUIRED. THE HOLES SHALL BE FILLED WITH PRESERVATIVE PRIOR TO INSERTING THE FASTENERS.

#### HARDWARE AND STRUCTURAL STEEL:

GALVANIZED HARDWARE SHALL MEET THE REQUIREMENTS OF AASHTO M270, GRADE 36, WITH NUTS AND BOLTS CONFORMING TO ASTM A307, GRADE A. USE GALVANIZED ASTM F436 WASHERS AGAINST WOOD UNLESS OTHERWISE NOTED.


WHEN STRUCTURAL STEEL IS TO BE WELDED, THE WELDING PROCEDURE SHALL BE IN ACCORDANCE WITH AWS D1.1 AND SHALL BE SUITABLE FOR THE GRADE OF STEEL AND INTENDED USE OR SERVICE.



ONE EASTON OVAL SUITE 400 COLUMBUS, OH 43219 T 614-476-6000 F 614-476-6225 DESIGNED BY: \\ TML

CHECKED BY: CML REVIEWED BY: MJZ **PROJECT NAME & LOCATION** 

UCK EA

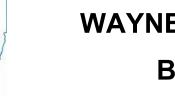

#### **FABRICATION:**

SUBMIT SHOP DRAWINGS FOR ALL MANUFACTURED BRIDGE COMPONENTS (EXCEPT TIMBER RUNNING PLANKS). SHOW ALL DIMENSIONS AND FABRICATION DETAILS FOR ALL CUT OR BORED TIMBER. REFER TO SPECIFICATIONS SECTIONS 963.00.02 AND 995.05.

#### FOUNDATION BEARING RESISTANCE:

SITE H:

- ABUTMENT FOUNDATIONS, AS DESIGNED, PRODUCE A MAXIMUM STRENGTH LIMIT STATE BEARING PRESSURE OF 1.45 KIPS PER SQUARE FOOT. THE FACTORED DESIGN BEARING RESISTANCE IS 2.00 KIPS PER SQUARE FOOT.
- SITE I:
- ABUTMENT FOUNDATIONS, AS DESIGNED, PRODUCE A MAXIMUM STRENGTH LIMIT STATE BEARING PRESSURE OF 0.74 KIPS PER SQUARE FOOT. THE FACTORED DESIGN BEARING RESISTANCE IS 2.00 KIPS PER SQUARE FOOT.

#### FOUNDATION MATERIAL:

THE CONTRACTOR SHALL RETAIN THE SERVICES OF "QUALIFIED TECHNICIAN" DEFINED AS A GEOTECHNICAL ENGINEER, GEOTECHNICAL TECHNICIAN, GEOLOGIST, OR OTHER INDIVIDUAL TRAINED IN THE FIELD IDENTIFICATION AND CLASSIFICATION OF SOILS (COMPLETED THE ODOT "SOIL AND ROCK CLASSIFICATION" COURSE OR THE NHI COURSE 132079 SUBSURFACE INVESTIGATION QUALIFICATION.

AFTER EXCAVATION AND PRIOR TO THE CONSTRUCTION OF THE GABION OR GEOCELL FOUNDATIONS, THE QUALIFIED TECHNICIAN SHALL INSPECT THE BOTTOM SURFACE OF THE EXCAVATION. IF ANY AREAS OF THE SOIL ARE DETERMINED BY THE QUALIFIED TECHNICIAN TO BE UNSUITABLE, THEN THE EXCAVATION SHALL BE UNDERCUT IN 1 FOOT INCREMENTS UNTIL SUITABLE MATERIALS ARE ENCOUNTERED OR TO A MAXIMUM DEPTH OF 3 FEET AND FILLED WITH SUITABLE MATERIALS UP TO THE LEVEL OF THE PROPOSED BOTTOM OF FOUNDATION ELEVATION AND COMPACTED IN ACCORDANCE WITH SPECIFICATIONS 911.20. IF UNSUITABLE MATERIALS ARE STILL PRESENT AFTER A 3 FOOT UNDERCUT, THE ENGINEER SHALL BE CONTACTED BEFORE WORK PROCEEDS. THE QUALIFIED TECHNICIAN SHALL DOCUMENT THE SUBSURFACE CONDITION WITH PHOTOGRAPHS AND ANY FIELD TESTING RESULTS PERFORMED AND SUBMIT THE RESULTS AND PHOTOGRAPHS TO THE ENGINEER.

A QUANTITY OF 4 CY FOR SITE H AND 3 CY FOR SITE I IS PROVIDED IN THE PLANS FOR UNDERCUT CONTINGENCY. PAYMENT FOR UNDERCUT SHALL INCLUDE ALL COSTS ASSOCIATED WITH THE UNDERCUTTING, FILLING, AND COMPACTION, INCLUDING ALL LABOR, EQUIPMENT, MATERIALS, AND INCIDENTALS TO COMPLETE THE WORK. THIS ITEM SHALL ONLY BE USED IF DIRECTED BY THE ENGINEER AND SHALL BE PAID FOR UNDER ITEM 91830 FOUNDATION PREPARATION: UNDERCUT CONTINGENCY, ON A PER CUBIC YARD BASIS.

#### **DRILLED SHAFTS:**

THE MAXIMUM FACTORED LOAD TO BE SUPPORTED BY EACH DRILLED SHAFT IS 17.88 KIPS AT THE SITE E ABUTMENTS. THIS LOAD IS RESISTED BY A FACTORED TIP RESISTANCE OF 601.2 KIPS PER SQUARE FOOT.

THE MAXIMUM FACTORED LATERAL LOAD AND BENDING MOMENT TO BE SUPPORTED BY EACH DRILLED SHAFT IS 5.98 KIPS, AND 19.72 KIP-FEET, RESPECTIVELY. THESE LOADS PRODUCE A MAXIMUM FACTORED BENDING MOMENT OF 42.77 KIP-FEET AND MAXIMUM FACTORED SHEAR OF 5.97 KIPS, WITHIN THE DRILLED SHAFT.

THE DRILLED SHAFTS SHALL BE INSTALLED IN ACCORDANCES WITH SECTION 565 OF FP-03 (STANDARD SPECIFICATIONS FOR CONSTRUCTION OF ROADS AND BRIDGES ON FEDERAL HIGHWAY PROJECTS).

INTEGRITY TESTING AS DESCRIBED IN SECTION 565.08 IS NOT REQUIRED FOR THIS PROJECT. THE CONTRACTOR SHALL PREPARE AND TEST CONCRETE CYLINDERS IN ACCORDANCE WITH 552 AND REPORT RESULTS TO THE ENGINEER.

AT THE OPTION OF THE CONTRACTOR, THE CASINGS MAY BE LEFT IN PLACE. THE CONTRACTORS MAY SUBSTITUTE ALTERNATIVE MATERIALS FOR THE CASING OTHER THAN STEEL PROVIDED THAT THEY CAN MAINTAIN A STABLE EXCAVATION AND PROVIDE AN ADEQUATE SEAL AT THE BOTTOM OF THE EXCAVATIONS. THE CONTRACTOR IS RESPONSIBLE FOR THE PERFORMANCE OF THE ALTERNATIVE MATERIALS AND WILL NOT BE REIMBURSED FOR ADDITIONAL WORK CAUSED BY FAILURE OF ALTERNATIVE MATERIALS.

DRILLED SHAFTS ABOVE BEDROCK WILL BE PAID FOR AT THE UNIT PRICE BID FOR ITEM 56501 - DRILLED SHAFTS ROCK SOCKETS WILL BE PAID FOR AT THE UNIT PRICE BID FOR ITEM 56502 - ROCK SOCKET

ALL MATERIALS, EQUIPMENT, LABOR REQUIRED FOR THE INSTALLATION OF THE DRILLED SHAFTS AND ROCK SOCKETS ARE INCLUDED IN THE RELEVANT PAY ITEMS.

# **CONCRETE SEALER (NON-EPOXY):**

THIS WORK CONSISTS OF APPLYING AN APPROVED SEALER ON NEW CONCRETE SURFACE AREAS AFTER THE CONCRETE IS CURED AND REPAIRS COMPLETED AND CURED. APPLY THE SEALER TO LOCATIONS DESCRIBED IN THE PLANS.

FURNISH MATERIALS ACCORDING TO THE OHIO DEPARTMENT OF TRANSPORTATION'S QUALIFIED PRODUCTS LIST (QPL), 705.23NE, NON-EPOXY SEALERS FOR CONCRETE AVAILABLE AT: https://www.dot.state.oh.us/Divisions/ConstructionMgt/Materials/Pages/QPL.aspx

EQUIPMENT: USE APPLICATION EQUIPMENT RECOMMENDED BY THE SEALER MANUFACTURER. USE SPRAY EQUIPMENT, TANKS, HOSES, BROOMS, ROLLERS, COATERS, SQUEEGEES, ETC., THAT ARE CLEAN, FREE OF FOREIGN MATTER, OIL RESIDUE AND WATER.

MIXING: MIX THE SEALER ACCORDING TO THE MANUFACTURER'S RECOMMENDED PROCEDURES. FURNISH THE ENGINEER WITH THE MANUFACTURER'S APPLICATION INSTRUCTIONS. DO NOT MIX OR APPLY THE SEALER UNTIL THE MANUFACTURER'S WRITTEN RECOMMENDATIONS ARE SUPPLIED TO THE ENGINEER. MIX AND MAINTAIN MATERIALS AT A UNIFORM CONSISTENCY DURING APPLICATION.

STORAGE: STORE ALL SEALER COMPONENTS IN TIGHTLY SEALED CONTAINERS, IN A DRY LOCATION, AND AS RECOMMENDED BY THE MANUFACTURER. DELIVER UNOPENED DRUMS OR CONTAINERS OF THE SEALER OR SEALER COMPONENTS TO THE JOB SITE WITH THE MANUFACTURER'S NUMBERED SEAL INTACT.

SURFACE CONDITION: APPLY SEALERS ONLY TO SURFACES WHICH ARE DRY, FREE FROM DUST, DIRT, OIL, WAX, CURING COMPOUNDS, EFFLORESCENCE, LAITANCE, COATINGS AND OTHER FOREIGN MATERIALS. VISUALLY INSPECT ALL SURFACES BEFORE APPLYING SEALER. REMOVE ALL STRUCTURALLY UNSOUND SURFACES AND WEAK SECTIONS. PERFORM ALL CONCRETE PATCHING PRIOR TO SURFACE PROFILING. PERFORM CONCRETE PATCHING ON AREAS IDENTIFIED BY THE ENGINEER. CURE REPAIRED AREAS FOR AT LEAST SEVEN (7) DAYS. AIR DRY ALL CONCRETE SURFACES FOR AT LEAST TEN (10) DAYS AFTER COMPLETION OF REQUIRED CURING. FOR ACCELERATED CURE OF PRECAST CONCRETE, OBTAIN THE REQUIRED 28 DAY STRENGTH AND AIR DRY THE SURFACES AT LEAST TEN (10) DAYS AFTER COMPLETING ACCELERATED CURE.

SURFACE PREPARATION: REMOVE DUST, DIRT, OIL, WAX, CURING COMPOUNDS, EFFLORESCENCE, LAITANCE, COATINGS AND OTHER FOREIGN MATERIALS FROM SURFACES TO BE SEALED.

APPLICATION: DO NOT APPLY SEALER TO SURFACES WITH MOISTURE. APPLY THE SEALER BETWEEN 12 AND 48 HOURS AFTER SURFACE PREPARATION. DO NOT APPLY SEALER IF RAIN IS ANTICIPATED WITHIN SIX (6) HOURS AFTER APPLICATION. WAIT AT LEAST 12 HOURS AFTER LAST RAIN EVENT TO APPLY SEALER. CLEARLY MARK WHERE THE SEALER APPLICATION STOPS IF NOT CONTINUOUS. APPLY THE SEALER ACCORDING TO THE MANUFACTURER'S RECOMMENDED MODE OF APPLICATION.

COVERAGE: MINIMUM, ONE GALLON (3.875 LITER) FOR EACH 150 SQUARE FEET (14.0 SQUARE METERS). APPLY SEALER ON HORIZONTAL SURFACES IN A ONE-PASS OPERATION AT THE REQUIRED COVERAGE. AN ACCEPTABLE APPLICATION PROCEDURE CONSISTS OF SATURATING THE SURFACE AND WAITING A FEW SECONDS FOR THE SEALER TO COMPLETELY PENETRATE THE CONCRETE SURFACE. BROOM IN THE SEALER IF RECOMMENDED BY THE MANUFACTURER. APPLY SEALER ON VERTICAL SURFACES TO SATURATE THE SURFACE. THE SURFACE IS SATURATED WHEN RUNS OF 6 TO 12 INCHES DEVELOP. APPLY ADDITIONAL PASSES IN 10 TO 15 MINUTE INTERVALS UNTIL THE COVERAGE RATE IS ACHIEVED. APPLY SEALERS WITH BRUSH OR ROLLER IF RECOMMENDED BY THE MANUFACTURER. AFTER 10 TO 15 MINUTES, SQUEEGEE OFF EXCESS MATERIAL ON SMOOTH FINISHED OR DENSE CONCRETES WHERE THE REQUIRED COVERAGE IS NOT ABSORBED.

SAFETY PRECAUTIONS: FOLLOW PRECAUTIONS DEFINED ON THE MANUFACTURER'S SDS.

ENVIRONMENTAL REQUIREMENTS. PROTECT PLANTS AND VEGETATION FROM OVERSPRAY BY COVERING WITH DROP CLOTHS.

MEASUREMENT AND PAYMENT: PAYMENT SHALL BE INCIDENTAL TO ITEM 965.


WAYNE NATIONAL FOREST TRAIL BRIDGES BUCKEYE TRAILS ASSOCIATION DRAWING NAME

### **STRUCTURE NOTES**

**GLULAM BEAM BRIDGES** 

BRIDGE

REVISION DATE	SUBSE	T		
8/29/23	1	OF	14	
NOT TO SCALE	SHEET 14	I	49	

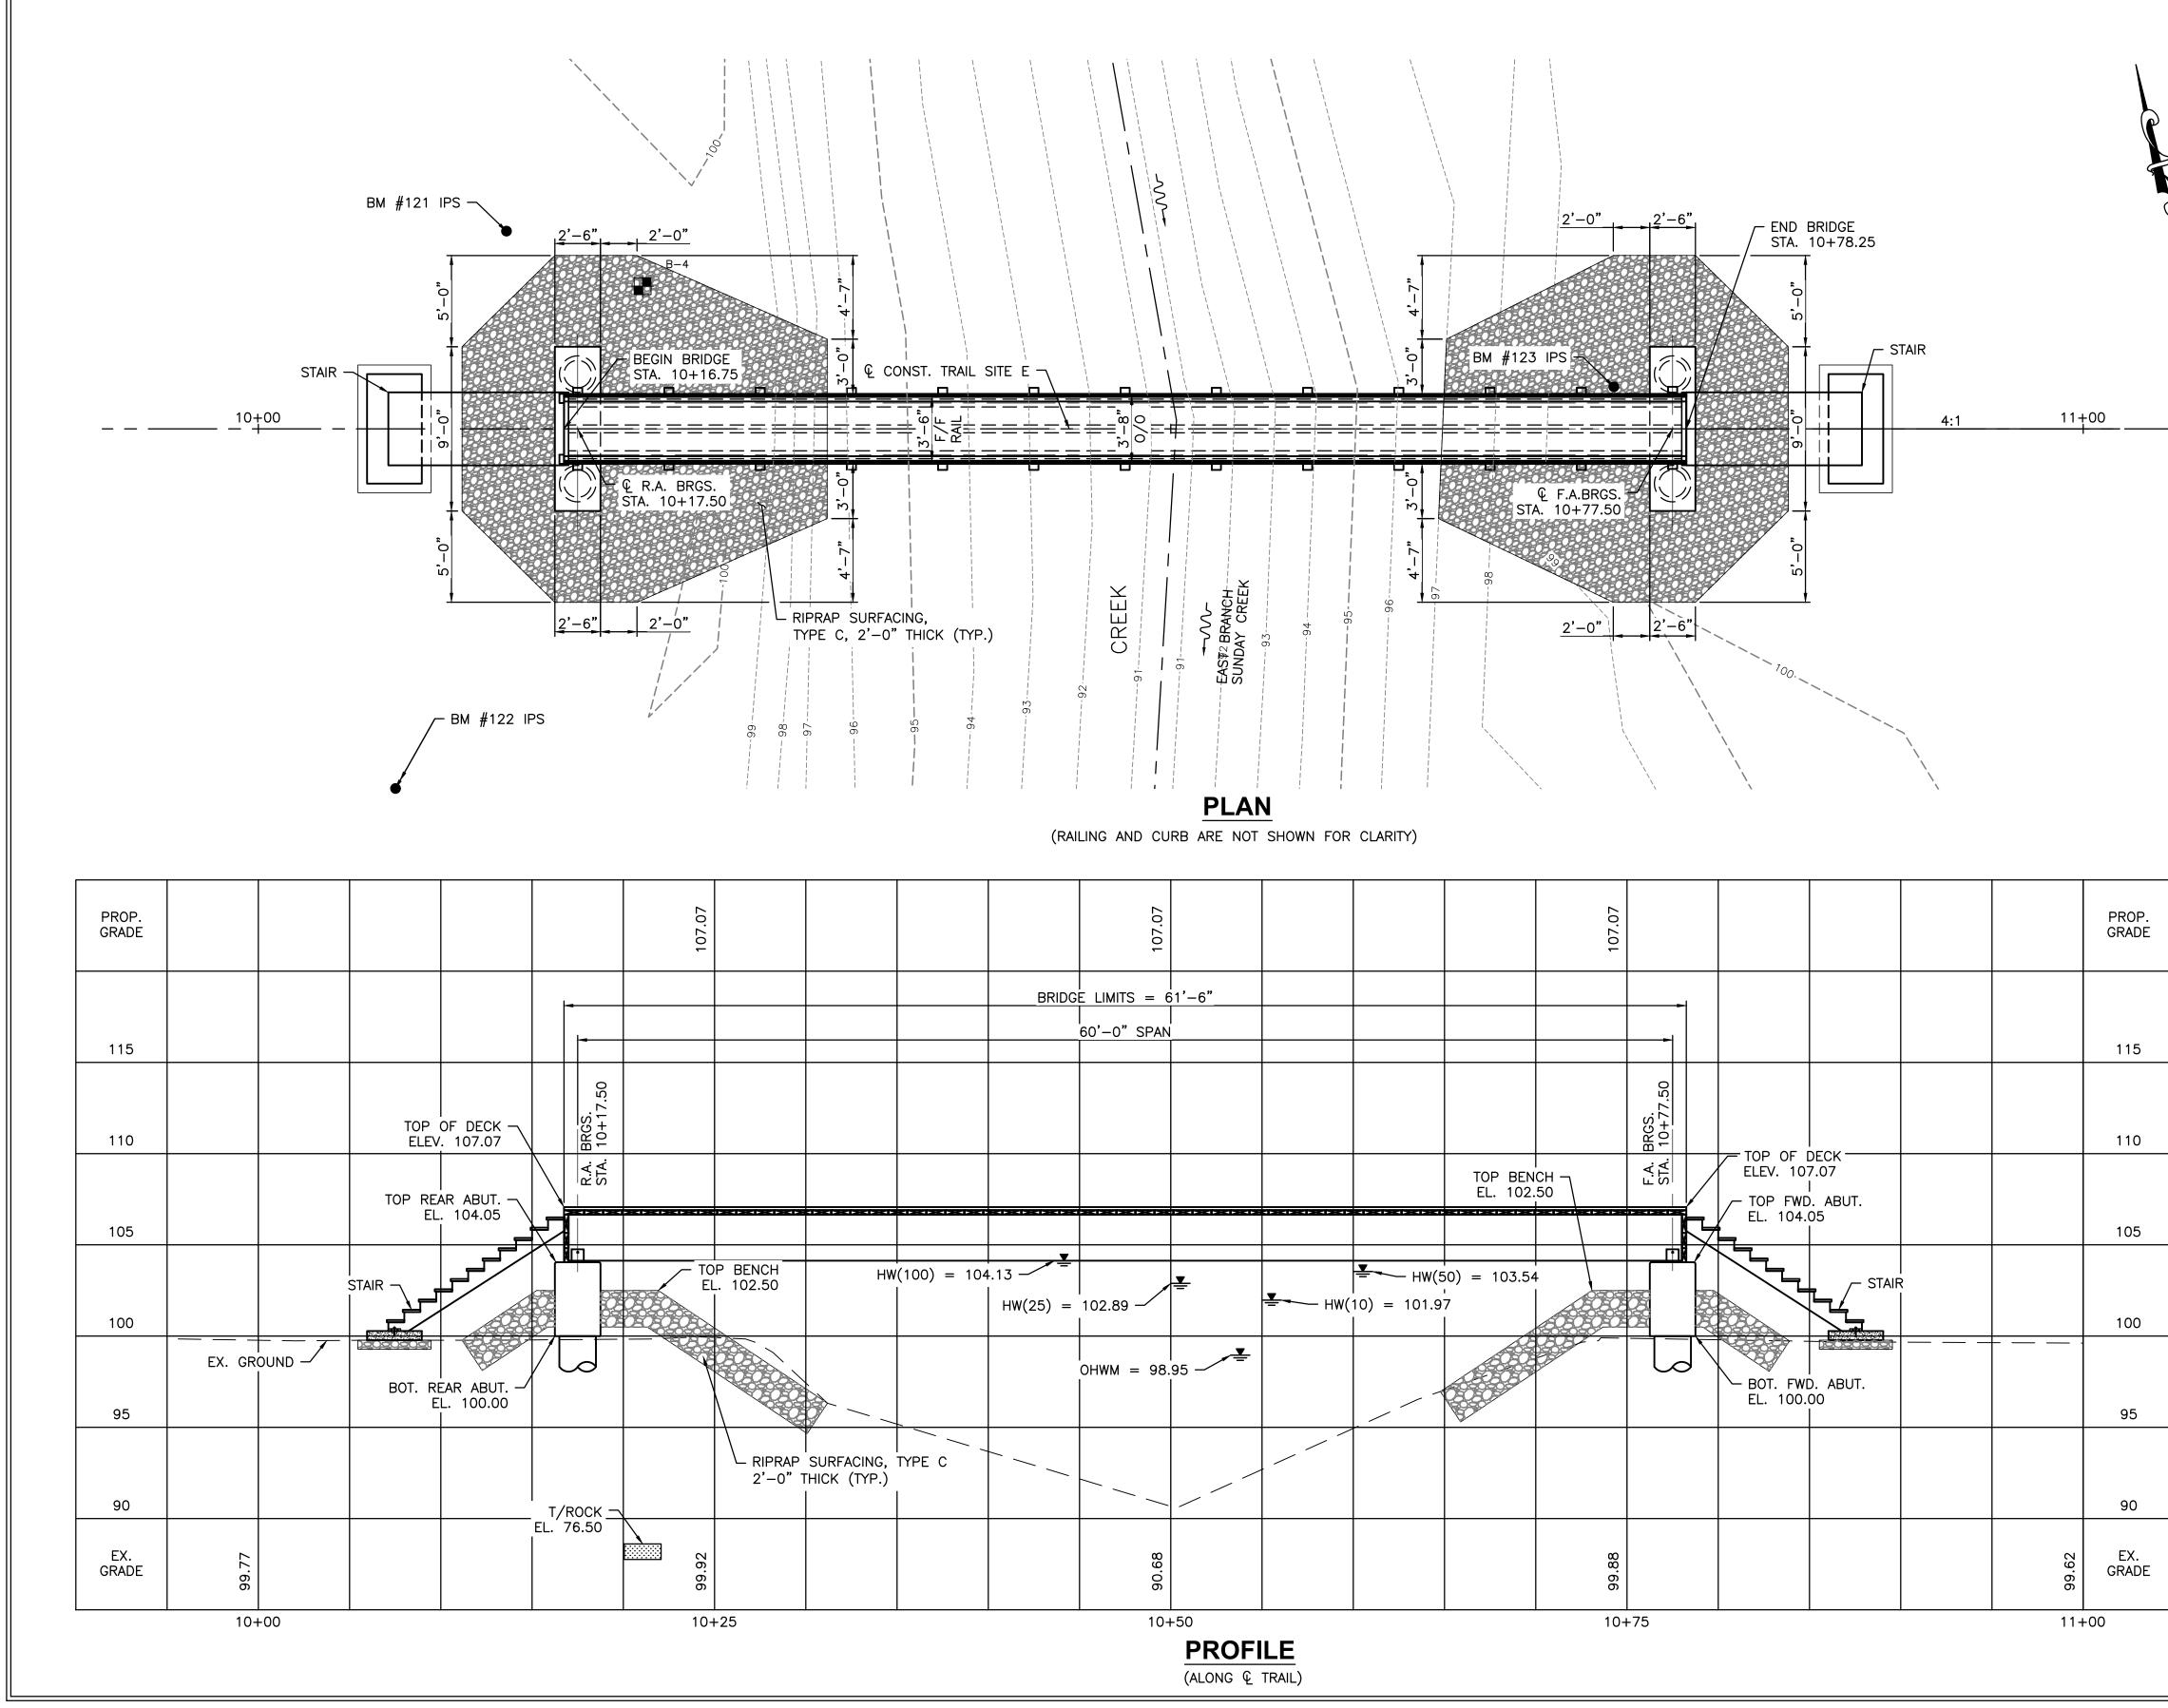



**PROJECT NAME & LOCATION** 

m l

WAYNE NATIONAL FOREST TRAIL BRIDGES **BUCKEYE TRAILS ASSOCIATION** 

BRIDGE SITE E - TRAIL OVER E BRANCH SUNDAY CREEK

DRAWING NAME



SITE PLAN



BENCHMARK AND CONTROL DATA									
CONTROL POINT	DESCRIPTION	NORTHING	EASTING	ELEV.	STATION	OFFSET			
BM#121	IRON PIN	5000	5000	100	10+13.60	10.84' LT			
BM#122	IRON PIN	4908.278	4970.464	99.81	10+07.53	85.33' RT			
BM#123	IRON PIN	4976.806	5056.72	99.99	10+74.34	2.32' LT			
B.A.	BEGIN ALIGNMENT	4992.84	4984.16	SEE PROFILE	10+00.00	0			
CL R.A.	POINT ALONG ALIGNMENT	4986.69	5008.39	SEE PROFILE	10+25.00	0			
CL F.A.	POINT ALONG ALIGNMENT	4974.39	5056.85	SEE PROFILE	10+75.00	0			
F.A.	END ALIGNMENT	4968.24	5081.08	SEE PROFILE	11+00.00	0			

FOR ADDITIONAL BENCHMARK INFORMATION, SEE GENERAL NOTES SHEET 3/49.



BORING LOCATION

RIPRAP SURFACING, TYPE C, 2'-0" THICK


#### **HYDRAULIC DATA**


DRAINAGE AREA = $22.8$ SQ.	MILES	
Q (10) = 2,580 CFS	V (10) = 6.16 FT/S	DESIGN
Q (25) = 3.480 CFS	V (25) = 6.83 FT/S	SCOUR DESIGN
Q (50) = 4,220 CFS	V (50) = 7.22 FT/S	SCOUR CHECK
Q (100) = 5,000 CFS	V (100) = 7.61 FT/S	FEMA

STRUCTURE CLEARS THE 100-YEAR HIGH WATER ELEVATION HW BY 0.01 FEET. STRUCTURE IS LOCATED IN FEMA ZONE A.

### PROPOSED STRUCTURE

TYPE: THREE GLULAM STRINGER TRAIL BRIDGE ON CONCRETE FOUNDATIONS WITH DRILLED SHAFTS. SPANS: 60'-0" C/C BEARINGS ROADWAY: 3'-6" F/F RAILING LOADING: 0.090 KSF PEDESTRIAN SKEW: NONE LATITUDE 39° 34' 17.04" N LONGITUDE 82° 01' 52.68" W COORDINATES: LATITUDE

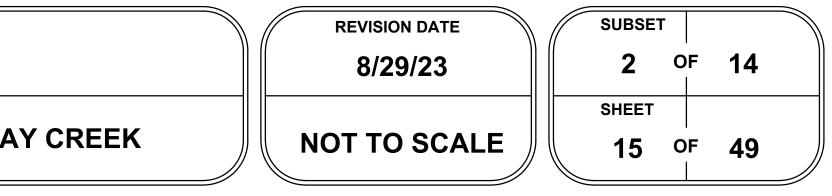

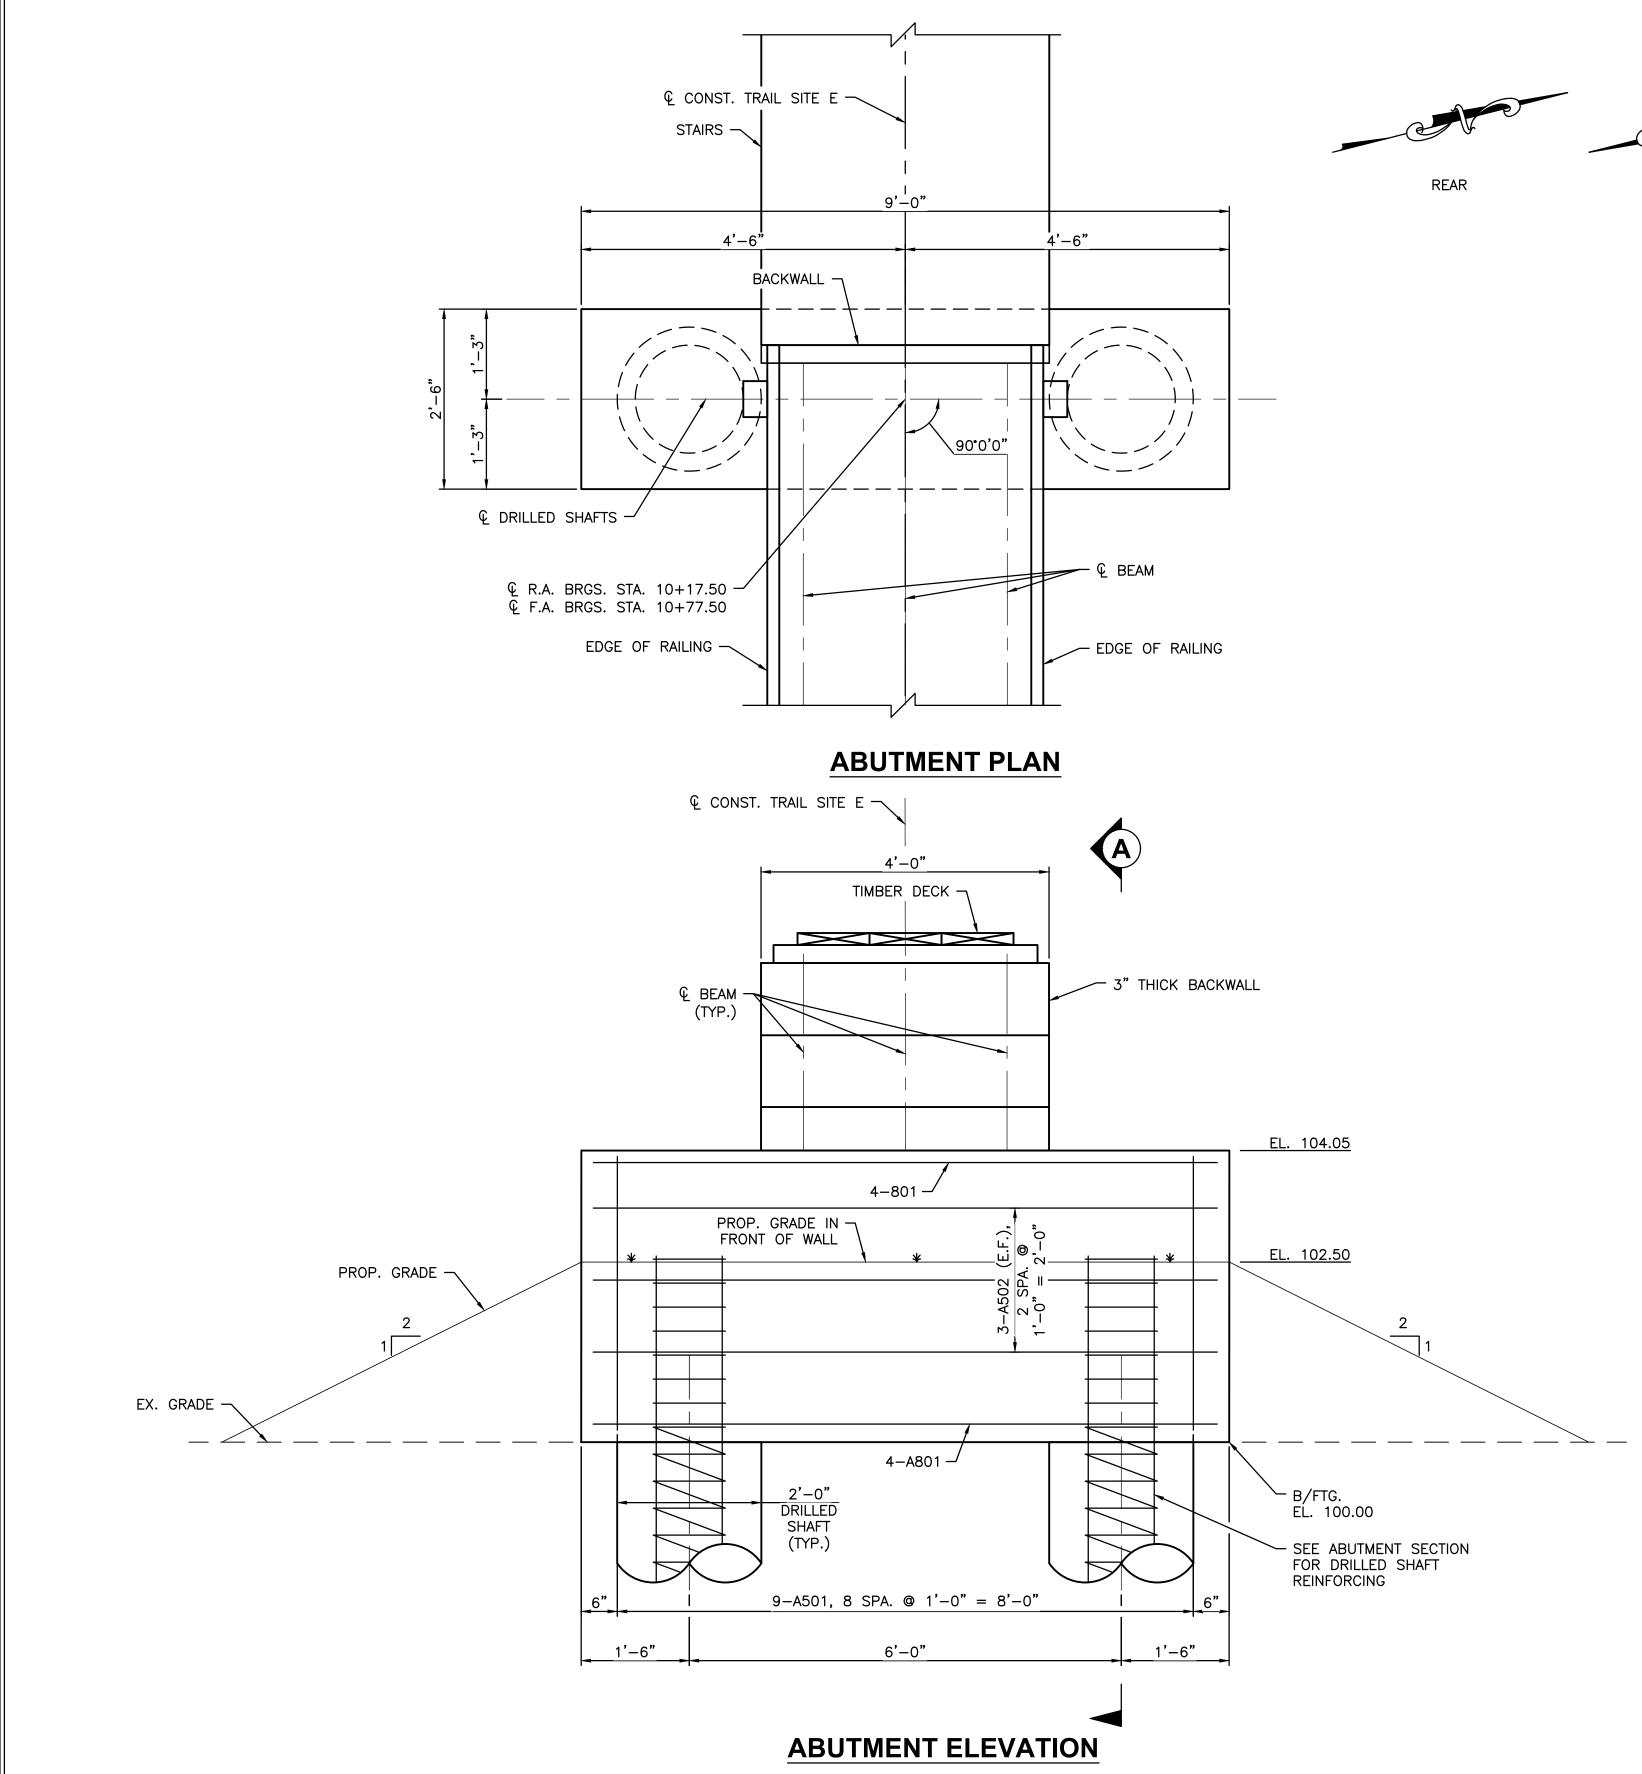






DRAWING NAME


**ABUTMENT PLAN AND ELEVATION** 


BRIDGE SITE E - TRAIL OVER E BRANCH SUNDAY CREEK

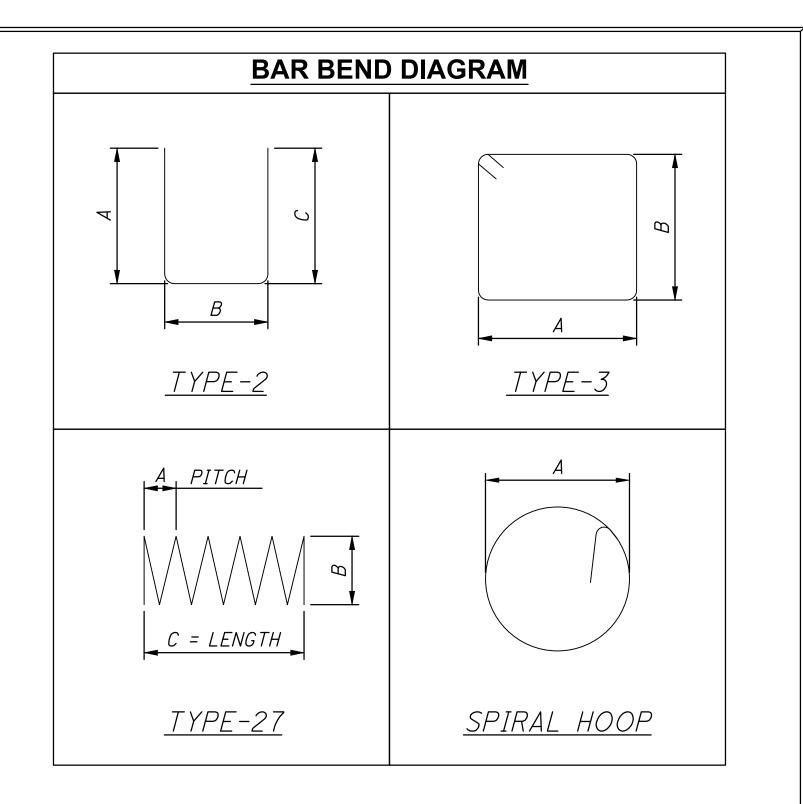

	SITE E ABUTMENT											
			WEIGHT	TVDE			D	IMENSION	IS			
MARK	NUMBER	LENGTH	(LBS)	TYPE	А	В	С	D	E	R	INC.	
A501	18	11'-6"	216	3	2'-0"	3'-6"						
A502	12	8'-6"	107	ST.								
A801	16	8'-6"	364	ST.								
DS401	28	3'-6"	66	HOOP	1'-0"							
DS702	32	28'-10"	1886	ST.								
SP401	4	221'-5"	621	27	4.5"	1'-0"	26'-5"					
	TOTAL		3260									

- 1. SEE SHEET 17/49 FOR SECTION A.
- 2. THE BAR SIZE NUMBER IS SPECIFIED ON THE PLANS IN THE BAR MARK COLUMN. THE FIRST DIGIT AFTER THE LETTERS WHERE THREE DIGITS ARE USED, AND THE FIRST TWO DIGITS AFTER THE LETTERS WHERE FOUR ARE USED, INDICATES THE BAR SIZE NUMBER. FOR EXAMPLE, A501 IS A NO. 5 BAR IN THE ABUTMENT. A LEGEND OF THE DESCRIPTORS IS GIVEN BELOW:
- A ABUTMENT DS – DRILLED SHAFT SP – SPIRAL
- 3. BAR DIMENSIONS SHOWN ARE OUT-TO-OUT UNLESS OTHERWISE NOTED.
- 4. "ST." INDICATES A STRAIGHT BAR.

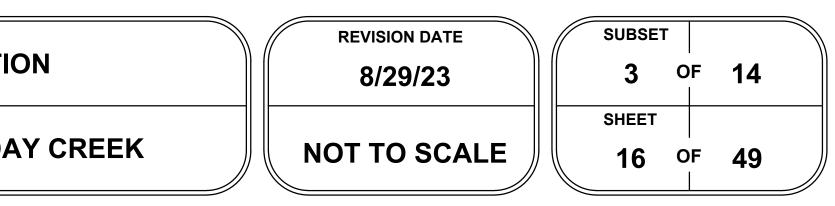


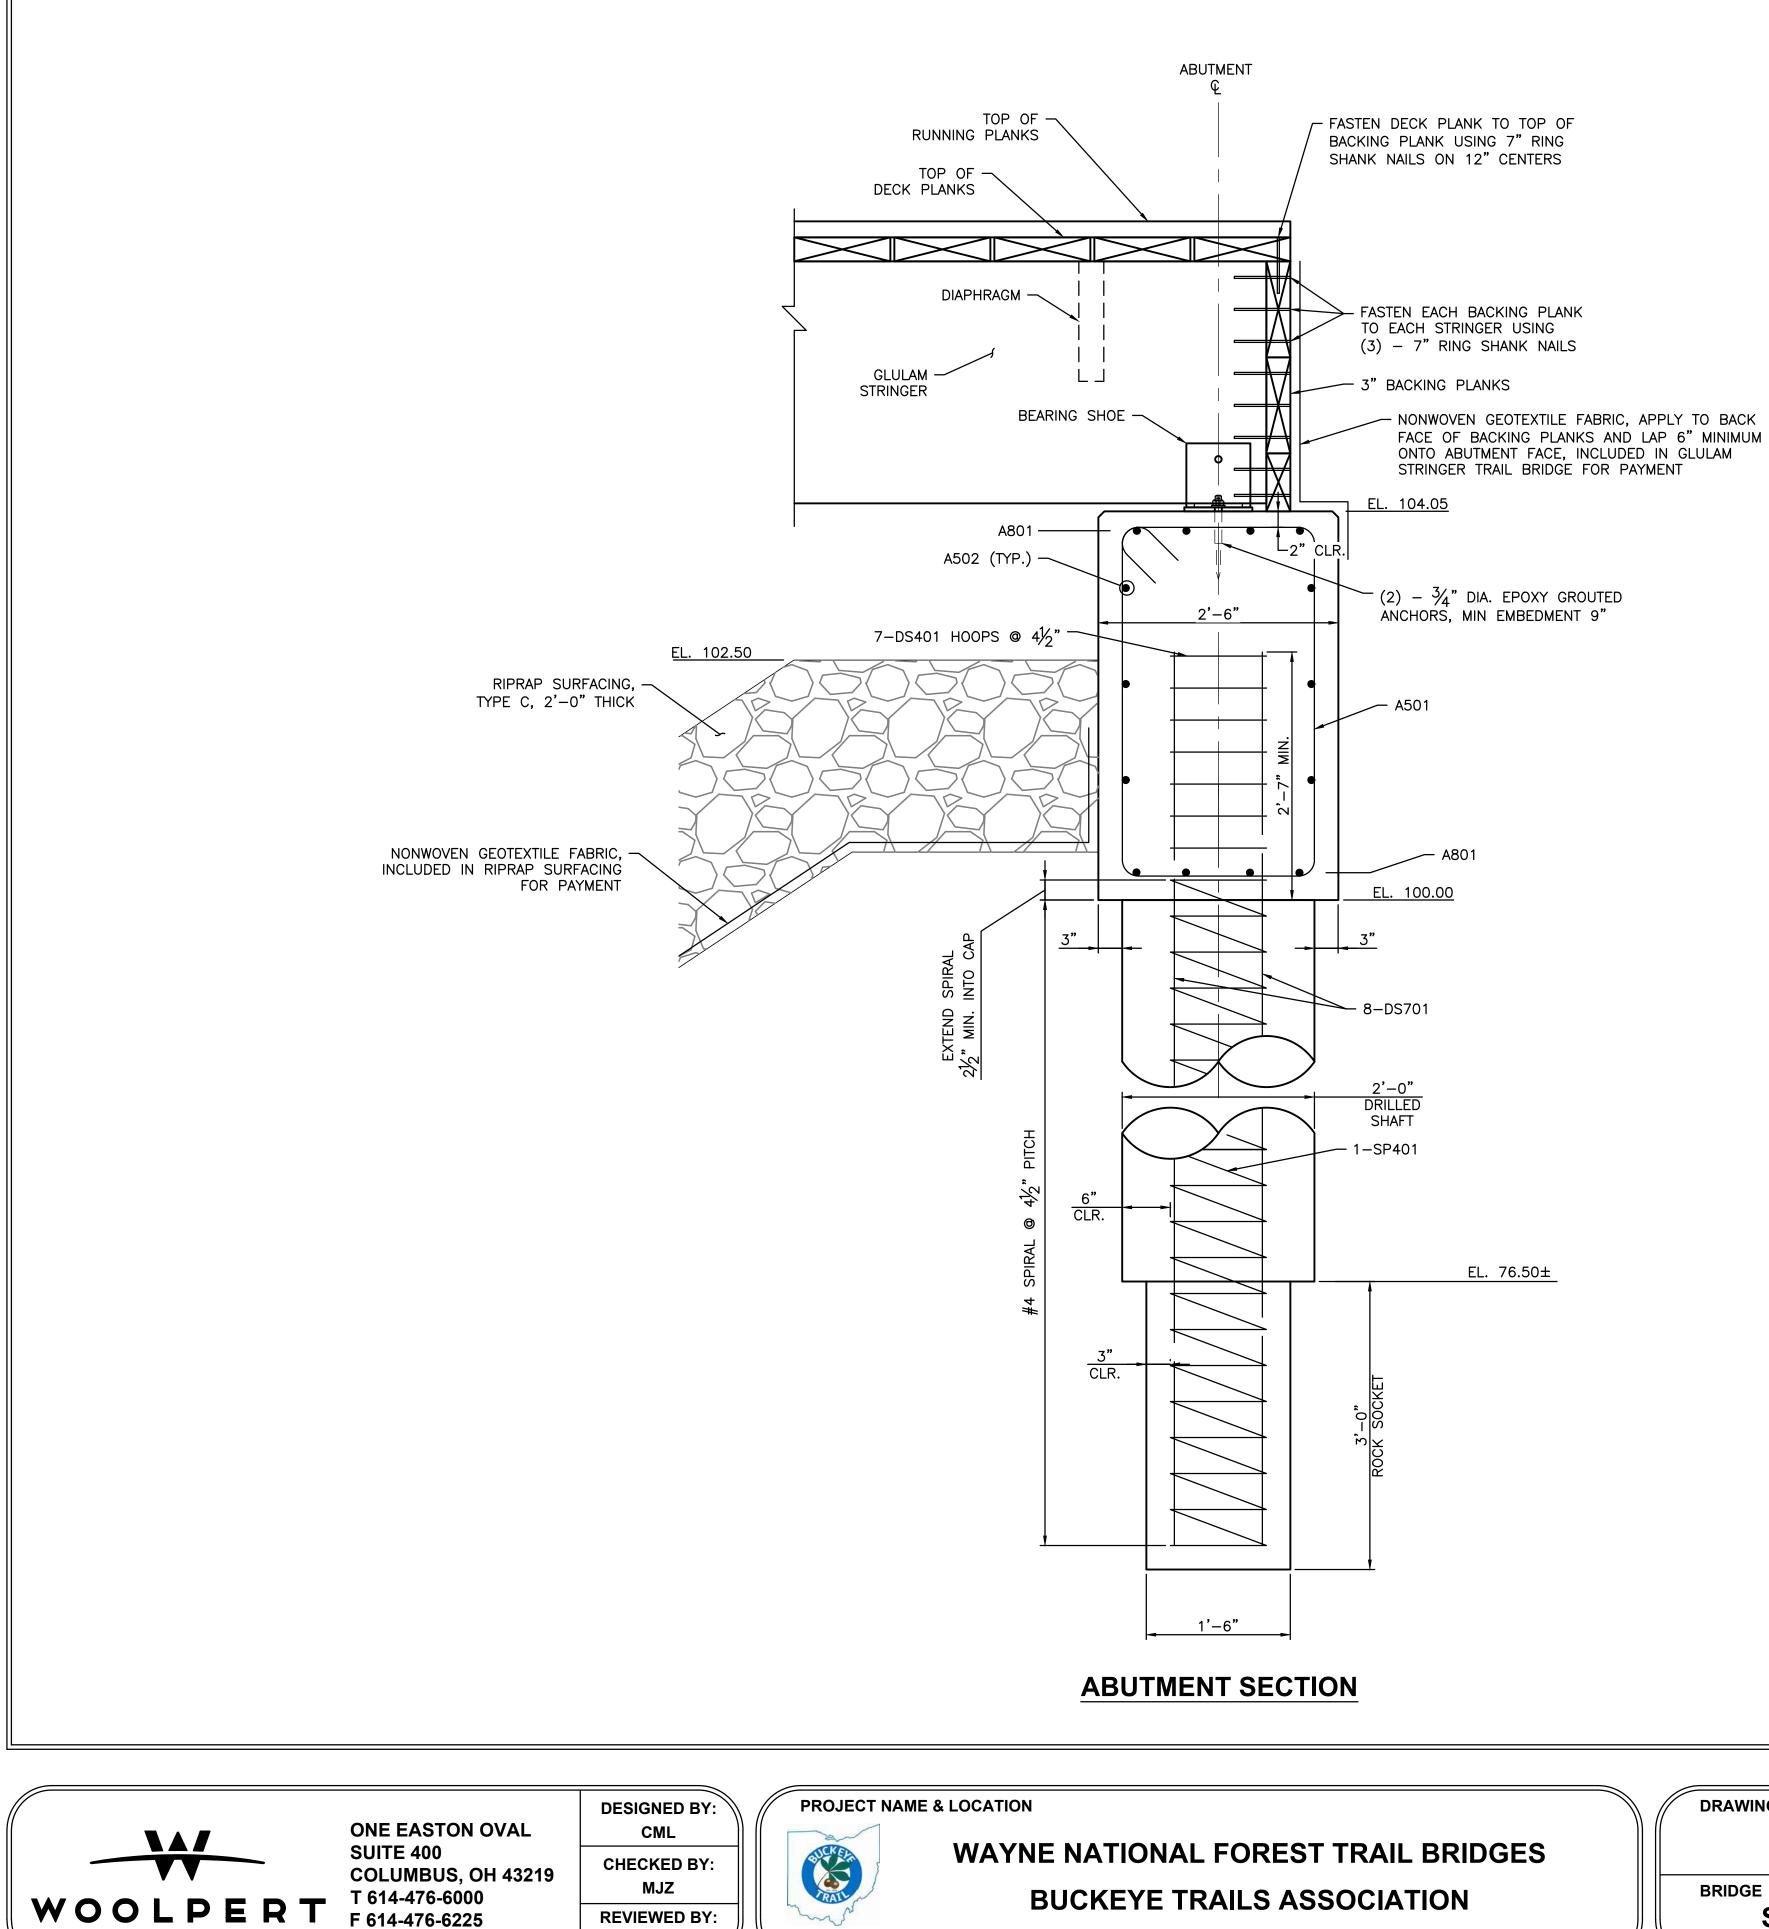


TML

BRIDGE SITE E - TRAIL OVER E BRANCH SUNDAY CREEK


DRAWING NAME

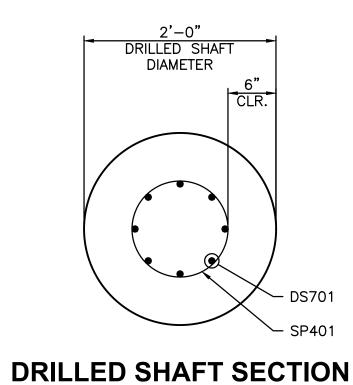


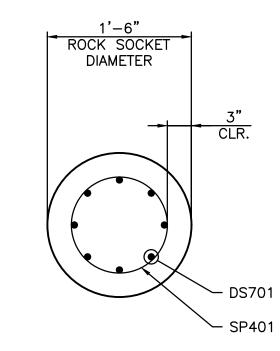


#### **ROCK SOCKET SECTION**

- 1. SEE SHEET 16/49 FOR ABUTMENT PLAN AND ELEVATION.
- 2. ASSUME 3" CONCRETE COVER UNLESS NOTED OTHERWISE.
- 3. CENTERING DEVICES SHALL BE REQUIRED DURING CONSTRUCTION TO MAINTAIN ALIGNMENT OF CAGES AND MIN. CONCRETE COVER. CENTERING DEVICES SHALL BE PLACED AT INTERVALS NOT EXCEEDING 5-FT THROUGHOUT THE LENGTH OF THE SHAFT. PROVIDE MIN. ONE SET OF CENTERING DEVICES WITHIN 2-FT TOP AND 2-FT BOTTOM OF SHAFT. PROVIDE CENTERING DEVICES MIN. 60-DEGREE INTERVALS AROUND CIRCUMFERENCE OF SHAFT.
- 4. PROVIDE FEET (BOTTOM SUPPORTS) AT THE BOTTOM OF THE SHAFT ON VERTICAL BARS.

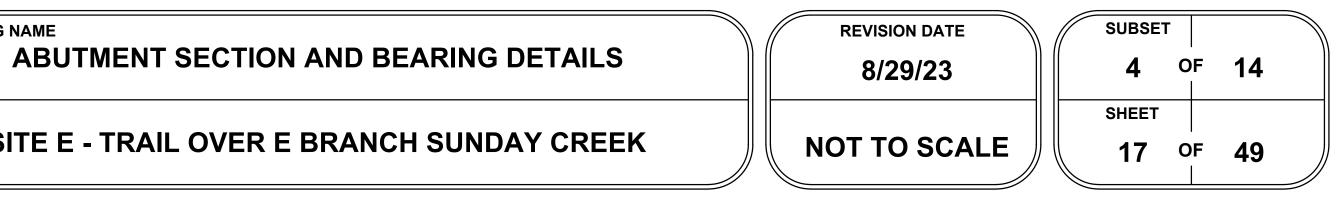

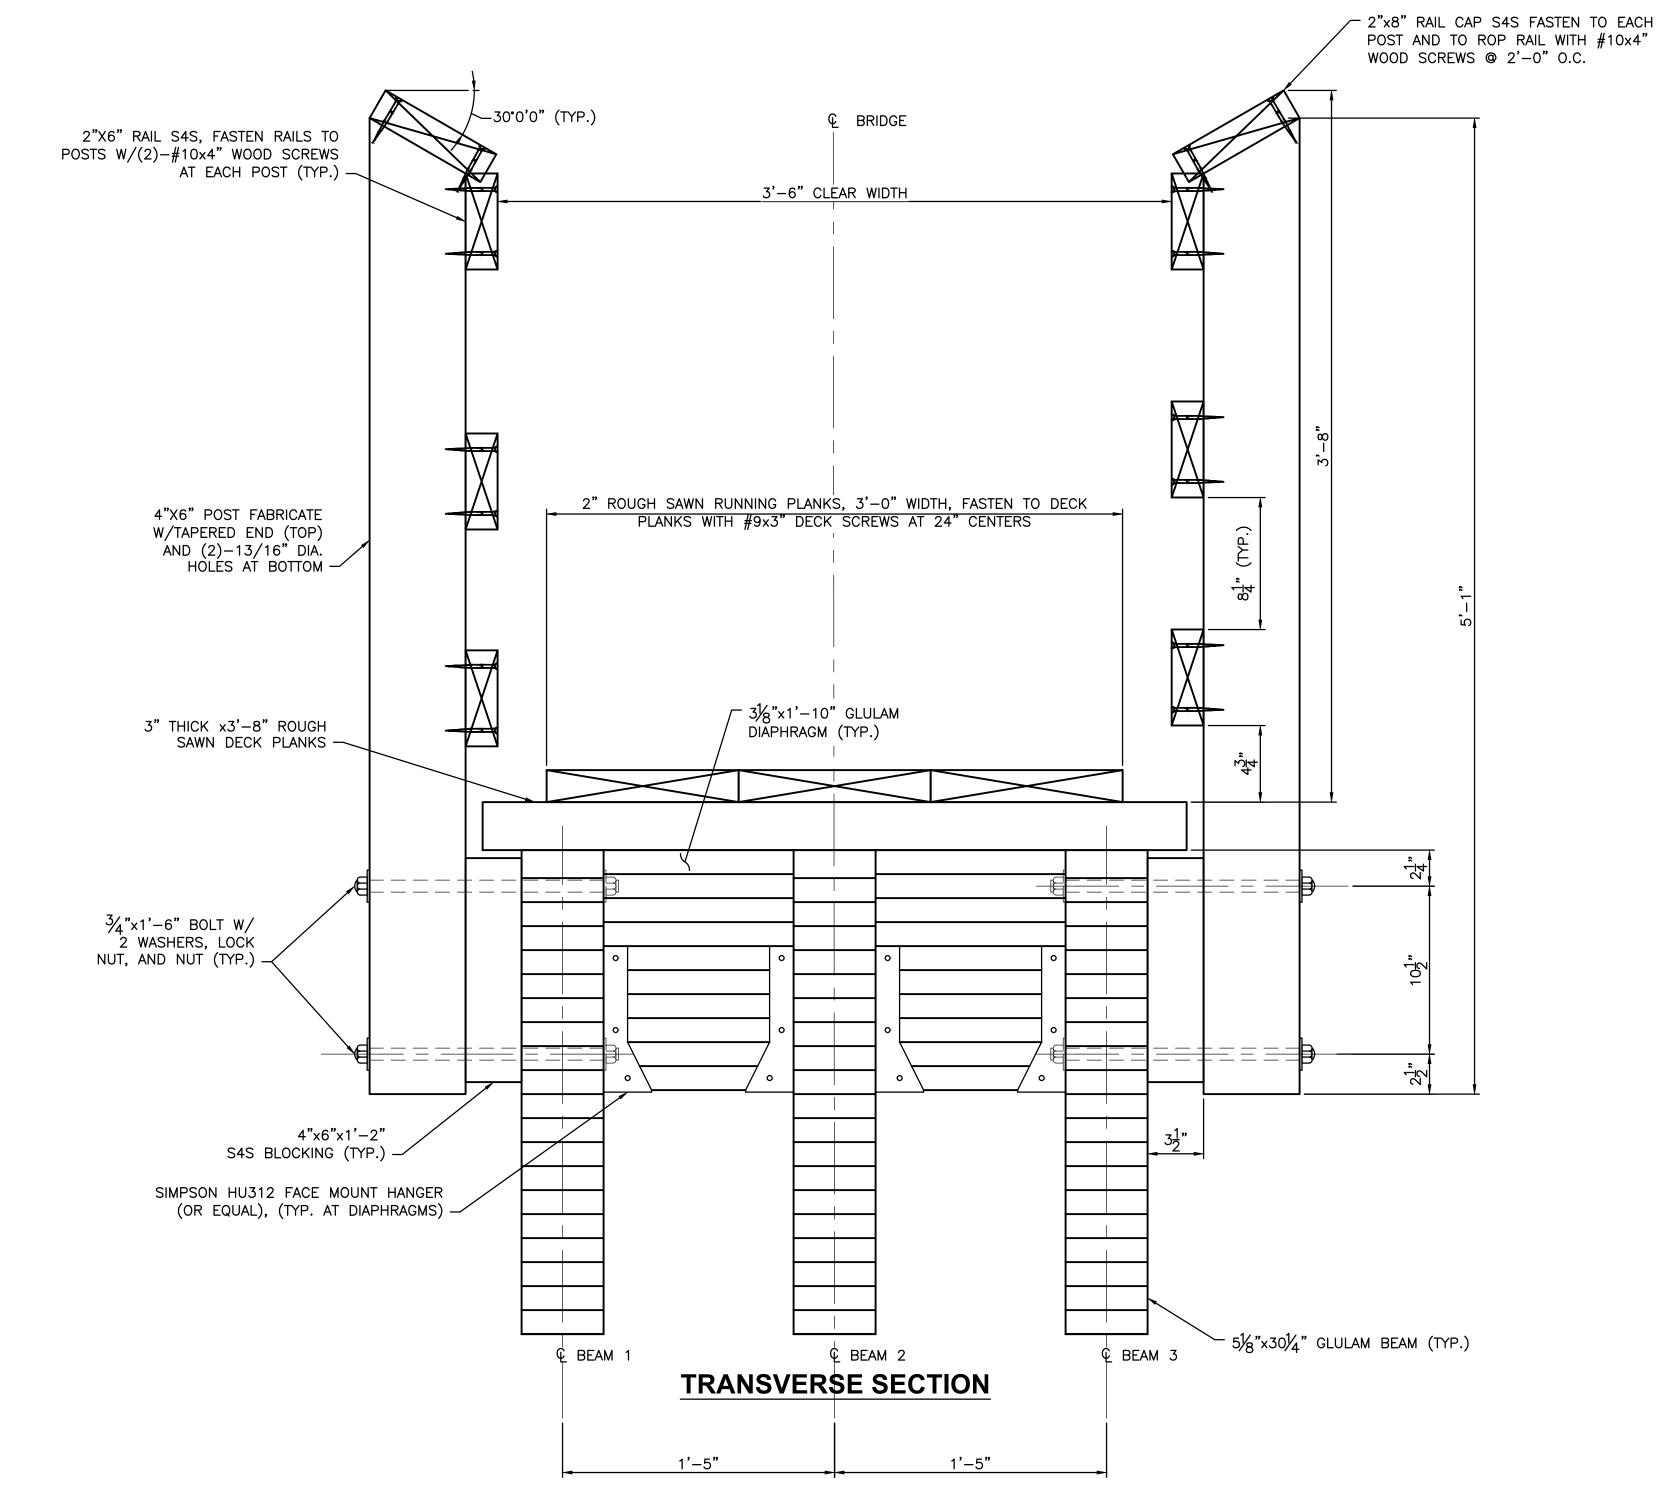

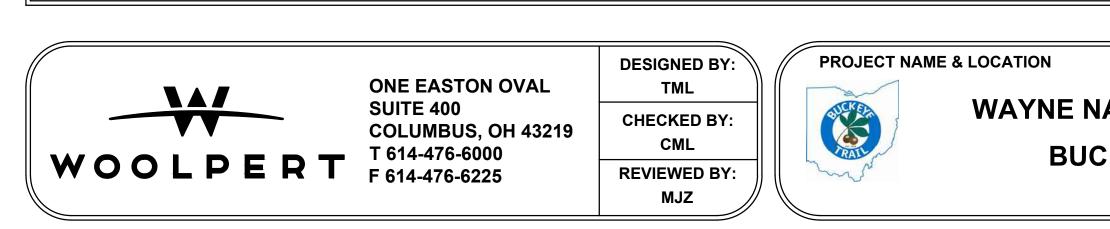


DRAWING NAME

BRIDGE


**TRANSVERSE SECTION** 


SITE E - TRAIL OVER E BRANCH SUNDAY CREEK



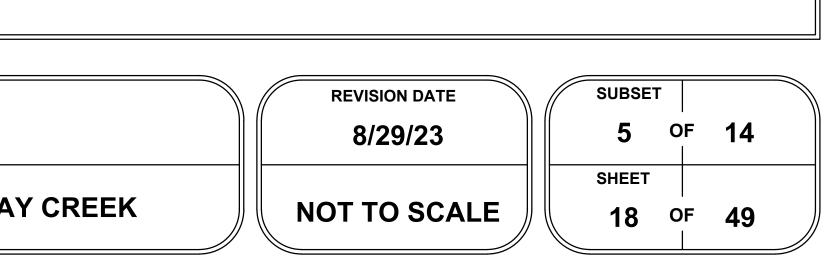

REFER TO USFS STD-963-10-2D AND STD-963-10-3D FOR ADDITIONAL DETAILS.

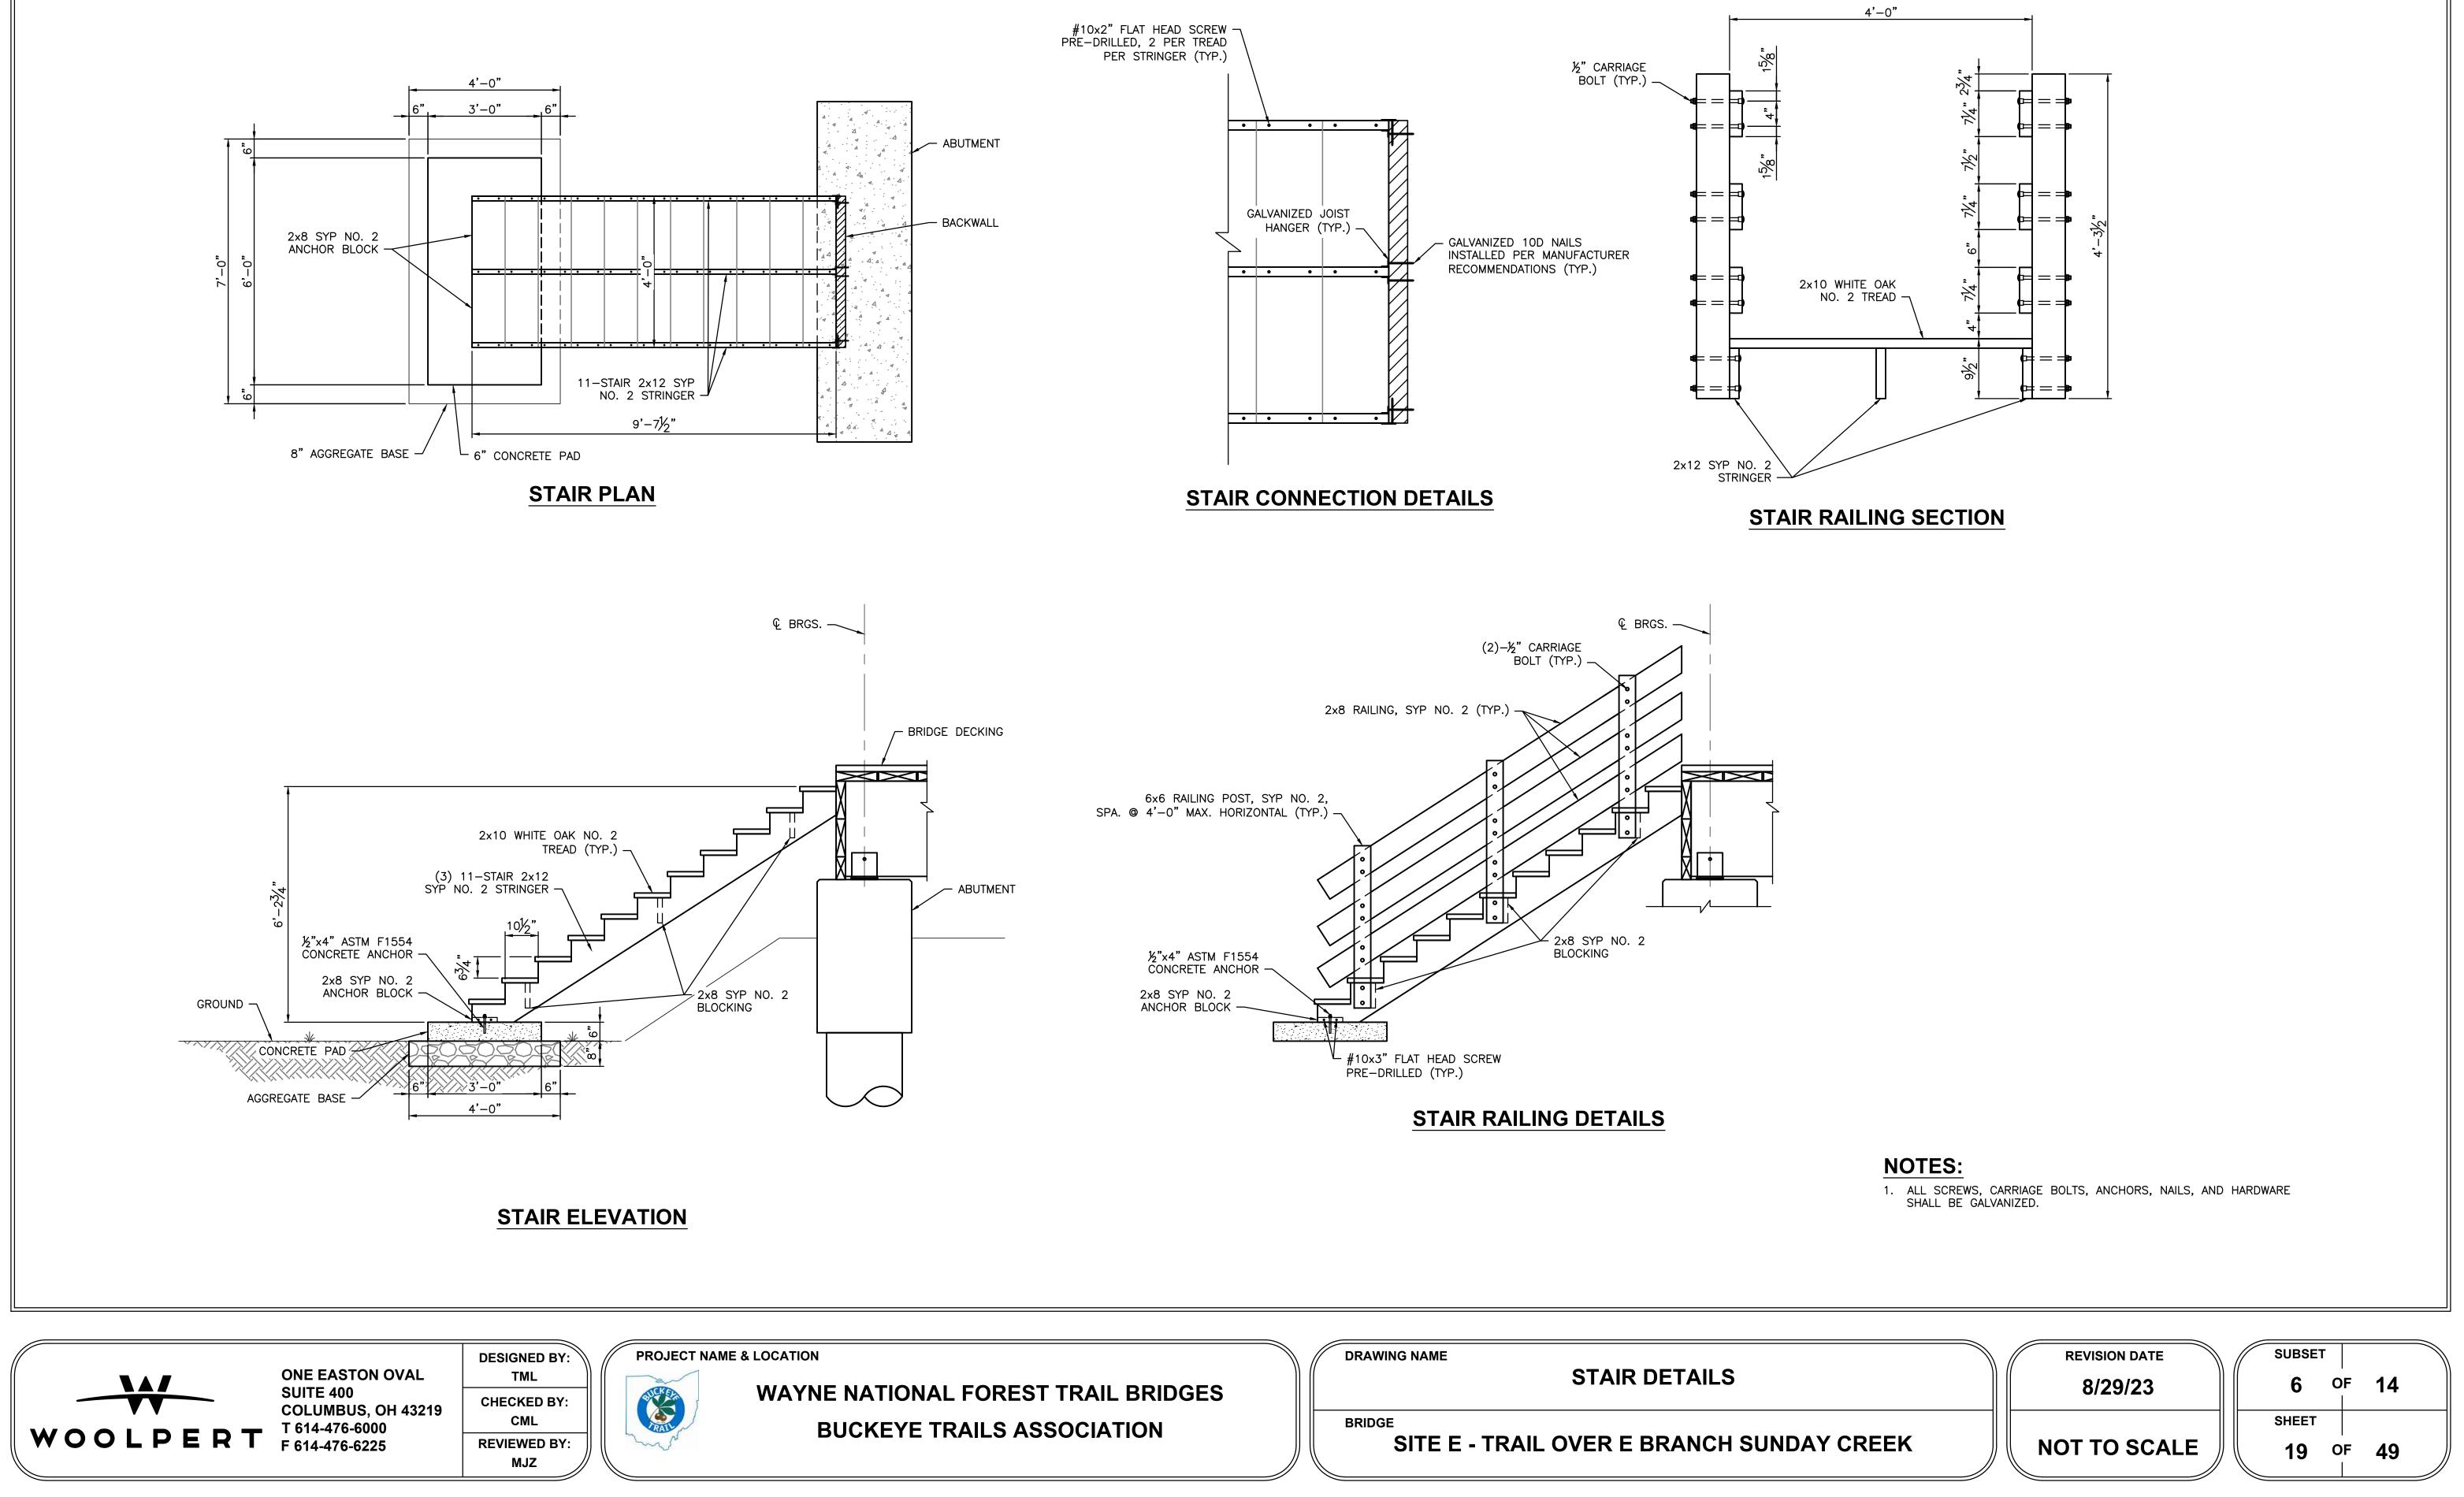

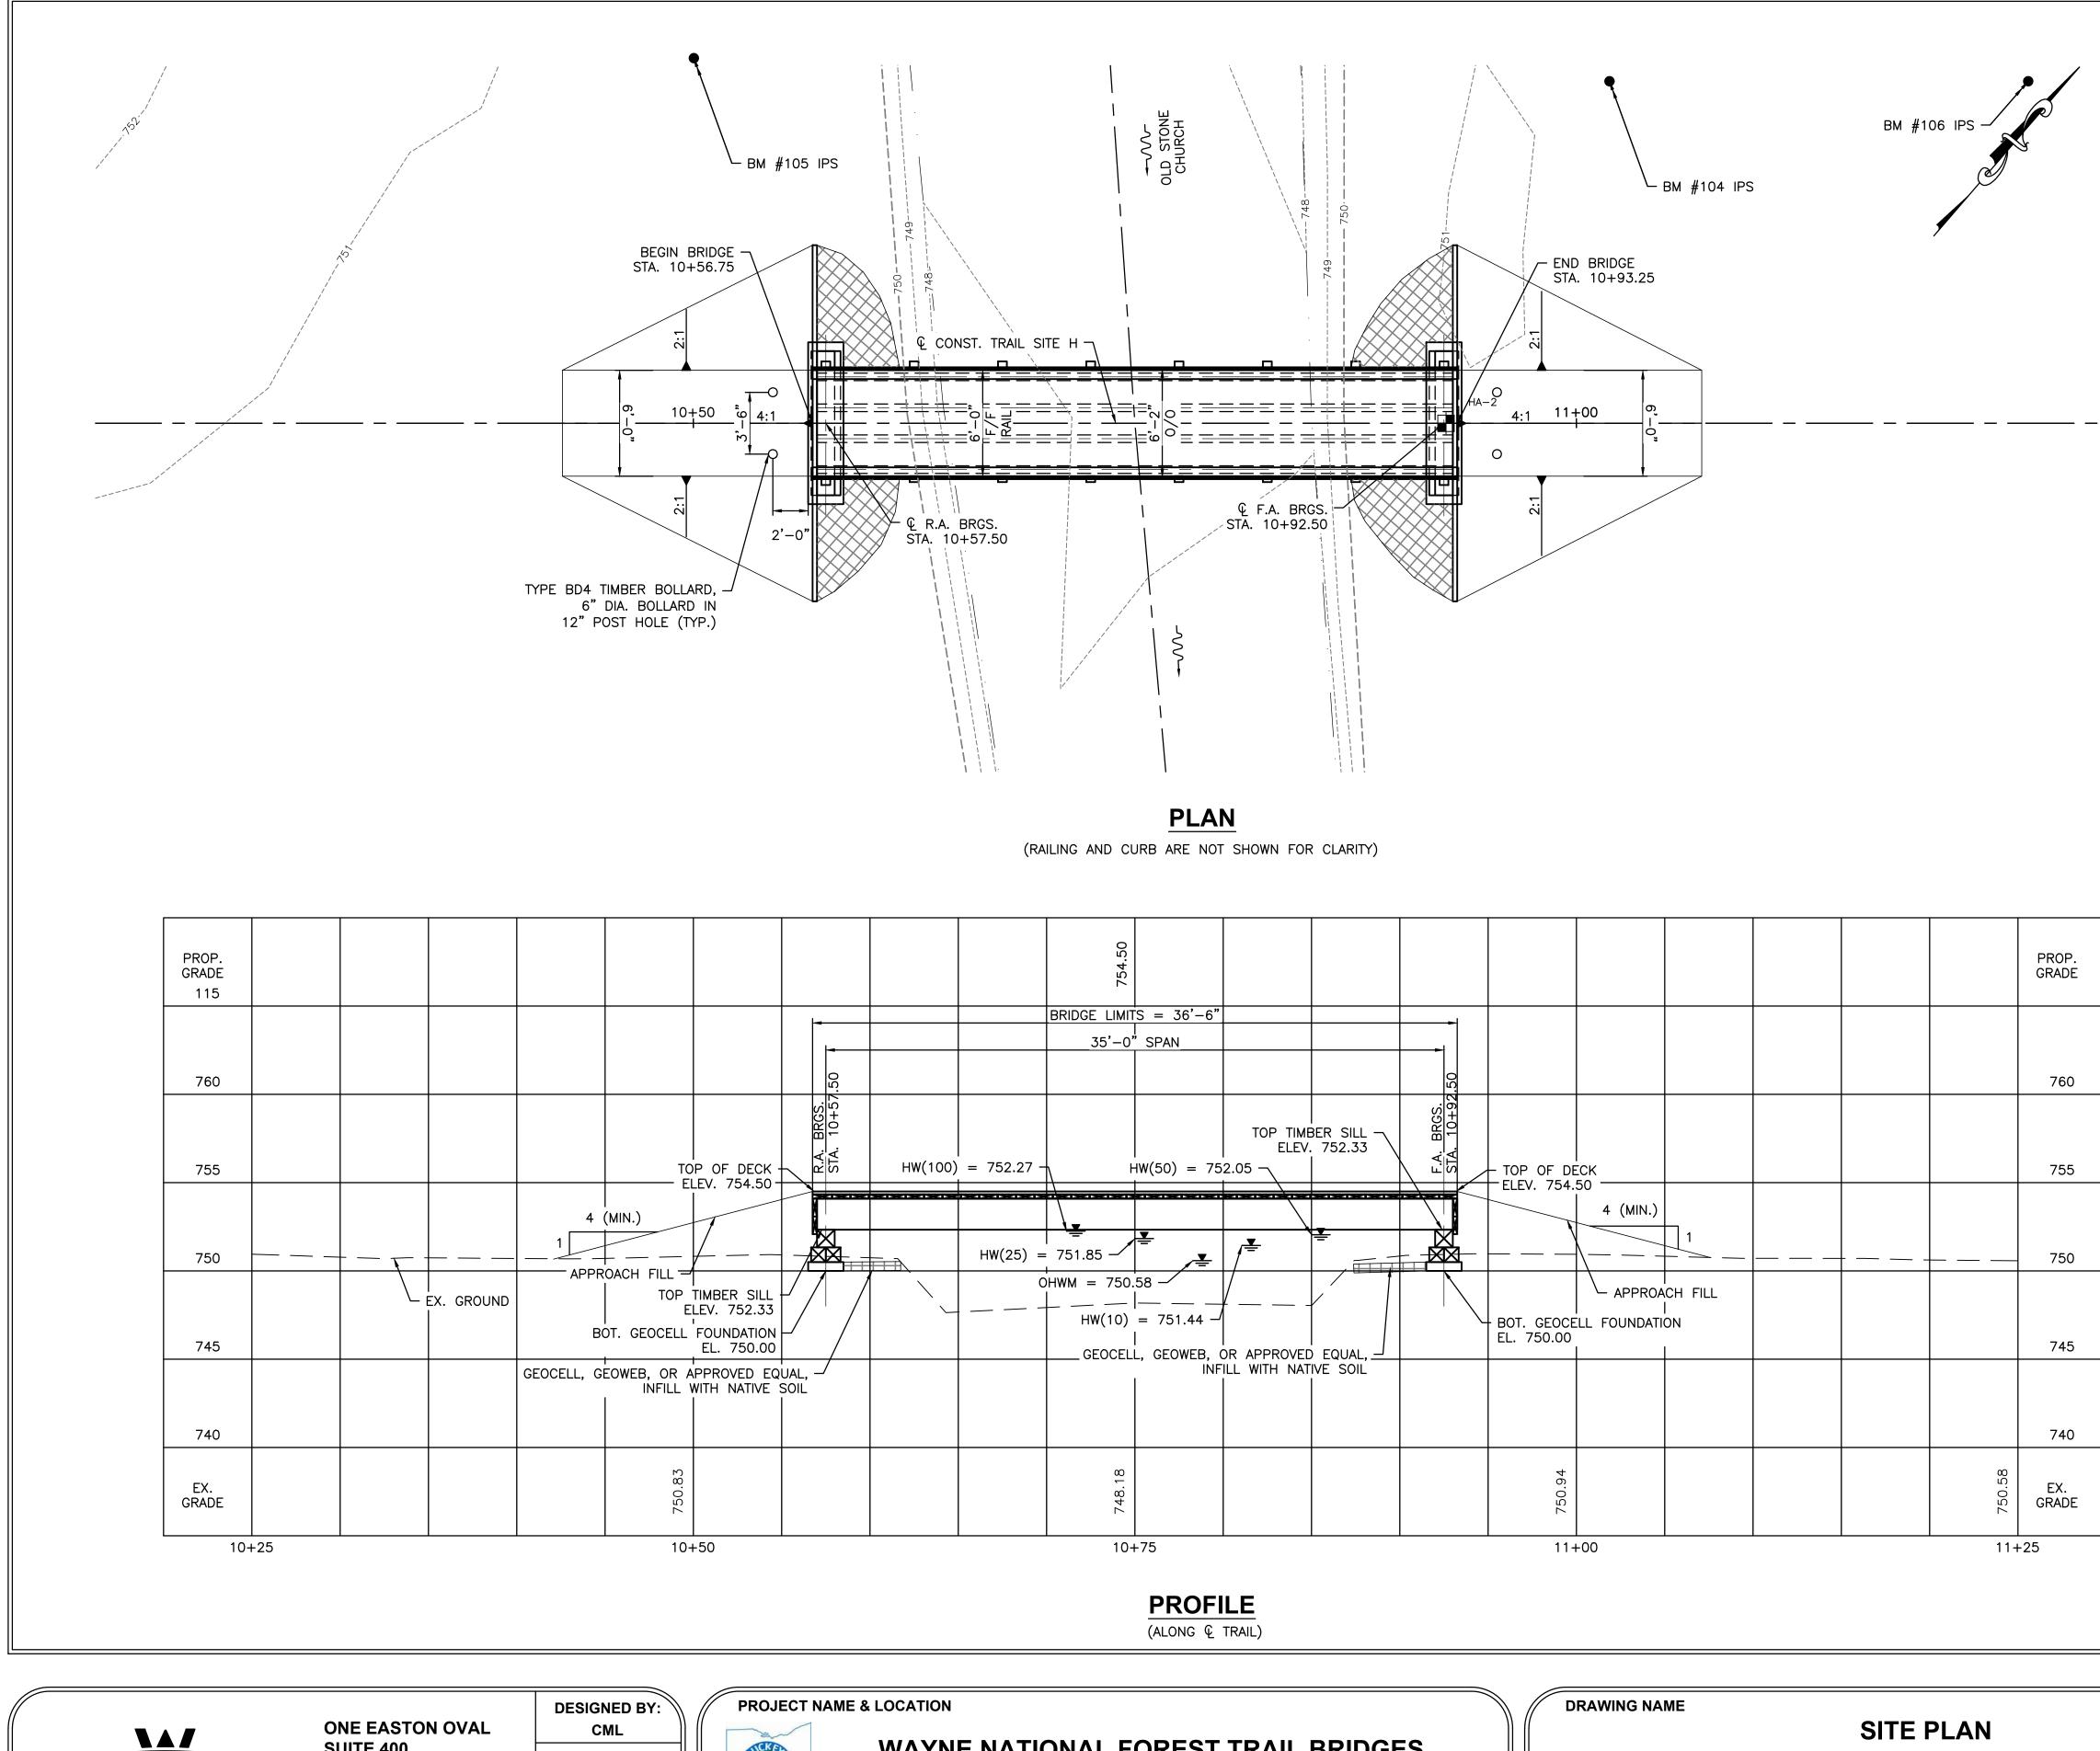

SUITE 400 COLUMBUS, OH 43219 T 614-476-6000 F 614-476-6225 WOOLPERT

**CHECKED BY:** MJZ **REVIEWED BY:** TML

my

# WAYNE NATIONAL FOREST TRAIL BRIDGES **BUCKEYE TRAILS ASSOCIATION**



BENCHMARK AND CONTROL DATA											
CONTROL POINT	DESCRIPTION	NORTHING	EASTING	ELEV.	STATION	OFFSET					
BM#100	IRON PIN	576829.572	2054105.708	10056.709							
BM#104	IRON PIN	586497.584	2038997.466	751.127	11+01.87	25.16' LT					
BM#105	IRON PIN	586481.565	2038942.822	750.91	10+50.02	48.71' LT					
BM#106	IRON PIN	586562.477	2039004.661	751.357	11+49.69	69.62' LT					
B.A.	BEGIN ALIGNMENT	586412.0099	2038936.734	SEE PROFILE	10+00.00	0					
CL R.A.	POINT ALONG ALIGNMENT	586449.5525	2038980.286	SEE PROFILE	10+57.50	0					
CL F.A.	POINT ALONG ALIGNMENT	586472.4045	2039006.797	SEE PROFILE	10+92.50	0					
F.A.	END ALIGNMENT	586509.9471	2039050.349	SEE PROFILE	11+50.00	0					

FOR ADDITIONAL BENCHMARK INFORMATION, SEE GENERAL NOTES SHEET 3/49.

#### LEGEND

BORING LOCATION

6" THICK GEOCELL ARMORING, FILLED WITH NATIVE SOIL (994.04). GEOCELL, GEOWEB, OR APPROVED EQUAL. INFILL SHALL BE INSTALLED IN ACCORDANCE WITH MANUFACTURER'S RECOMMENDATIONS.


### **HYDRAULIC DATA**


DRAINAGE AREA = $3.2$ SQ.	MILES	
Q (10) = 689 CFS	V (10) = 4.95 FT/S	DESIGN
Q (25) = 953 CFS	V (25) = 5.19 FT/S	SCOUR DESIGN
Q (50) = 1,170 CFS	V (50) = 5.63 FT/S	SCOUR CHECK
Q (100) = 1,410 CFS	V (100) = 6.03 FT/S	FEMA
STRUCTURE CLEARS THE 1	00-YEAR HIGH WATER ELEVATION	BY 0.07 FEET.


STRUCTURE IS NOT LOCATED IN FEMA REGULATED ZONE.

#### PROPOSED STRUCTURE


TYPE: THREE GLULAM STRINGER TRAIL BRIDGE ON STUB GEOCELL FOUNDATIONS. SPANS: 35'-0" C/C TIMBER SILL ROADWAY: 6'-0" F/F RAILING LOADING: 0.090 KSF PEDESTRIAN 1,000 LB EQUESTRIAN LOAD ON A 4"x4" SQUARE SKEW: NONE 39°36'36.00"N COORDINATES: LATITUDE LONGITUDE 82° 14' 58.92" W

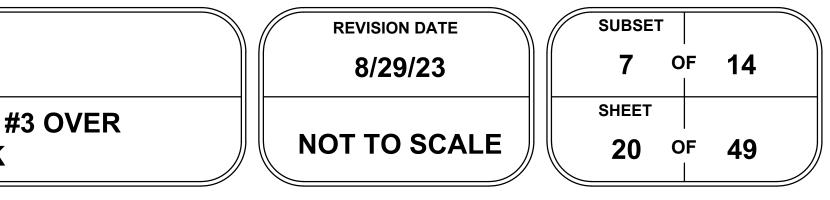

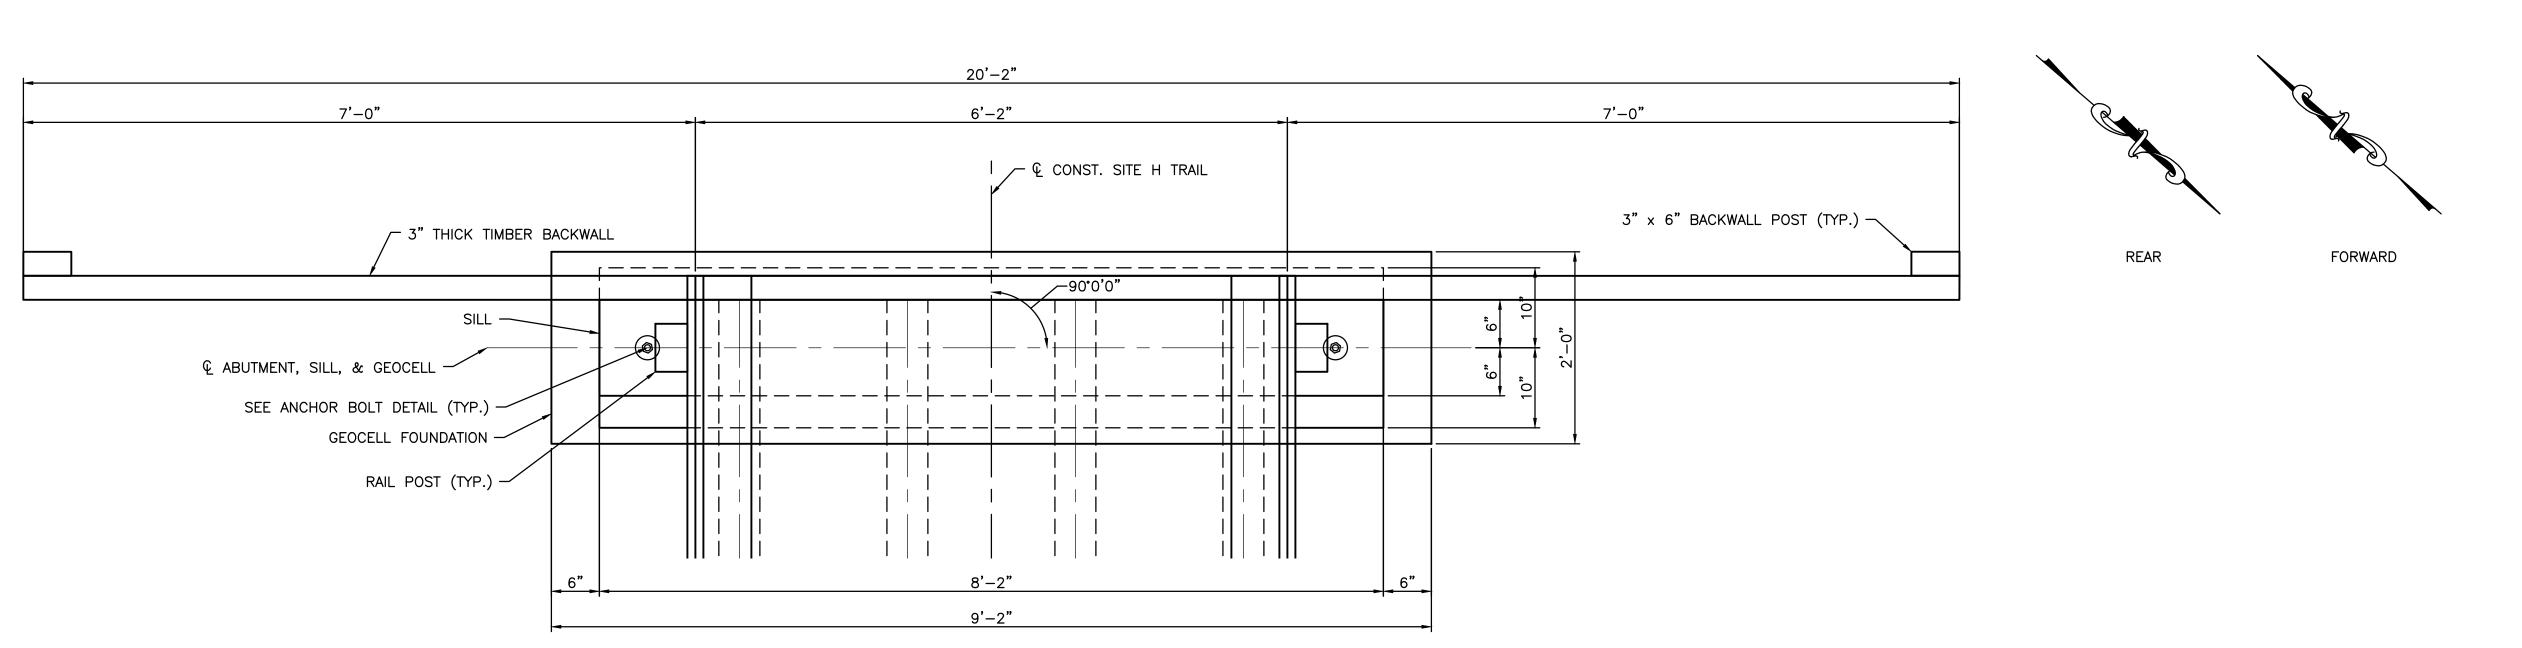

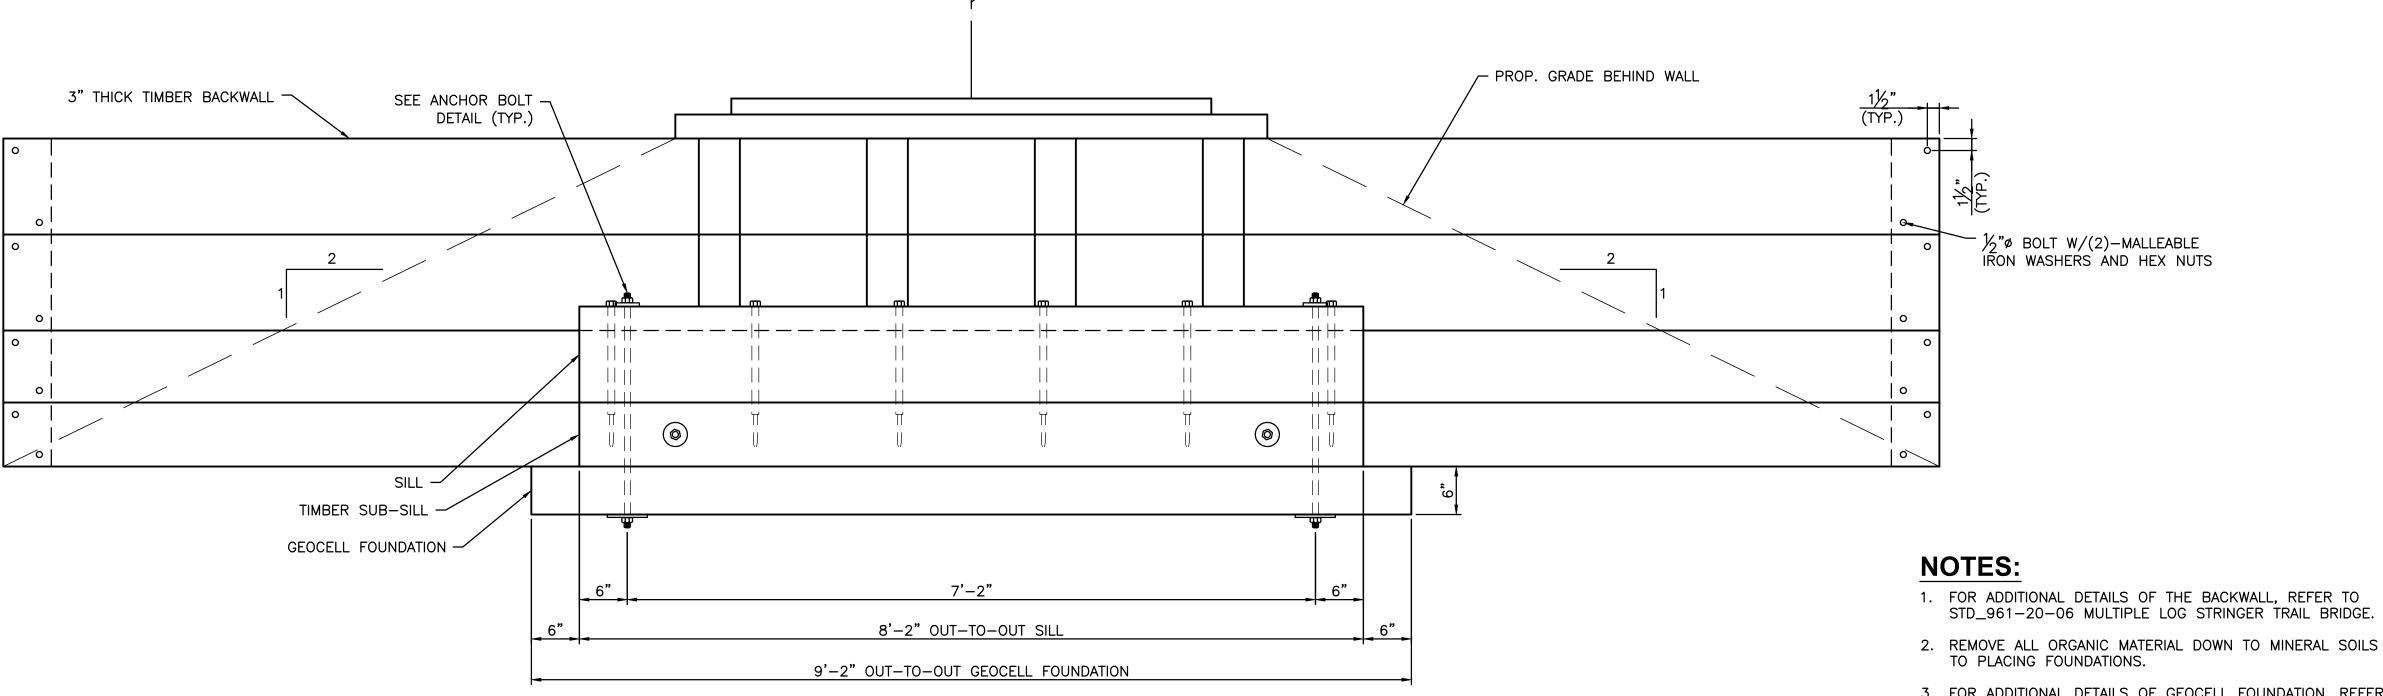

✓ € CONST. SITE H TRAIL

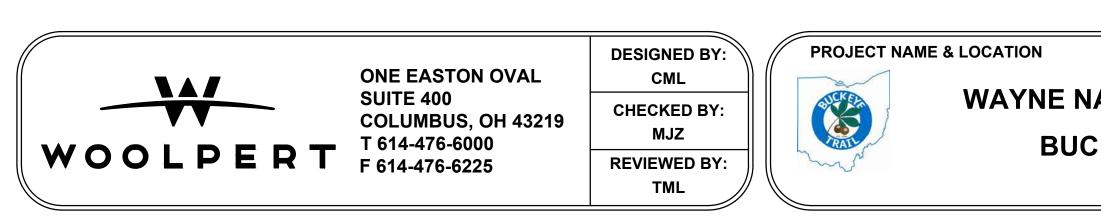

# WAYNE NATIONAL FOREST TRAIL BRIDGES **BUCKEYE TRAILS ASSOCIATION**


DRAWING NAME


**ABUTMENT PLAN AND ELEVATION** 


# **ABUTMENT ELEVATION**

### **ABUTMENT PLAN**

- 2. REMOVE ALL ORGANIC MATERIAL DOWN TO MINERAL SOILS PRIOR TO PLACING FOUNDATIONS.
- 3. FOR ADDITIONAL DETAILS OF GEOCELL FOUNDATION, REFER TO STD\_965-10-01 TIMBER SILL ON GEOCELL PAD.
- 4. PLACE NONWOVEN GEOTEXTILE FABRIC BEHIND BACKWALLS TO PREVENT SOIL INTRUSION.

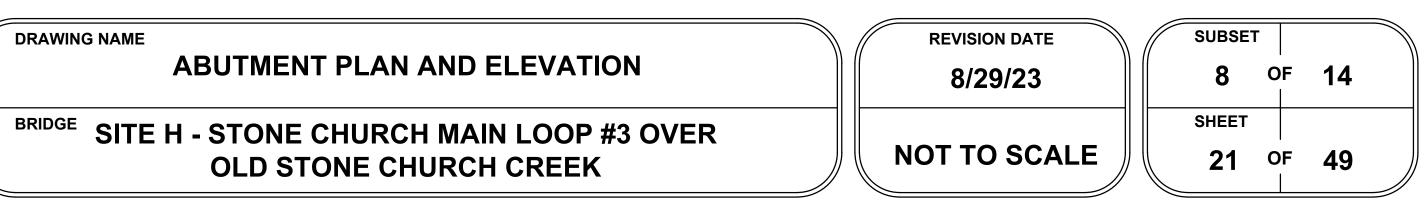

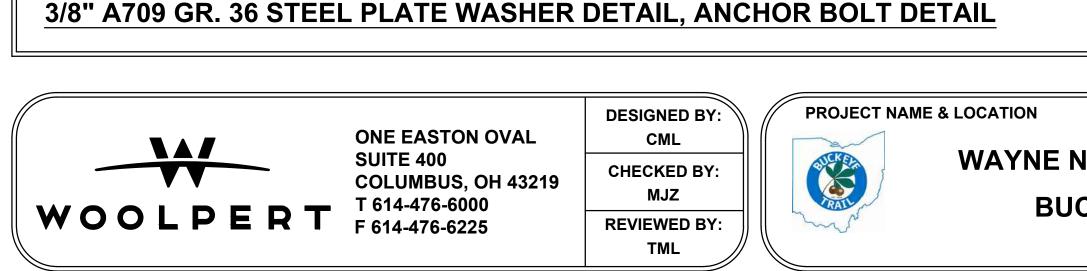

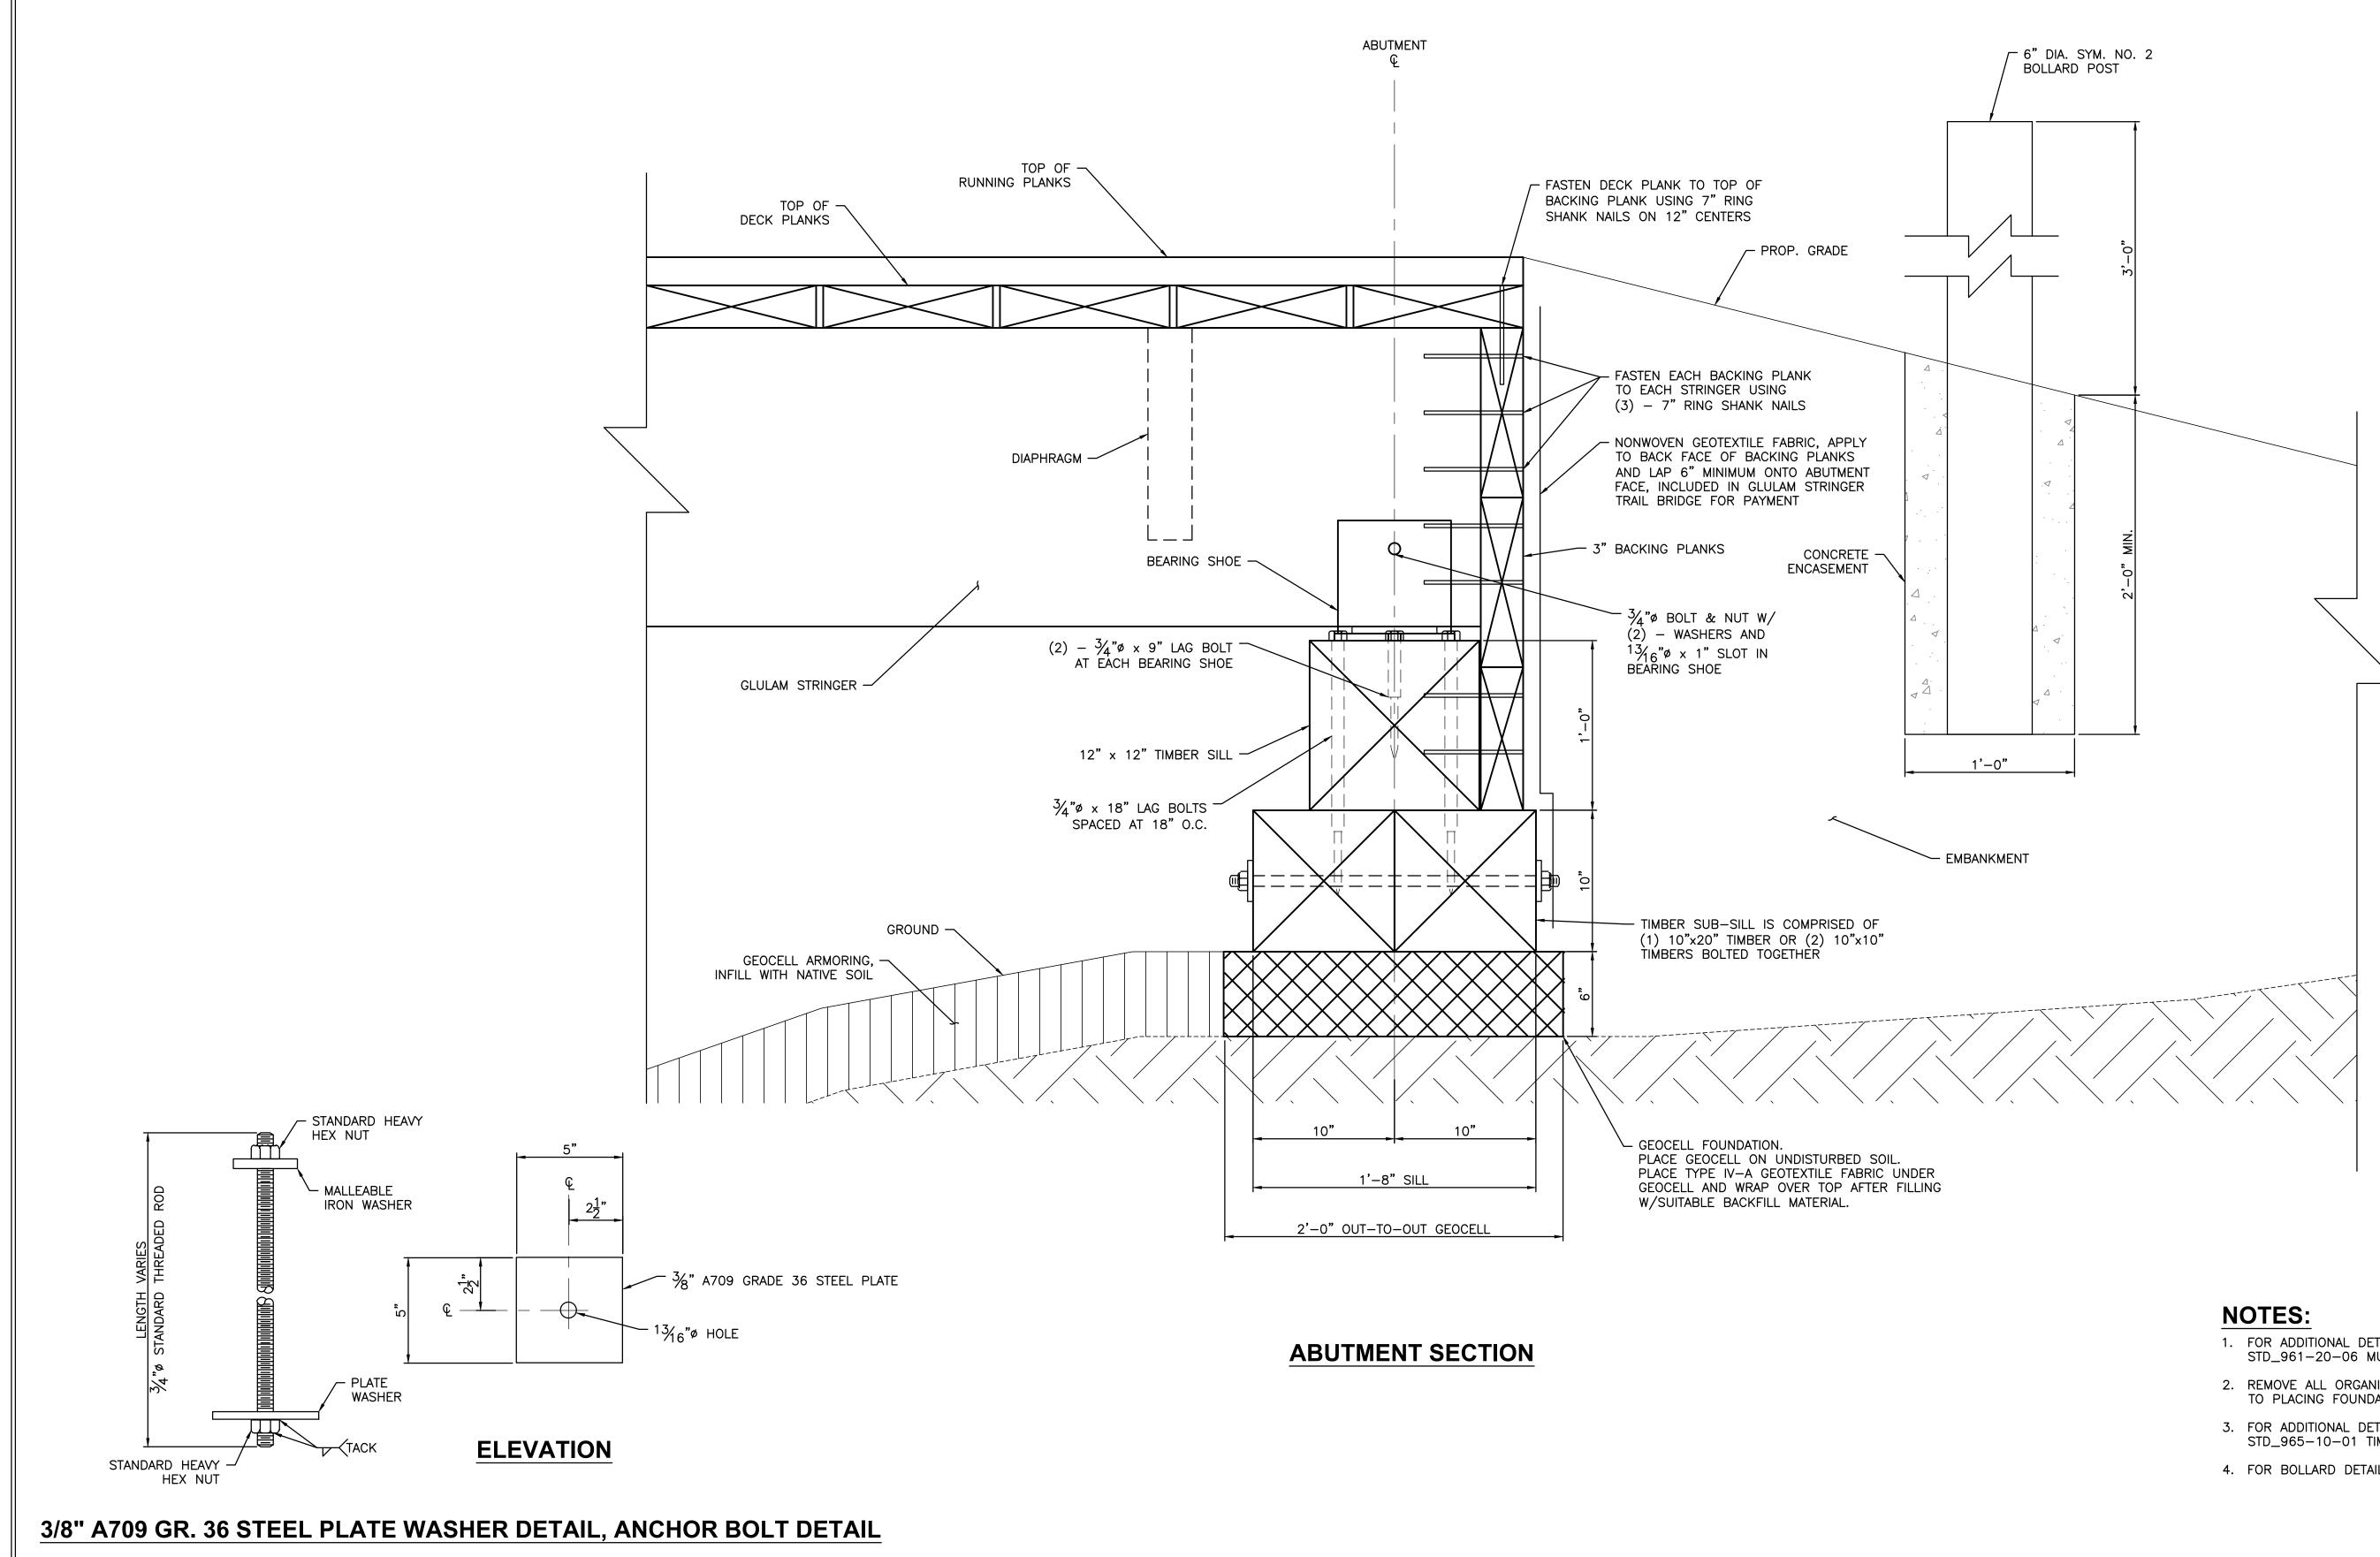


DRAWING NAME


WAYNE NATIONAL FOREST TRAIL BRIDGES **BUCKEYE TRAILS ASSOCIATION** 

**ABUTMENT SECTION AND BEARING DETAILS** 

BRIDGE SITE H - STONE CHURCH MAIN LOOP #3 OVER **OLD STONE CHURCH CREEK** 

- FOR ADDITIONAL DETAILS OF THE BACKWALL, REFER TO STD\_961-20-06 MULTIPLE LOG STRINGER TRAIL BRIDGE.
- 2. REMOVE ALL ORGANIC MATERIAL DOWN TO MINERAL SOILS PRIOR TO PLACING FOUNDATIONS.
- 3. FOR ADDITIONAL DETAILS OF GEOCELL FOUNDATION, REFER TO STD\_965-10-01 TIMBER SILL ON GEOCELL PAD.
- 4. FOR BOLLARD DETAILS, REFER TO STD\_945-10-01.

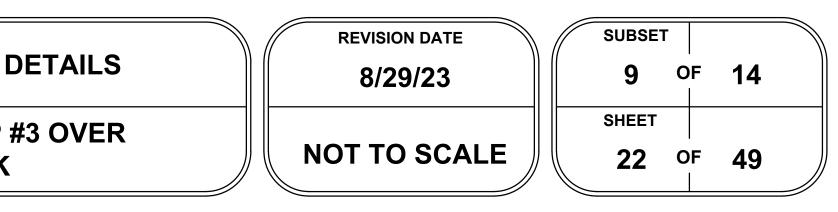

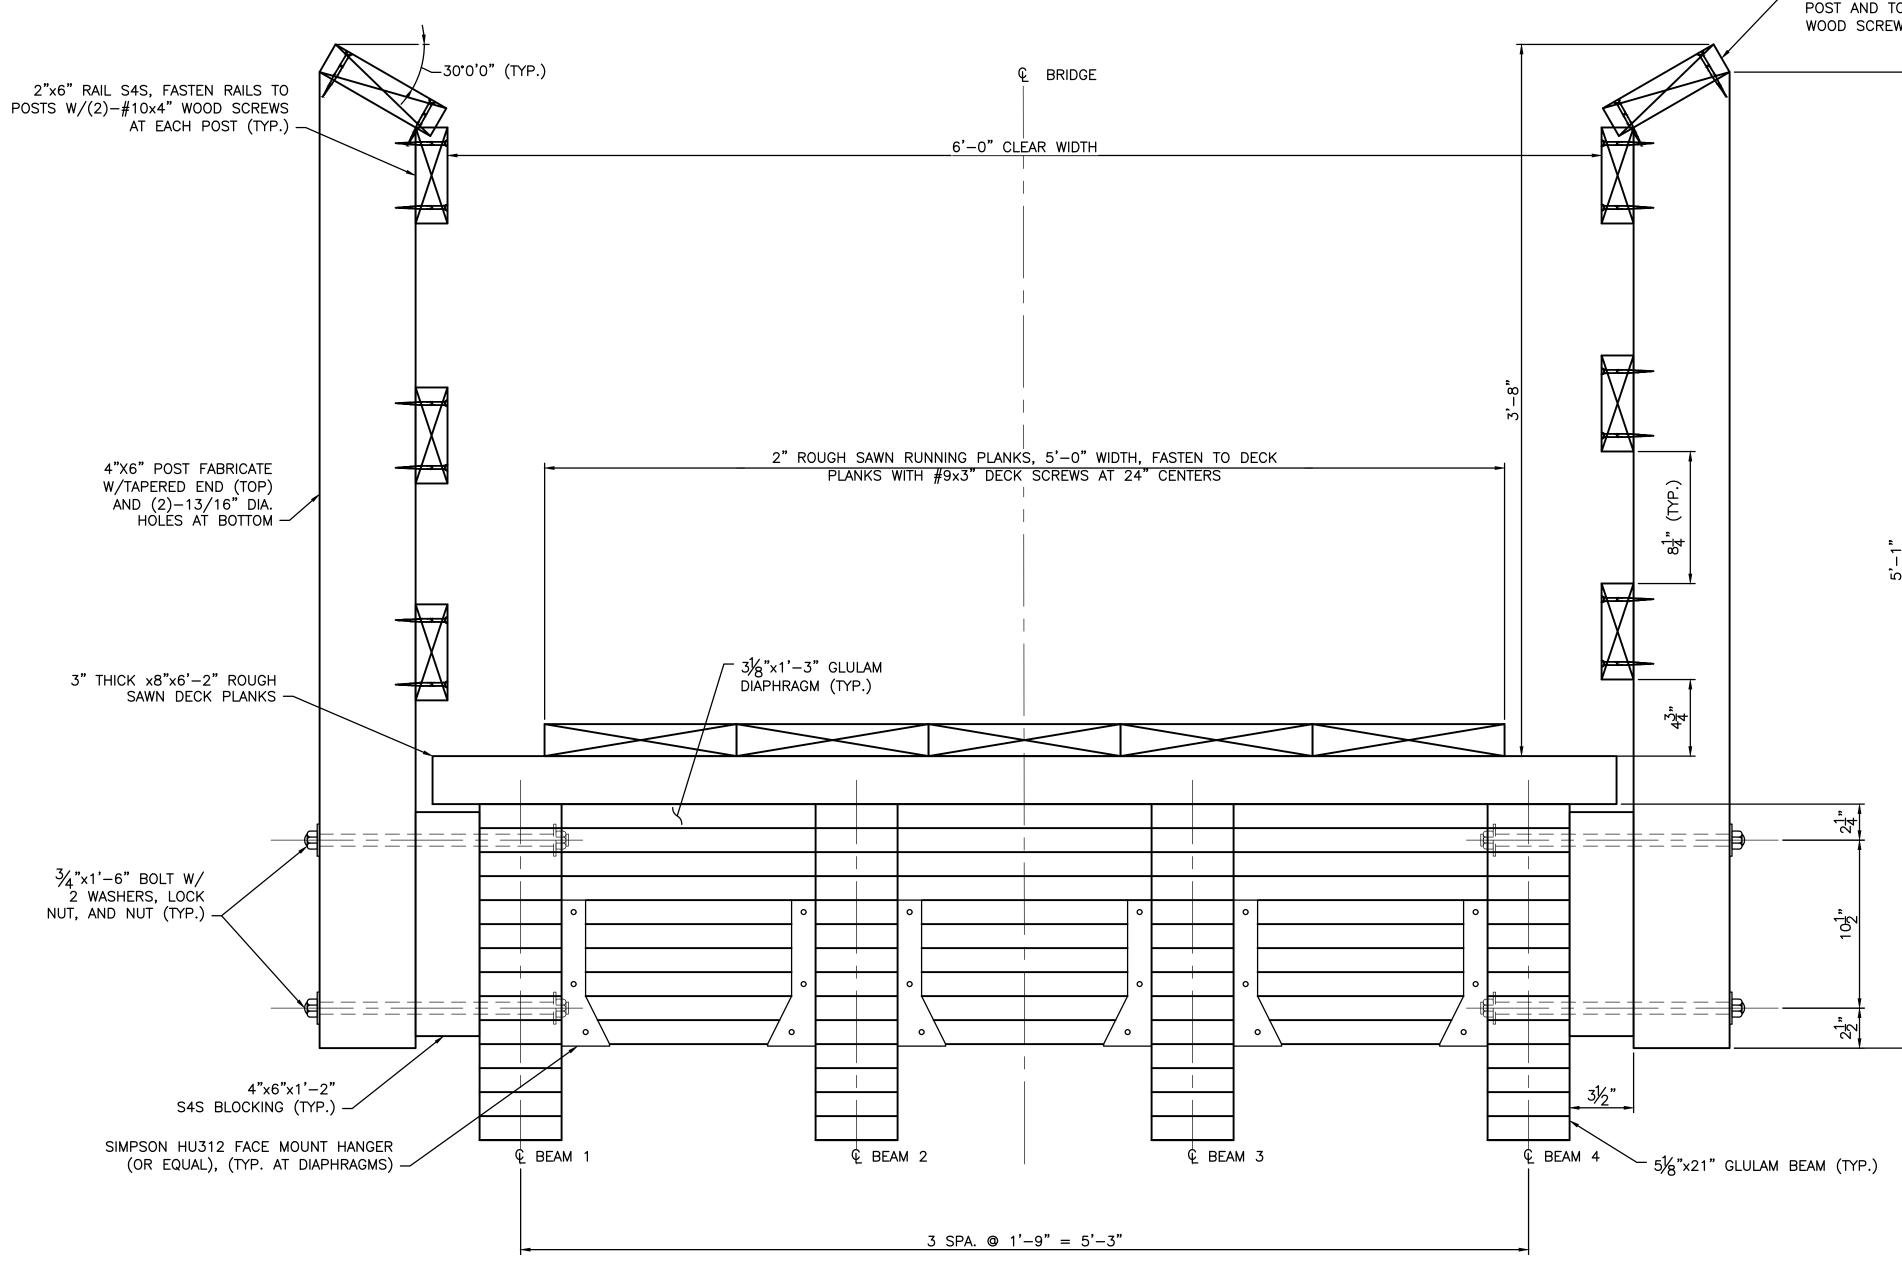




# **TRANSVERSE SECTION**


WAYNE NATIONAL FOREST TRAIL BRIDGES **BUCKEYE TRAILS ASSOCIATION** 


DRAWING NAME


#### **TRANSVERSE SECTION**

BRIDGE SITE H - STONE CHURCH MAIN LOOP #3 OVER **OLD STONE CHURCH CREEK** 

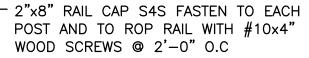

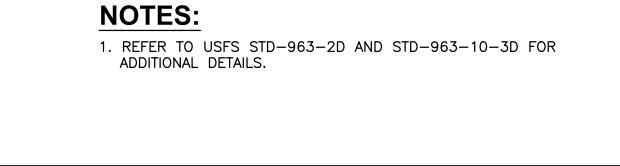

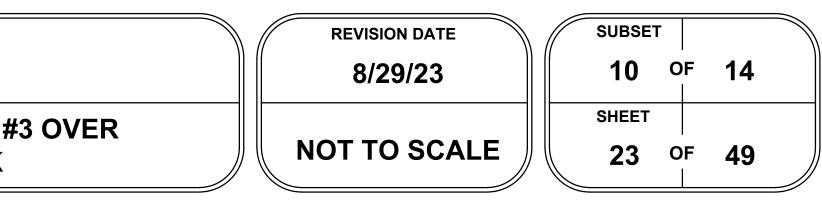

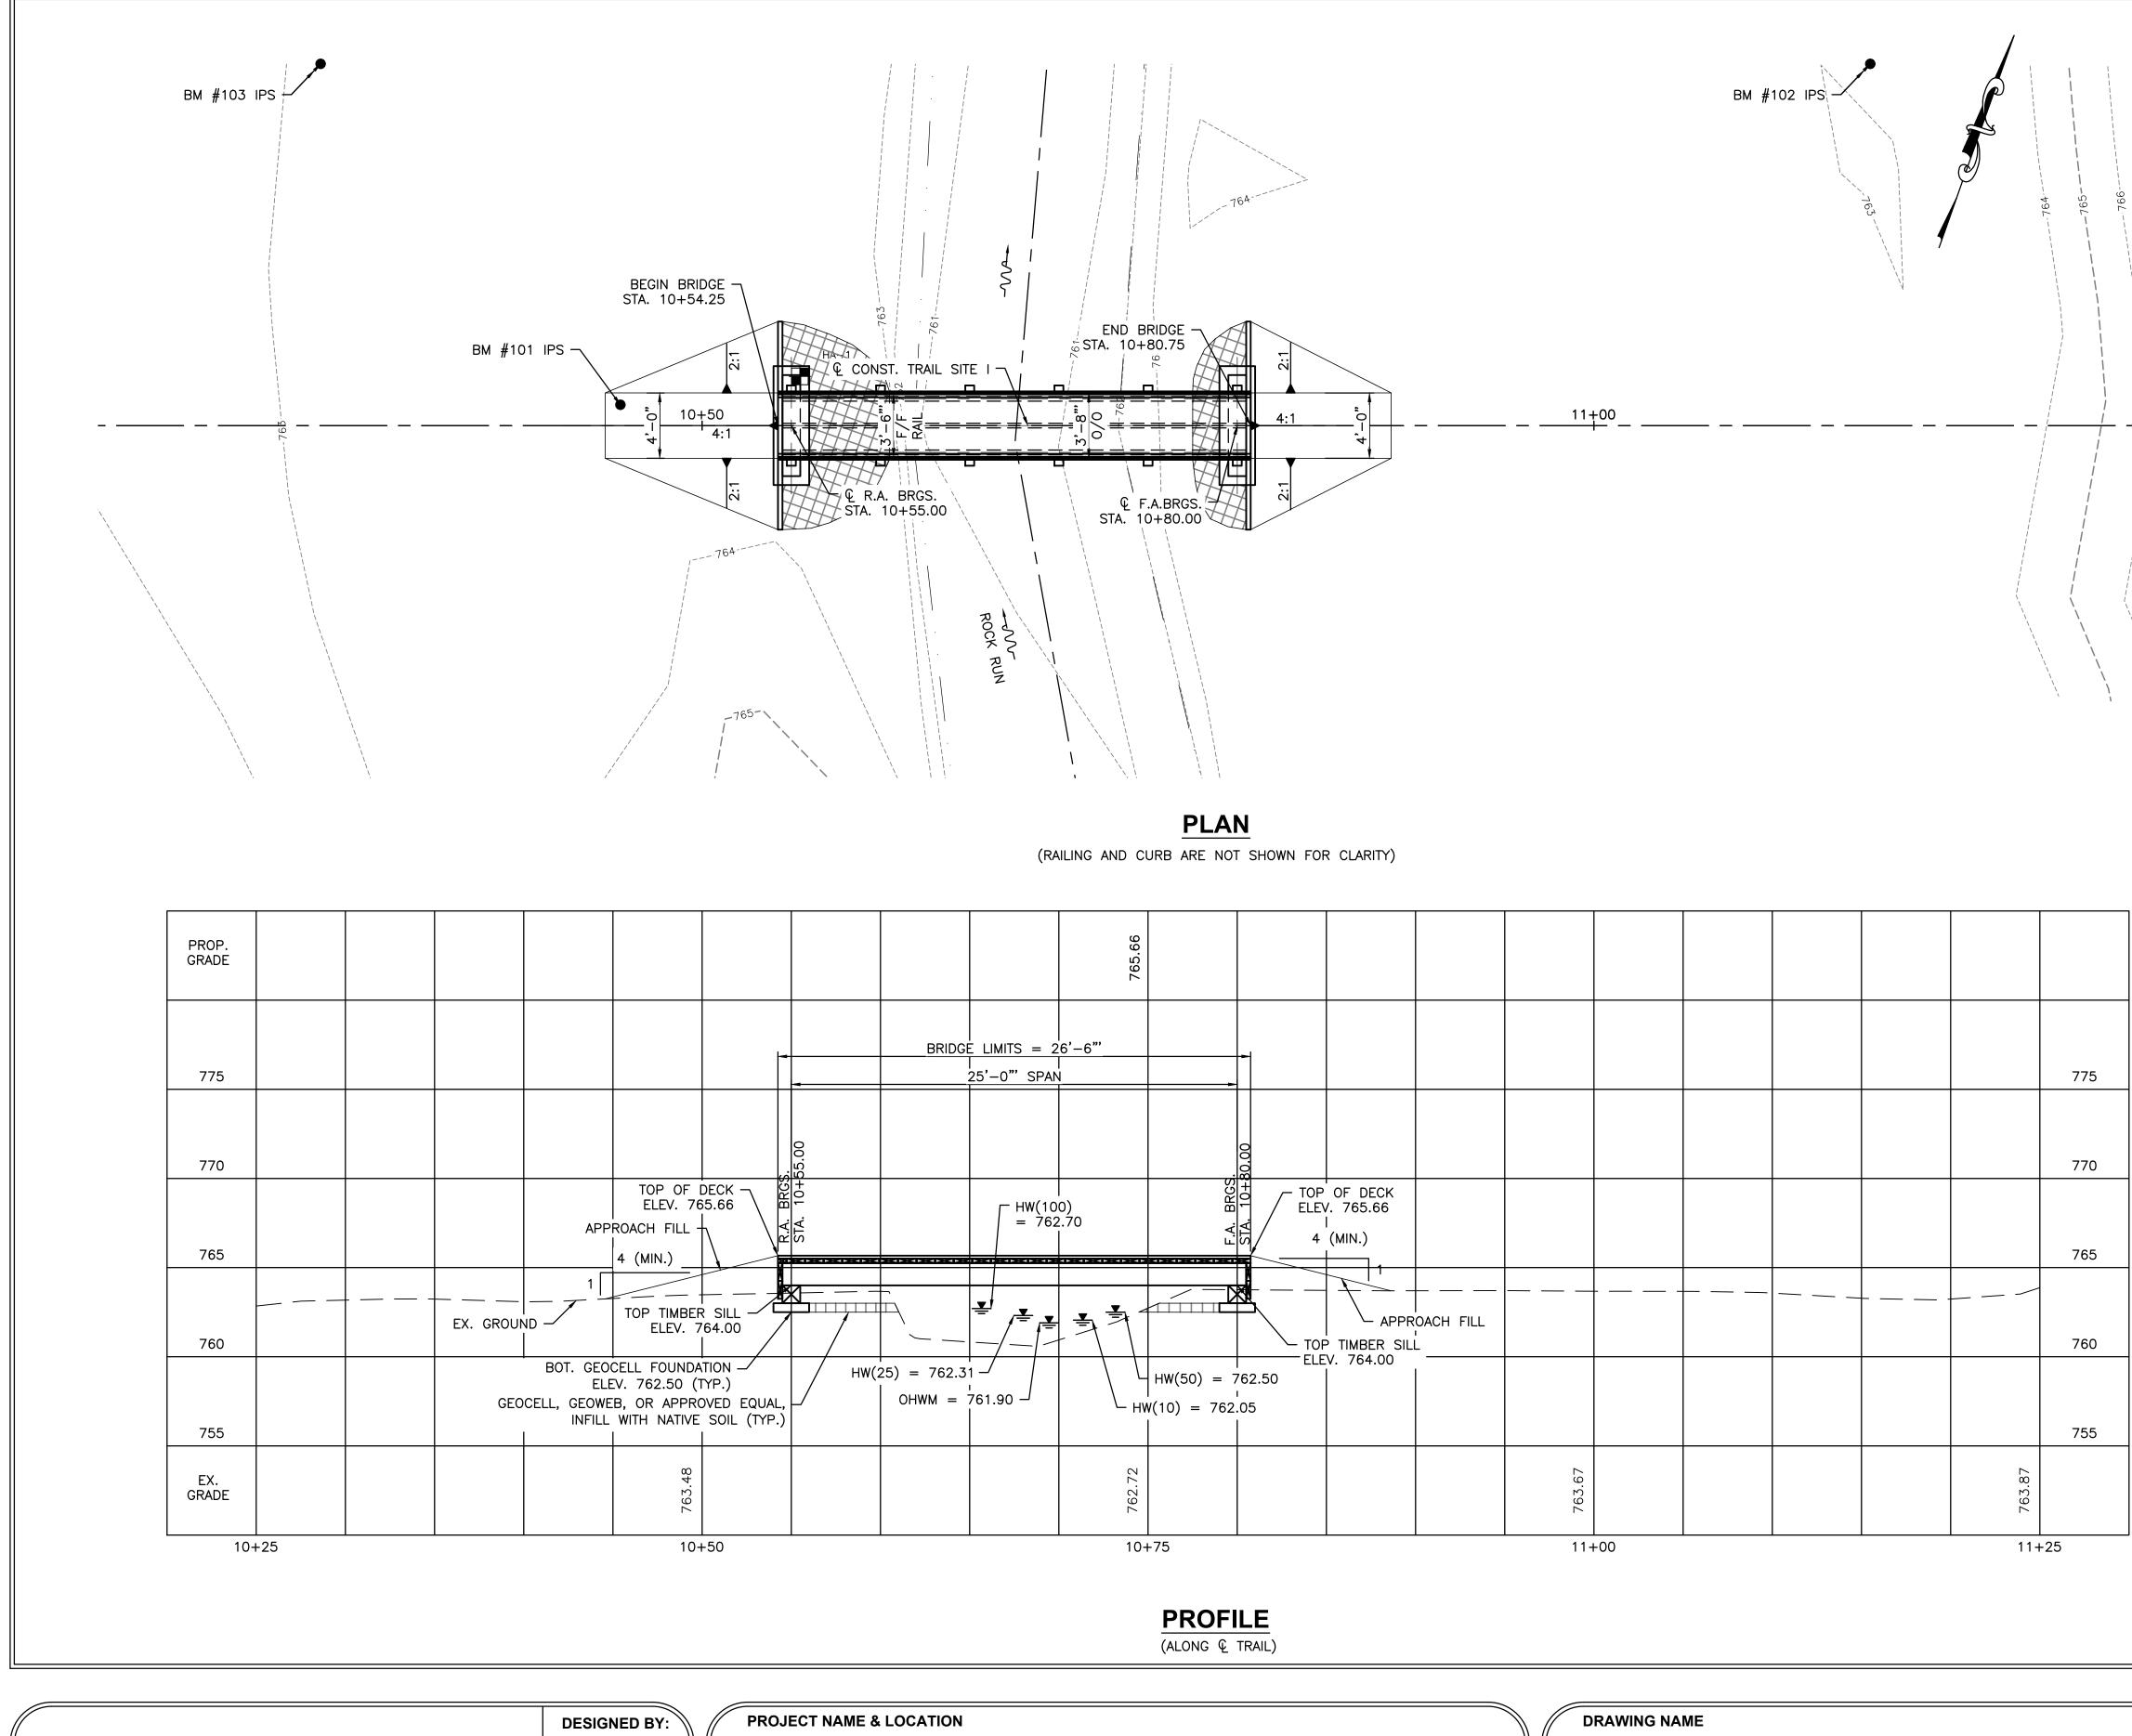

ONE EASTON OVAL SUITE 400 COLUMBUS, OH 43219 T 614-476-6000 F 614-476-6225 WOOLPERT

CML CHECKED BY: TML **REVIEWED BY:** MJZ

my

WAYNE NATIONAL FOREST TRAIL BRIDGES **BUCKEYE TRAILS ASSOCIATION** 

BRIDGE

#### SITE PLAN

SITE I - NCT ATHENS CENTRAL #4 OVER ROCK RUN

BENCHMARK DATA										
CONTROL POINT	DESCRIPTION	NORTHING	EASTING	ELEV.	STATION	OFFSET				
BM#101	IRON PIN	583949.536	2042450.409	764.013	10+45.42	1.17' LT				
BM#102	IRON PIN	584027.594	2042497.238	763.66	11+15.58	59.16' LT				
BM#103	IRON PIN	584026.548	2042408.304	763.191	10+31.39	87.81' LT				
B.A.	BEGIN ALIGNMENT	583933.299	2042407.977	SEE PROFILE	10+00.00	0				
CL R.A.	POINT ALONG ALIGNMENT	583951.631	2042459.837	SEE PROFILE	10+55.00	0				
CL F.A.	POINT ALONG ALIGNMENT	583959.963	2042483.407	SEE PROFILE	10+80.00	0				
F.A.	END ALIGNMENT	583978.291	2042535.259	SEE PROFILE	11+35.00	0				

FOR ADDITIONAL BENCHMARK INFORMATION, SEE GENERAL NOTES SHEET 3/49.

#### LEGEND

BORING LOCATION

6" THICK GEOCELL ARMORING, FILLED WITH NATIVE SOIL (994.04). GEOCELL, GEOWEB, OR APPROVED EQUAL. INFILL SHALL BE INSTALLED IN ACCORDANCE WITH MANUFACTURER'S RECOMMENDATIONS.


#### HYDRAULIC DATA


DRAINAGE AREA = $0.0504$ S	SQ. MILES	
Q(10) = 40.2  CFS	V (10) = 3.39 FT/S	DESIGN
Q(25) = 58.6  CFS	V (25) = 3.83 FT/S	SCOUR DESIGN
Q(50) = 74.3  CFS	V (50) = 4.16 FT/S	SCOUR CHECK
Q(100) = 91.7  CFS	V (100) = 4.46 FT/S	FEMA


STRUCTURE CLEARS THE 100-YEAR HIGH WATER ELEVATION BY 0.30 FEET. STRUCTURE IS NOT LOCATED IN FEMA REGULATED ZONE.


#### PROPOSED STRUCTURE

TYPE: THREE GLULAM STRINGER TRAIL BRIDGE ON STUB GEOCELL FOUNDATIONS. SPANS: 25'-0" C/C TIMBER SILL ROADWAY: 3'-8" F/F RAILING LOADING: 0.090 KSF PEDESTRIAN SKEW: NONE LATITUDE 39° 34' 17" N LONGITUDE 82° 01' 53" W COORDINATES: LATITUDE

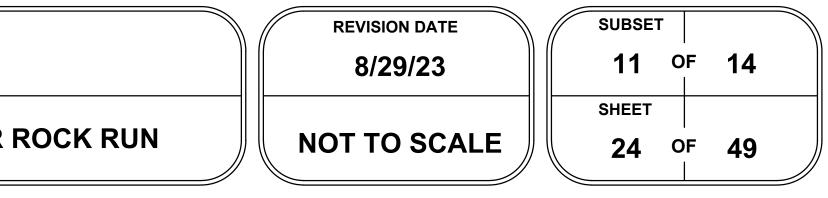

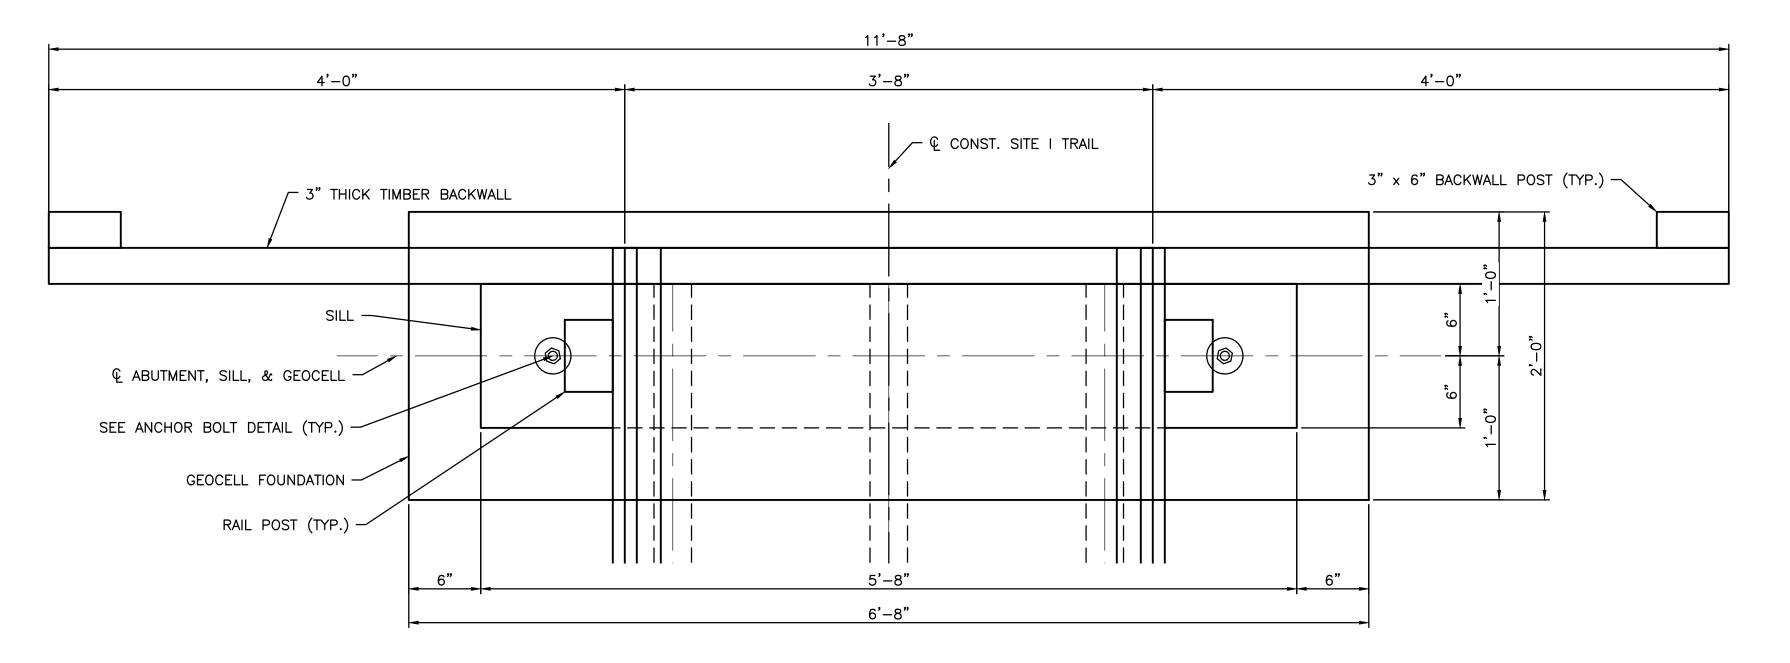

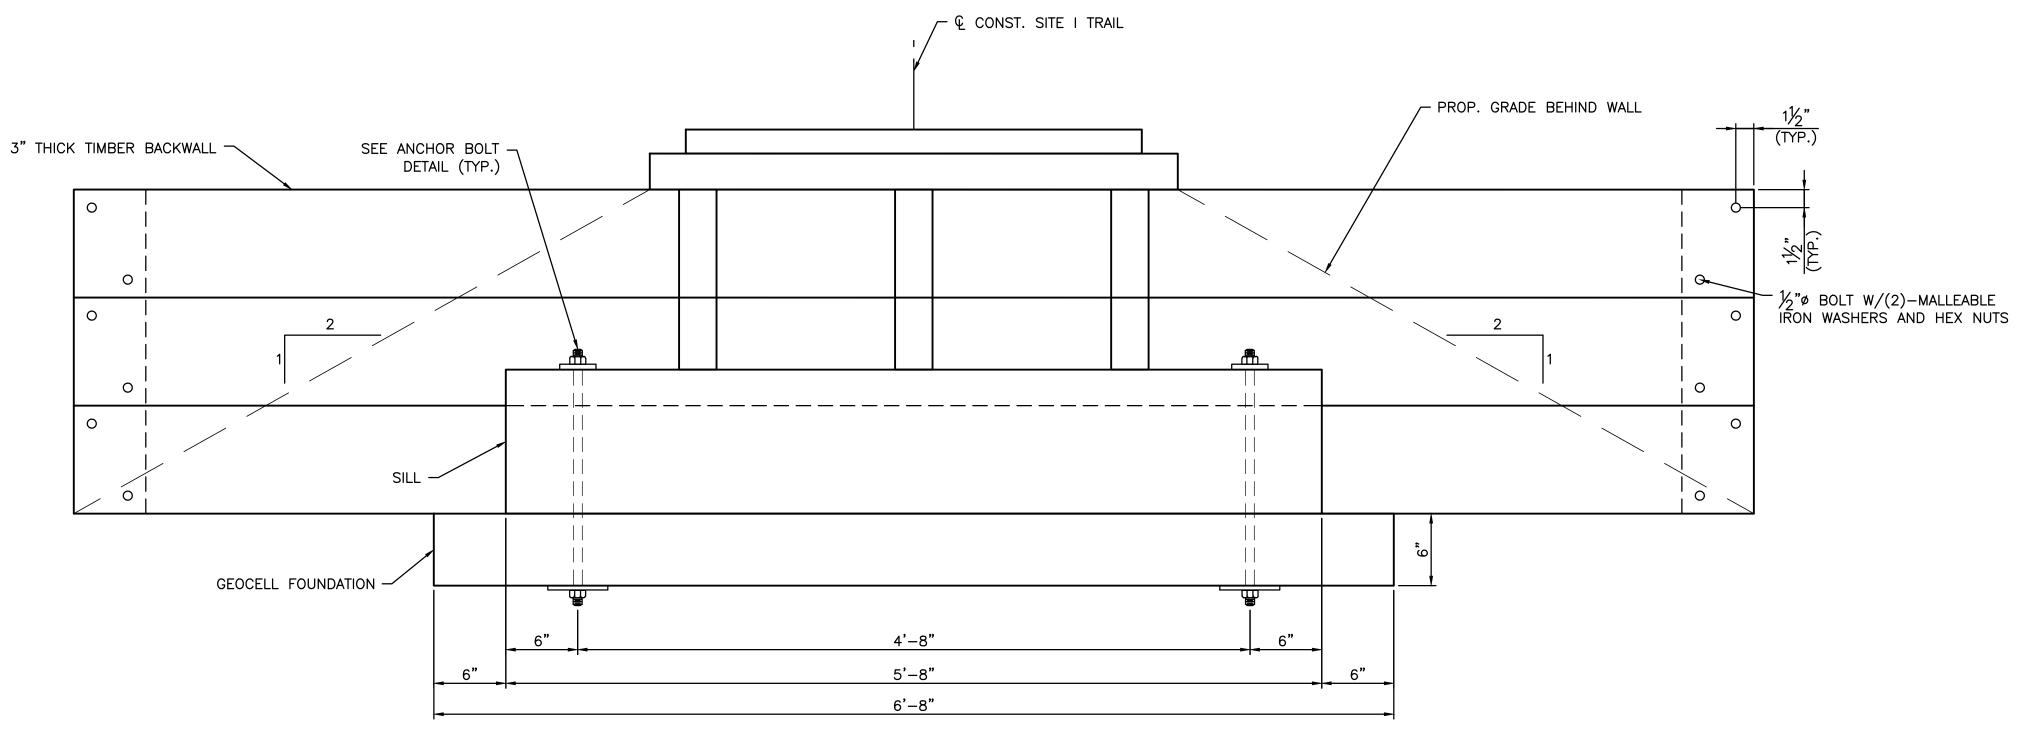

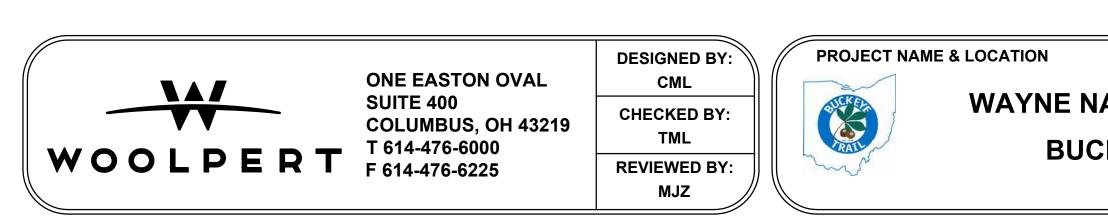

### **ABUTMENT PLAN**

### **ABUTMENT ELEVATION**


# WAYNE NATIONAL FOREST TRAIL BRIDGES **BUCKEYE TRAILS ASSOCIATION**

**ABUTMENT PLAN AND ELEVATION** 


SITE I - NCT ATHENS CENTRAL #4 OVER ROCK RUN


DRAWING NAME

BRIDGE

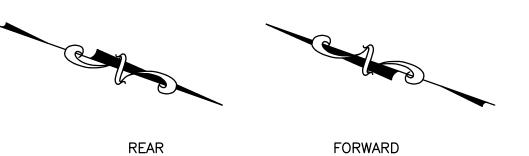



# **NOTES:** FOR ADDITIONAL DETAILS OF THE BACKWALL, REFER TO STD\_961-20-06 MULTIPLE LOG STRINGER TRAIL BRIDGE. 2. REMOVE ALL ORGANIC MATERIAL DOWN TO MINERAL SOILS PRIOR TO PLACING FOUNDATIONS. 3. FOR ADDITIONAL DETAILS OF GEOCELL FOUNDATION, REFER TO STD\_965-10-01 TIMBER SILL ON GEOCELL PAD. 4. PLACE NONWOVEN GEOTEXTILE FABRIC BEHIND BACKWALLS TO PREVENT SOIL INTRUSION. SUBSET **REVISION DATE** OF **14** 12 8/29/23 SHEET

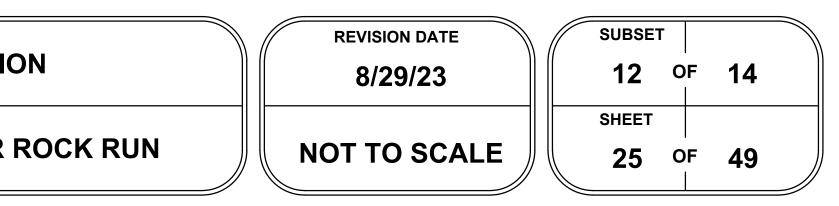

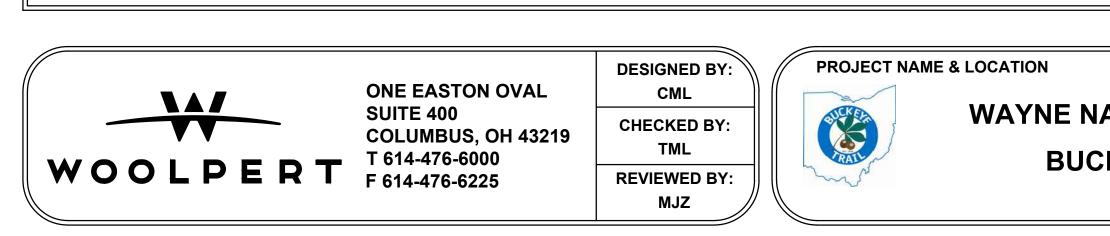


# 3/8" A709 GR. 36 STEEL PLATE WASHER DETAIL, ANCHOR BOLT DETAIL

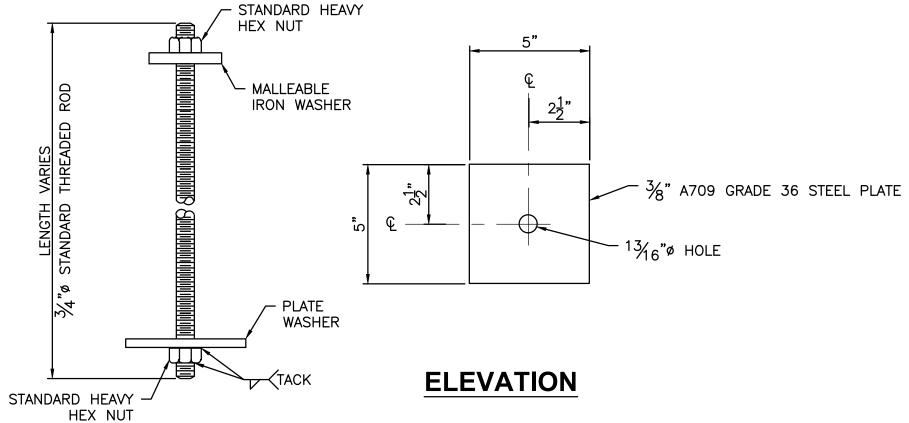

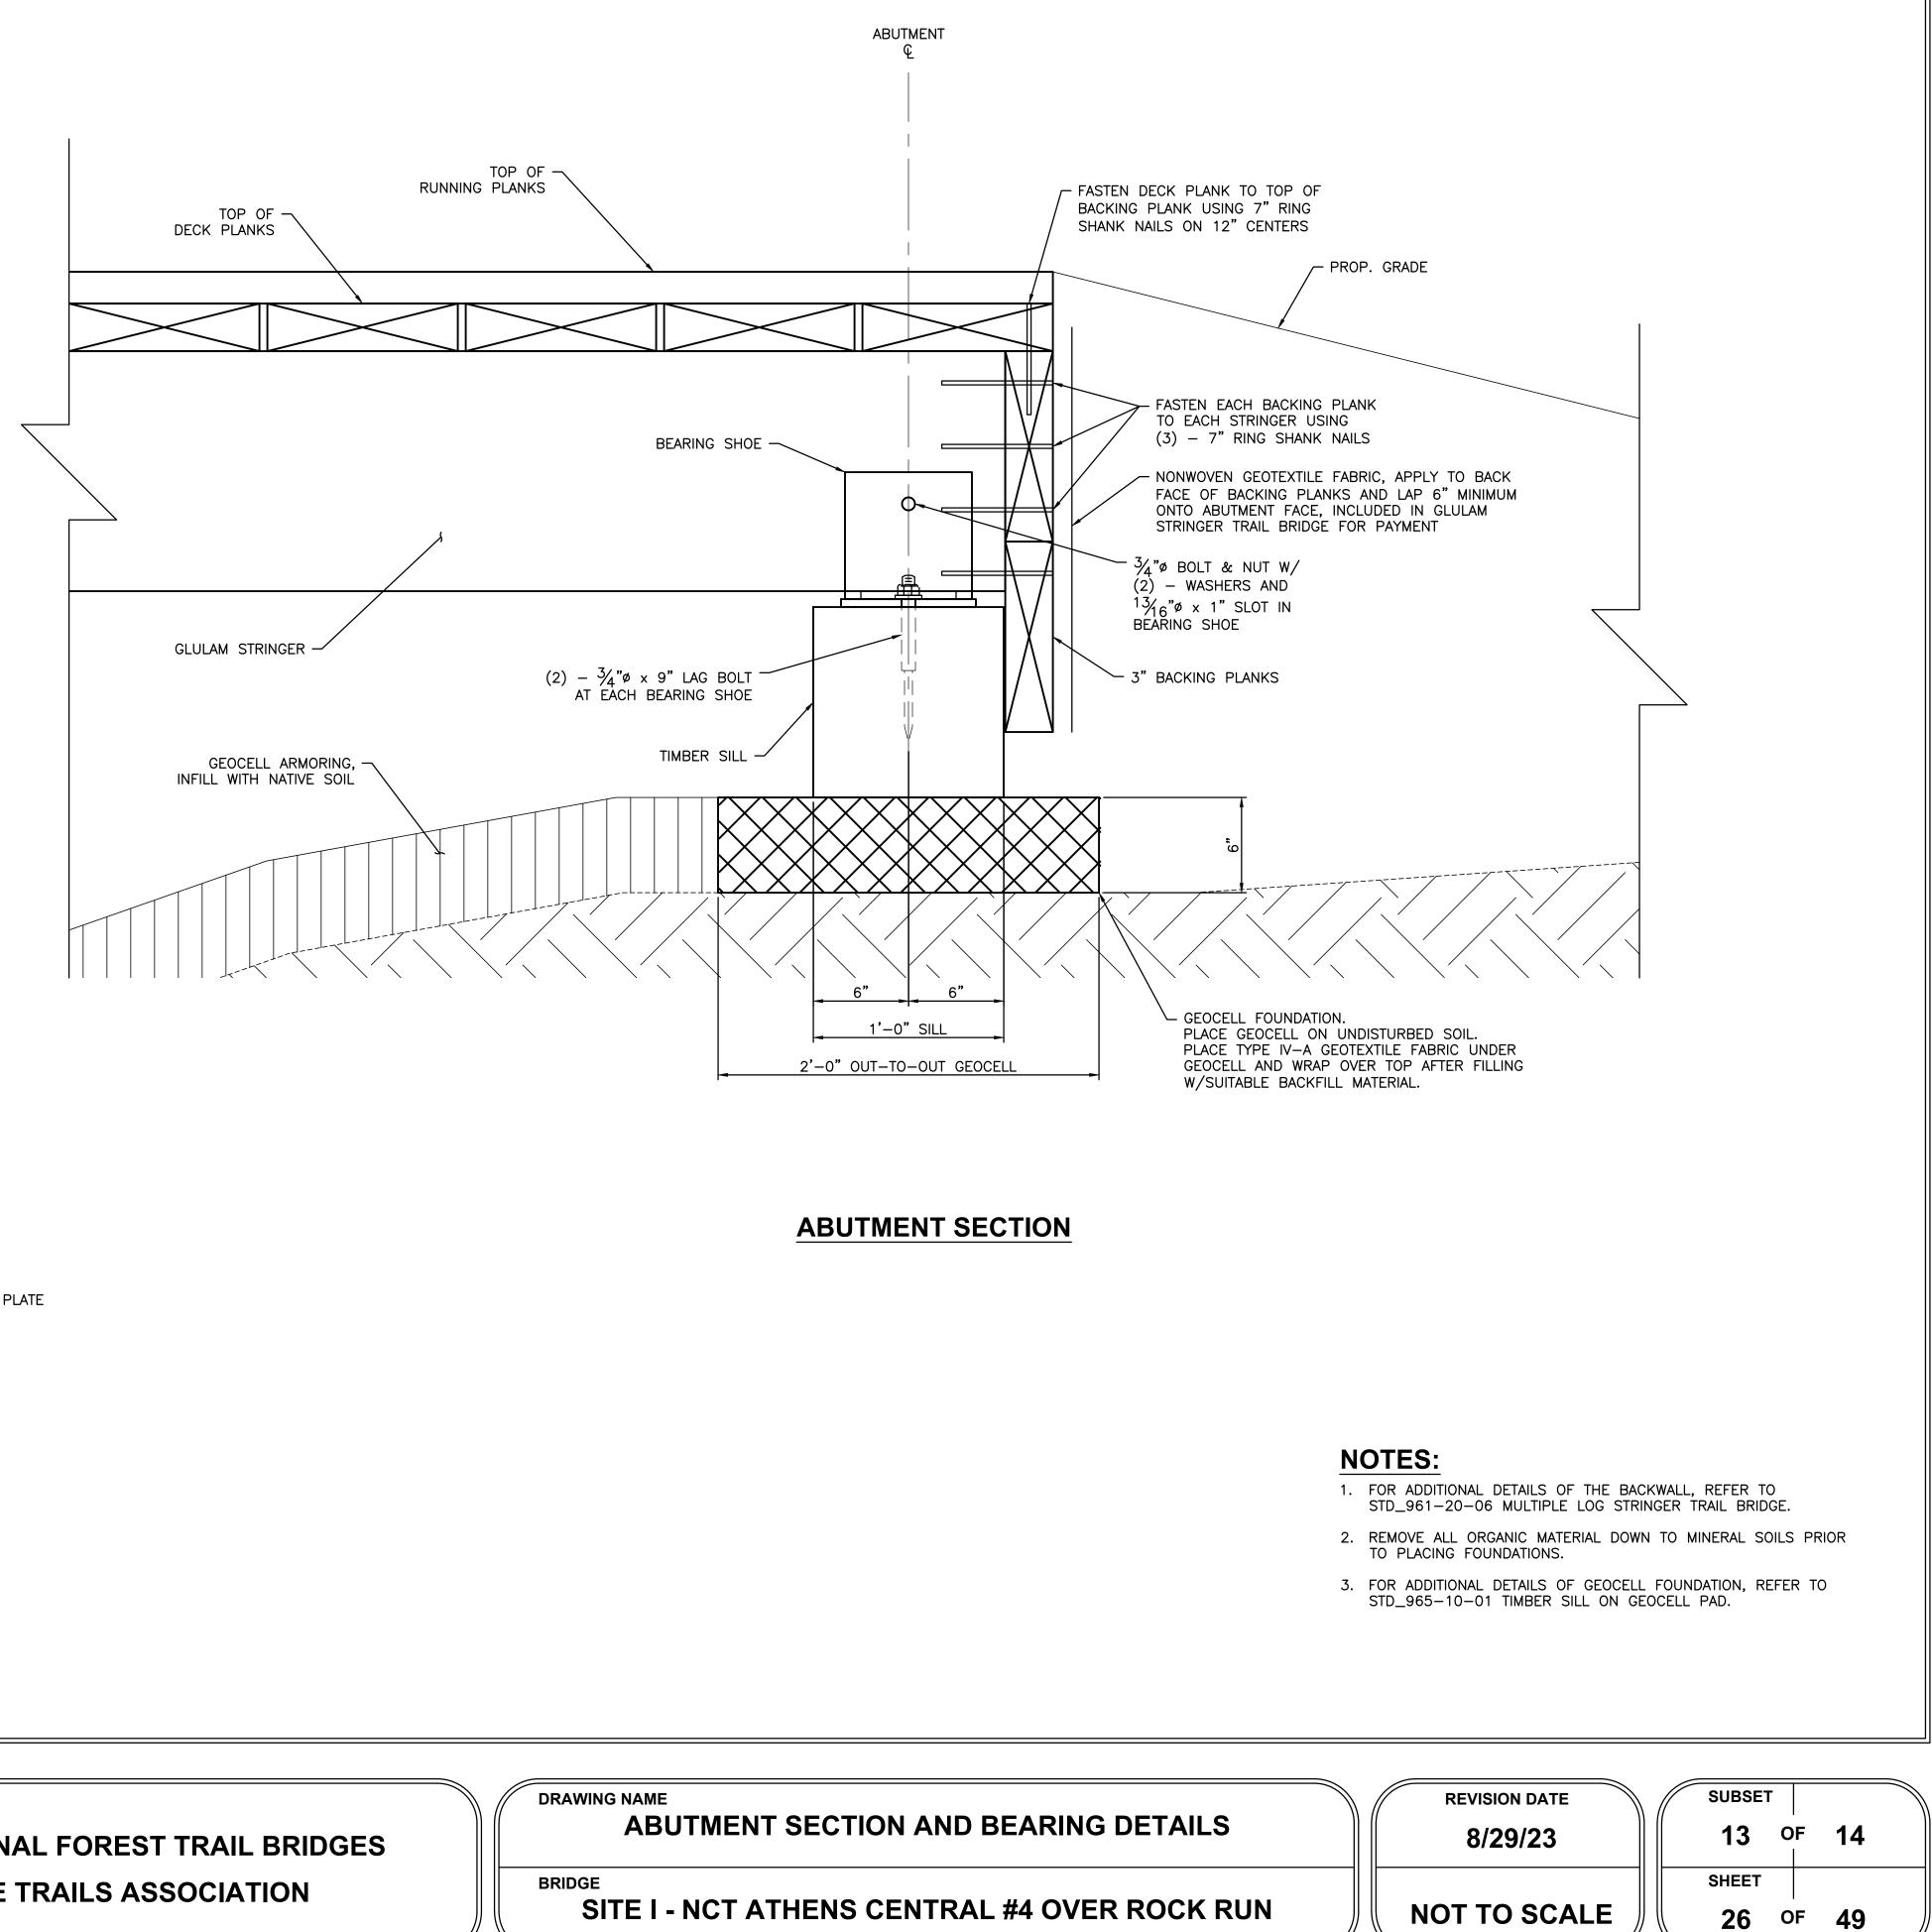

WAYNE NATIONAL FOREST TRAIL BRIDGES **BUCKEYE TRAILS ASSOCIATION** 

SITE I - NCT ATHENS CENTRAL #4 OVER ROCK RUN

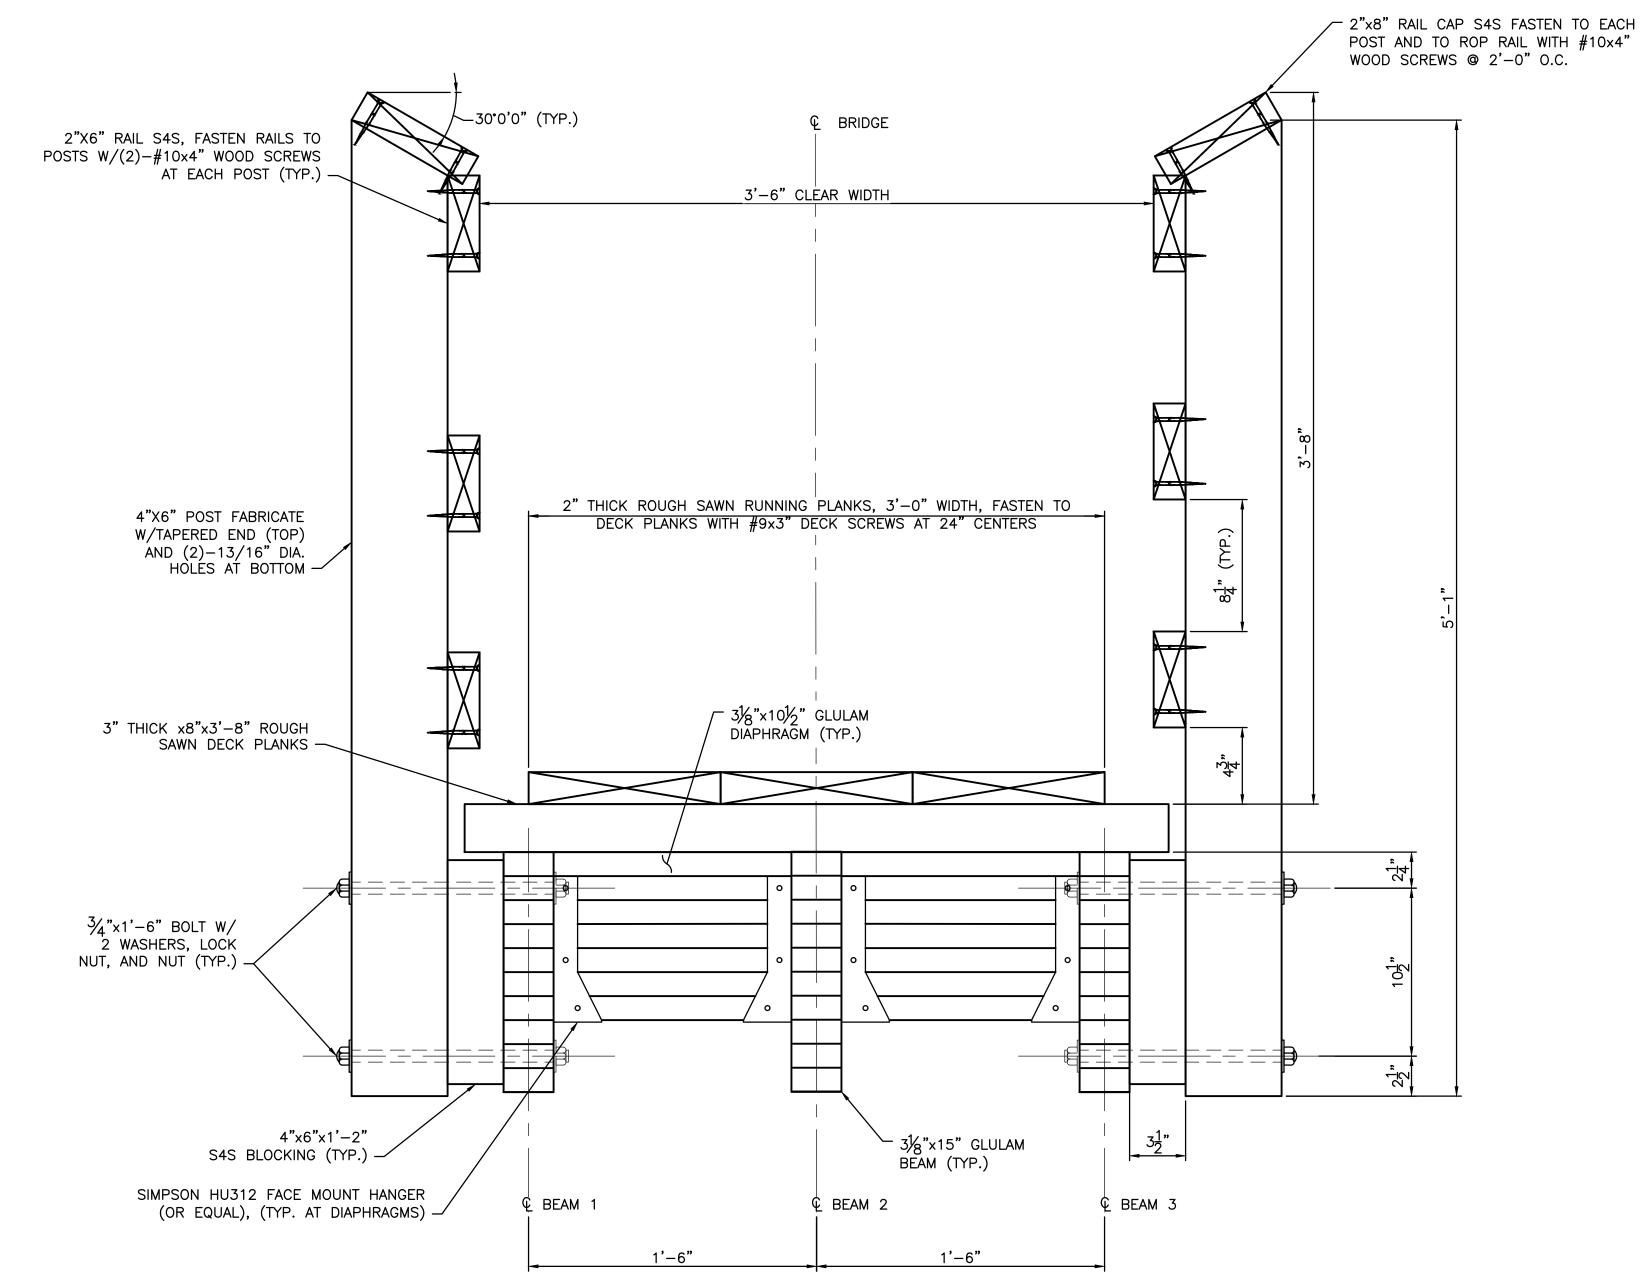



### **TRANSVERSE SECTION**


WAYNE NATIONAL FOREST TRAIL BRIDGES **BUCKEYE TRAILS ASSOCIATION** 


DRAWING NAME

BRIDGE

**TRANSVERSE SECTION** 

SITE I - NCT ATHENS CENTRAL #4 OVER ROCK RUN

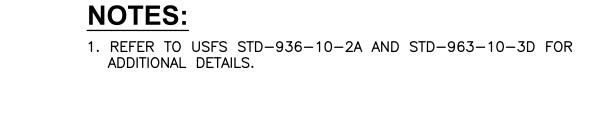

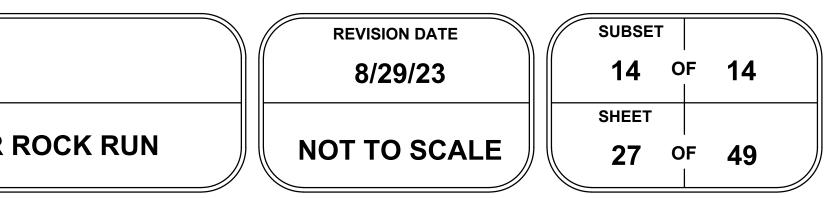

#### **STANDARD DRAWINGS:**

REFER TO U.S. DEPARTMENT OF AGRICULTURE FOREST SERVICE STANDARD TRAIL PLANS:

964 – PREFABRICATED TRAIL BRIDGE 965 – TRAIL BRIDGE SUBSTRUCTURES

#### **DESIGN SPECIFICATIONS:**

- THIS STRUCTURE SHALL CONFORM TO THE FOLLOWING SPECIFICATIONS: - THE 2009 AASHTO GUIDE SPECIFICATIONS FOR THE DESIGN OF PEDESTRIAN BRIDGE INCLUDING THE 2015 INTERIMS
- THE 2020 AASHTO LRFD BRIDGE DESIGN SPECIFICATIONS, 9TH EDITION - THE 2014 FSH 7709.56b - TRANSPORTATION STRUCTURES HANDBOOK. CHAPTER 80 – TRAIL BRIDGE DESIGN

PROVIDE CAMBER FOR 100% OF THE FULL DEAD LOAD DEFLECTION PLUS 1% OF BRIDGE SPAN. SUBMIT SHOP DRAWINGS AND CALCULATIONS FOR APPROVAL AND MUST BE APPROVED BEFORE FABRICATION.

MATERIALS AND CONSTRUCTION OF THIS STRUCTURE SHALL BE IN ACCORDANCE WITH THE STANDARD SPECIFICATION FOR CONSTRUCTION OF TRAILS AND TRAIL BRIDGES ON FOREST SERVICE PROJECTS, DATED 10-30-2014.

#### **DESIGN LOADING:**

PEDESTRIAN LOADING: 0.090 KSF

#### **DESIGN STRESSES:**

CONCRETE CLASS A, - COMPRESSIVE STRENGTH 4.0 KSI (ABUTMENTS)

CONCRETE CLASS A, WITH 3/4" MAX. AGGREGATE SIZE - COMPRESSIVE STRENGTH 4.5 KSI (DRILLED SHAFTS)

CONCRETE REINFORCING:

REINFORCING STEEL - MINIMUM YIELD STRENGTH 60 KSI

USE STEEL SHAPES, PLATES AND BARS OF WEATHERING STEEL CONFORMING TO AASHTO M270.

BRIDGE MEMBERS ARE FABRICATED FROM HIGH STRENGTH, LOW ALLOY, ENHANCED ATMOSPHERIC CORROSION RESISTANT ASTM A847 COLD-FORMED WELDED SQUARE AND RECTANGULAR TUBING, AND ASTM A588, ASTM A606, OR ASTM A242 PLATE AND STRUCTURAL SHAPES (Fy = 50 KSI).

MINIMUM STEEL THICKNESS SHALL BE AS SPECIFIED IN THE GUIDE SPECIFICATIONS FOR DESIGN OF PEDESTRIAN BRIDGES. USE HIGH STRENGTH BOLTS CONFORMING TO AASHTO M164, (ASTM A325), TYP 3, UNLESS NOTED OTHERWISE. USE MALLEABLE IRON WASHERS AGAINST WOOD.

#### PREFABRICATED STEEL BRIDGE SUPERSTRUCTURE:

PREFABRICATED STEEL SUPERSTRUCTURE DESIGN MUST BE A TRUSS CONFIGURATION SIMILAR TO THAT SHOWN ON THE DRAWINGS. THE BRIDGE SHALL MAINTAIN THE CLEARANCES ABOVE HIGH WATER INDICATED ON THE BRIDGE ELEVATION. THE BRIDGE CROSS-SECTION SHALL BE DETERMINED BY THE CONTRACTOR BUT SHALL PROVIDE THE WIDTH AND RAILING DETAILS INDICATED ON THE BRIDGE TYPICAL SECTION. THE CONTRACTOR SHALL DETERMINE TRUSS HEIGHT AND THE LOCATION OF THE DECK WITH RESPECT TO THE TOP AND BOTTOM CHORDS (U FRAME VS. H FRAME). OVERHEAD LATERAL BRACING IS UNACCEPTABLE U FRAMES SHALL BE ADEQUATE FOR ALL STIFFNESS AND BUCKLING CHECKS IN ACCORDANCE WITH THE AASHTO LRFD BRIDGE DESIGN SPECIFICATIONS INCLUDING THE AASHTO LRFD GUIDE SPECIFICATIONS FOR THE DESIGN OF PEDESTRIAN BRIDGES. IN PARTICULAR, REFER TO CHAPTER 7 OF THE GUIDE SPECIFICATIONS FOR THE DESIGN OF PEDESTRIAN BRIDGES FOR U-FRAME STIFFNESS REQUIREMENTS.

ALL RELATED DETAILS SUCH AS PROFILE, ABUTMENT DETAILS, BEARINGS, AND TIMBER DECKING SHALL BE THE RESPONSIBILITY OF THE CONTRACTOR TO FINALIZE AND CONSTRUCT.

THE PREFABRICATED STEEL BRIDGE SUPERSTRUCTURE, AND ASSOCIATED DETAILS INCLUDING TIMBER COMPONENTS SHALL BE DESIGNED UNDER THE DIRECTION OF A REGISTERED PROFESSIONAL ENGINEER IN THE STATE OF OHIO. THE COMPLETED DESIGN, DRAWINGS, AND SPECIFICATION PACKAGE SHALL BE SUBMITTED TO THE CONTRACTING OFFICER FOR REVIEW AND APPROVAL

THE TOTAL UNFACTORED COMPONENT DEAD LOAD (DC) REACTION USED IN THE DESIGN WAS ASSUMED TO BE 3200 LBS PER BEARING FOR THE COMPLETE SUPERSTRUCTURE AT SITE B, SITE D, AND SITE G. IF THE DC LOAD REACTIONS ARE HIGHER THAN THE ABOVE, THE CONTRACTOR SHALL NOTE THE VARIANCE AT THE TIME OF BID TO ALLOW THE OWNER TO DETERMINE POSSIBLE COST IMPACTS TO THE SUBSTRUCTURES, WHICH WILL BE FACTORED INTO THE CONTRACTOR'S BID.

THE BRIDGE RAILING SHALL BE A MINIMUM 42 INCHES HIGH AND THE HORIZONTAL AND VERTICAL ELEMENTS SHALL BE SUCH THAT A 6 INCH SPHERE CANNOT PASS THROUGH. REFER TO THE AASHTO CODES FOR BRIDGE RAILING LOAD CAPACITY REQUIREMENTS.

### **STEEL FABRICATION:**

THE PREFABRICATED STEEL BRIDGE SUPERSTRUCTURE SHALL BE FABRICATED BY AN AISC CERTIFIED PLANT - SIMPLE STEEL BRIDGES OR COMPLEX STEEL STRUCTURES. FLUX CORED ARC WELDING OR GMAW PROCESS WILL BE USED. THE WELDING PROCEDURE SHALL BE IN ACCORDANCE WITH AWS D1.1 AND SHALL BE SUITABLE FOR THE GRADE OF STEEL AND INTENDED USE OR SERVICE.

ALL TOP AND BOTTOM CHORD SHOP SPLICES TO BE COMPLETE PENETRATION TYPE WELDS. WELD BETWEEN TOP CHORD AND END VERTICAL SHALL BE AS DETAILED.

UNLESS OTHERWISE NOTED, WELDED CONNECTIONS SHALL BE FILLET WELDS (OR HAVE THE EFFECTIVE THROAT OF A FILLET WELD) OF A SIZE EQUAL TO THE THICKNESS OF THE LIGHTEST GAGE MEMBER IN THE CONNECTION. WELDS SHALL BE APPLIED AS FOLLOWS:

- WELDED ALL AROUND.

# **ERECTION PLAN:**

THE CONTRACTOR SHALL SUBMIT AN ERECTION PLAN FOR THE PREFABRICATED STEEL BRIDGE SUPERSTRUCTURE TO THE C.O. FOR APPROVAL 14 DAYS BEFORE ERECTION IS SCHEDULED. IF ALLOWED UNDER THE PROJECT DESIGN CRITERIA, TEMPORARY IN-STREAM SUPPORT BENTS MAY BE USED FOR THE ERECTION OF THE PREFABRICATED STEEL TRUSS BRIDGE. THE IN-STREAM BENTS SHALL BE CRIBBING, SILLS, CONCRETE BLOCKS OR OTHER SUPPORTS AND SHALL BE PLACED WITH MINIMAL DISTURBANCE WITHIN THE STREAM. ALL MATERIALS TO CONSTRUCT THE TEMPORARY IN-STREAM BENTS SHALL BE REMOVED. THE SUBMITTALS SHALL INCLUDE DRAWINGS INDICATING TEMPORARY BENT LOCATIONS ANO DETAILS ALSO INCLUDED, THE CONTRACTOR SHALL INDICATE THE EQUIPMENT AND METHODS PROPOSED TO INSTALL AND REMOVE THE TEMPORARY BENTS AND ERECT THE NEW PREFABRICATED STEEL TRUSS SUPERSTRUCTURE.

### **TIMBER & LUMBER**

SOLID SAWN TIMBER MEMBERS SHALL CONFORM TO THE REQUIREMENTS OF THE GRADING RULES AGENCY FOR THE SPECIES. TYPE, AND GRADE SPECIFIED BELOW.

- <u>DECK PLANKS</u>
- RULES AGENCY WWPA, WCLIB
- RULES AGENCY WWPA, WCLIB
- RETENTION OR TO REFUSAL.
- RUNNING PLANKS AGENCY - WWPA, WCLIB
- <u>RUB RAIL</u> IPE, NO.1 OR NO.2 GRADE

#### **TREATMENT:**

PRESERVATIVE TREATMENT SHALL BE IN ACCORDANCE WITH THE CURRENT AMERICAN WOOD PROTECTION ASSOCIATION (AWPA) SPECIFICATIONS USING THE TREATMENT MATERIALS LISTED BELOW. TREATMENT WILL COMPLY WITH THE REQUIREMENTS OF THE CURRENT EDITION OF WESTERN WOOD PRESERVERS INSTITUTE (WWPI) "BEST MANAGEMENT PRACTICES FOR THE USE OF TREATED WOOD IN AQUATIC ENVIRONMENTS".


DECKING, RUNNING PLANKS, & RAILING SYSTEM - AWPA USE CATEGORY SYSTEM (U1) FOR USE CATEGORY 4C GROUND CONTACT EXTREME DUTY (UC4C), TYPE CuN, UNLESS OTHERWISE NOTED

### FIELD TREATMENT:

COPPER NAPHTHENATE (2% SOLUTION) SHALL BE FURNISHED FOR FIELD TREATING OF WOOD. ALL ABRASIONS AND FIELD CUTS - APPROVED BY THE C.O.R. - SHALL BE CAREFULLY TRIMMED AND GIVEN THREE BRUSH COATS OF THE FIELD TREATMENT SOLUTION. WHERE APPROVED, FIELD DRILLING OF BOLT, SCREW OR NAIL HOLES IS REQUIRED. THE HOLES SHALL BE FILLED WITH PRESERVATIVE PRIOR TO INSERTING THE FASTENERS.

### **TIMBER FABRICATION:**

SUBMIT SHOP DRAWINGS FOR ALL MANUFACTURED BRIDGE COMPONENTS (EXCEPT TIMBER RUNNING PLANKS). SHOW ALL DIMENSIONS AND FABRICATION DETAILS FOR ALL CUT OR BORED TIMBER.

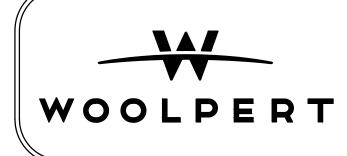

**ONE EASTON OVAL SUITE 400** COLUMBUS, OH 43219 T 614-476-6000 F 614-476-6225

**DESIGNED BY:** JYM

CHECKED BY: PES **REVIEWED BY:** TML





A. BOTH ENDS OF VERTICALS, DIAGONALS, AND FLOOR BEAMS SHALL BE

B. BRACE DIAGONALS WILL BE WELDED ALL AROUND.

C. BOTTOM OF STRINGERS WILL BE STITCH WELDED TO TOP OF FLOOR BEAMS.

D. MISCELLANEOUS NON-STRUCTURAL MEMBERS WILL BE STITCH WELDED TO THEIR SUPPORTING MEMBERS.

- SOUTHERN PINE ROUGH SAWN SELECT STRUCTURAL, TREATED, GRADING - HEM-FIR/DOUGLAS FIR, ROUGH SAWN, SELECT STRUCTURAL GRADE, GRADING

- NOMINAL 3-INCH THICK SELECT STRUCTURAL FIR (Fb = 1500 PSI MIN.). TIMBER DECK AND RUB RAIL MATERIAL SHALL BE TREATED WITH ALKALINE COPPER QUATERNARY (ACQ) OR AZOLE BIOCIDE (MCA) TO A 0.4 PCF

SOUTHERN PINE ROUGH SAWN NO.2 GRADE, TREATED, GRADING RULES

#### **DRILLED SHAFTS:**

THE MAXIMUM FACTORED LOAD TO BE SUPPORTED BY EACH DRILLED SHAFT IS 34.36 KIPS AT THE SITE B ABUTMENTS. THE NOMINAL CAPACITY OF THE SHAFT IS 54 KIPS COMBINED SIDE AND END BEARING. THE MAXIMUM FACTORED LATERAL LOAD AND BENDING MOMENT TO BE SUPPORTED BY EACH DRILLED SHAFT IS 12.53 KIPS AND 55.04 KIP-FEET, RESPECTIVELY. THESE LOADS PRODUCE A MAXIMUM FACTORED BENDING MOMENT OF 121.15 KIP-FEET AND MAXIMUM FACTORED SHEAR OF 12.52 KIPS, WITHIN THE DRILLED SHAFT.

THE MAXIMUM FACTORED LOAD TO BE SUPPORTED BY EACH DRILLED SHAFT IS 43.04 KIPS AT THE SITE D ABUTMENTS. THIS LOAD IS RESISTED BY A FACTORED TIP RESISTANCE OF 493.2 KIPS PER SQUARE FOOT. THE MAXIMUM FACTORED LATERAL LOAD AND BENDING MOMENT TO BE SUPPORTED BY EACH DRILLED SHAFT IS 14.02 KIPS AND 39.34 KIP-FEET, RESPECTIVELY. THESE LOADS PRODUCE A MAXIMUM FACTORED BENDING MOMENT OF 106.61 KIP-FEET AND MAXIMUM FACTORED SHEAR OF 14.00 KIPS, WITHIN THE DRILLED SHAFT.

THE MAXIMUM FACTORED LOAD TO BE SUPPORTED BY EACH DRILLED SHAFT IS 27.48 KIPS AT THE SITE F ABUTMENTS. THIS LOAD IS RESISTED BY A FACTORED TIP RESISTANCE OF 613.8 KIPS PER SQUARE FOOT. THE MAXIMUM FACTORED LATERAL LOAD AND BENDING MOMENT TO BE SUPPORTED BY EACH DRILLED SHAFT IS 4.75 KIPS AND 13.92 KIP-FEET, RESPECTIVELY. THESE LOADS PRODUCE A MAXIMUM FACTORED BENDING MOMENT OF 33.45 KIP-FEET AND MAXIMUM FACTORED SHEAR OF 9.62 KIPS, WITHIN THE DRILLED SHAFT.

THE MAXIMUM FACTORED LOAD TO BE SUPPORTED BY EACH DRILLED SHAFT IS 33.48 KIPS AT THE SITE G ABUTMENTS. THIS LOAD IS RESISTED BY A FACTORED TIP RESISTANCE OF 392.4 KIPS PER SQUARE FOOT. THE MAXIMUM FACTORED LATERAL LOAD AND BENDING MOMENT TO BE SUPPORTED BY EACH DRILLED SHAFT IS 7.86 KIPS AND 22.13 KIP-FEET, RESPECTIVELY. THESE LOADS PRODUCE A MAXIMUM FACTORED BENDING MOMENT OF 52.88 KIP-FEET AND MAXIMUM FACTORED SHEAR OF 7.85 KIPS, WITHIN THE DRILLED SHAFT.

THE DRILLED SHAFTS SHALL BE INSTALLED IN ACCORDANCE WITH SECTION 565 OF FP-03 (STANDARD SPECIFICATIONS FOR CONSTRUCTION OF ROADS AND BRIDGES ON FEDERAL HIGHWAY PROJECTS).

INTEGRITY TESTING AS DESCRIBED IN SECTION 565.08 IS NOT REQUIRED FOR THIS PROJECT. THE CONTRACTOR SHALL PREPARE AND TEST CONCRETE CYLINDERS IN ACCORDANCE WITH 552 AND REPORT RESULTS TO THE ENGINEER.

AT THE OPTION OF THE CONTRACTOR, THE CASINGS MAY BE LEFT IN PLACE. THE CONTRACTORS MAY SUBSTITUTE ALTERNATIVE MATERIALS FOR THE CASING OTHER THAN STEEL PROVIDED THAT THEY CAN MAINTAIN A STABLE EXCAVATION AND PROVIDE AN ADEQUATE SEAL AT THE BOTTOM OF THE EXCAVATIONS. THE CONTRACTOR IS RESPONSIBLE FOR THE PERFORMANCE OF THE ALTERNATIVE MATERIALS AND WILL NOT BE REIMBURSED FOR ADDITIONAL WORK CAUSED BY FAILURE OF ALTERNATIVE MATERIALS.

DRILLED SHAFTS ABOVE BEDROCK WILL BE PAID FOR AT THE UNIT PRICE BID FOR ITEM 56501 - DRILLED SHAFTS ROCK SOCKETS WILL BE PAID FOR AT THE UNIT PRICE BID FOR ITEM 56502 -ROCK SOCKET

ALL MATERIALS, EQUIPMENT, LABOR REQUIRED FOR THE INSTALLATION OF THE DRILLED SHAFTS AND ROCK SOCKETS ARE INCLUDED IN THE RELEVANT PAY ITEMS.

**DRAWING NAME** 

### STRUCTURE NOTES

WAYNE NATIONAL FOREST TRAIL BRIDGES **BUCKEYE TRAILS ASSOCIATION** 

BRIDGE

### PREFABRICATED TRUSS BRIDO

### **CONCRETE SEALER (NON-EPOXY)**:

THIS WORK CONSISTS OF APPLYING AN APPROVED SEALER ON NEW CONCRETE SURFACE AREAS AFTER THE CONCRETE IS CURED AND REPAIRS COMPLETED AND CURED. APPLY THE SEALER TO LOCATIONS DESCRIBED IN THE PLANS.

FURNISH MATERIALS ACCORDING TO THE OHIO DEPARTMENT OF TRANSPORTATION'S QUALIFIED PRODUCTS LIST (QPL), 705.23NE, NON-EPOXY SEALERS FOR CONCRETE AVAILABLE AT: https://www.dot.state.oh.us/Divisions/ConstructionMgt/Materials/Pages/QPL.aspx

EQUIPMENT: USE APPLICATION EQUIPMENT RECOMMENDED BY THE SEALER MANUFACTURER. USE SPRAY EQUIPMENT, TANKS, HOSES, BROOMS, ROLLERS, COATERS, SQUEEGEES, ETC., THAT ARE CLEAN, FREE OF FOREIGN MATTER, OIL RESIDUE AND WATER.

MIXING: MIX THE SEALER ACCORDING TO THE MANUFACTURER'S RECOMMENDED PROCEDURES. FURNISH THE ENGINEER WITH THE MANUFACTURER'S APPLICATION INSTRUCTIONS. DO NOT MIX OR APPLY THE SEALER UNTIL THE MANUFACTURER'S WRITTEN RECOMMENDATIONS ARE SUPPLIED TO THE ENGINEER. MIX AND MAINTAIN MATERIALS AT A UNIFORM CONSISTENCY DURING APPLICATION.

STORAGE: STORE ALL SEALER COMPONENTS IN TIGHTLY SEALED CONTAINERS, IN A DRY LOCATION, AND AS RECOMMENDED BY THE MANUFACTURER. DELIVER UNOPENED DRUMS OR CONTAINERS OF THE SEALER OR SEALER COMPONENTS TO THE JOB SITE WITH THE MANUFACTURER'S NUMBERED SEAL INTACT.

SURFACE CONDITION: APPLY SEALERS ONLY TO SURFACES WHICH ARE DRY, FREE FROM DUST, DIRT, OIL, WAX, CURING COMPOUNDS, EFFLORESCENCE, LAITANCE, COATINGS AND OTHER FOREIGN MATERIALS. VISUALLY INSPECT ALL SURFACES BEFORE APPLYING SEALER. REMOVE ALL STRUCTURALLY UNSOUND SURFACES AND WEAK SECTIONS. PERFORM ALL CONCRETE PATCHING PRIOR TO SURFACE PROFILING. PERFORM CONCRETE PATCHING ON AREAS IDENTIFIED BY THE ENGINEER. CURE REPAIRED AREAS FOR AT LEAST SEVEN (7) DAYS. AIR DRY ALL CONCRETE SURFACES FOR AT LEAST TEN (10) DAYS AFTER COMPLETION OF REQUIRED CURING. FOR ACCELERATED CURE OF PRECAST CONCRETE, OBTAIN THE REQUIRED 28 DAY STRENGTH AND AIR DRY THE SURFACES AT LEAST TEN (10) DAYS AFTER COMPLETING ACCELERATED CURE.

SURFACE PREPARATION: REMOVE DUST, DIRT, OIL, WAX, CURING COMPOUNDS, EFFLORESCENCE, LAITANCE, COATINGS AND OTHER FOREIGN MATERIALS FROM SURFACES TO BE SEALED.

APPLICATION: DO NOT APPLY SEALER TO SURFACES WITH MOISTURE. APPLY THE SEALER BETWEEN 12 AND 48 HOURS AFTER SURFACE PREPARATION. DO NOT APPLY SEALER IF RAIN IS ANTICIPATED WITHIN SIX (6) HOURS AFTER APPLICATION. WAIT AT LEAST 12 HOURS AFTER LAST RAIN EVENT TO APPLY SEALER. CLEARLY MARK WHERE THE SEALER APPLICATION STOPS IF NOT CONTINUOUS. APPLY THE SEALER ACCORDING TO THE MANUFACTURER'S RECOMMENDED MODE OF APPLICATION.


COVERAGE: MINIMUM, ONE GALLON (3.875 LITER) FOR EACH 150 SQUARE FEET (14.0 SQUARE METERS). APPLY SEALER ON HORIZONTAL SURFACES IN A ONE-PASS OPERATION AT THE REQUIRED COVERAGE. AN ACCEPTABLE APPLICATION PROCEDURE CONSISTS OF SATURATING THE SURFACE AND WAITING A FEW SECONDS FOR THE SEALER TO COMPLETELY PENETRATE THE CONCRETE SURFACE BROOM IN THE SEALER IF RECOMMENDED BY THE MANUFACTURER. APPLY SEALER ON VERTICAL SURFACES TO SATURATE THE SURFACE. THE SURFACE IS SATURATED WHEN RUNS OF 6 TO 12 INCHES DEVELOP. APPLY ADDITIONAL PASSES IN 10 TO 15 MINUTE INTERVALS UNTIL THE COVERAGE RATE IS ACHIEVED. APPLY SEALERS WITH BRUSH OR ROLLER IF RECOMMENDED BY THE MANUFACTURER. AFTER 10 TO 15 MINUTES, SQUEEGEE OFF EXCESS MATERIAL ON SMOOTH FINISHED OR DENSE CONCRETES WHERE THE REQUIRED COVERAGE IS NOT ABSORBED.

SAFETY PRECAUTIONS: FOLLOW PRECAUTIONS DEFINED ON THE MANUFACTURER'S SDS.

ENVIRONMENTAL REQUIREMENTS. PROTECT PLANTS AND VEGETATION FROM OVERSPRAY BY COVERING WITH DROP CLOTHS.

MEASUREMENT AND PAYMENT: PAYMENT SHALL BE INCIDENTAL TO ITEM 965.

	REVISION DATE	SUBSET	
	8/29/23	<b>1</b> OF	21
		SHEET	
GES	NOT TO SCALE	28 OF	49

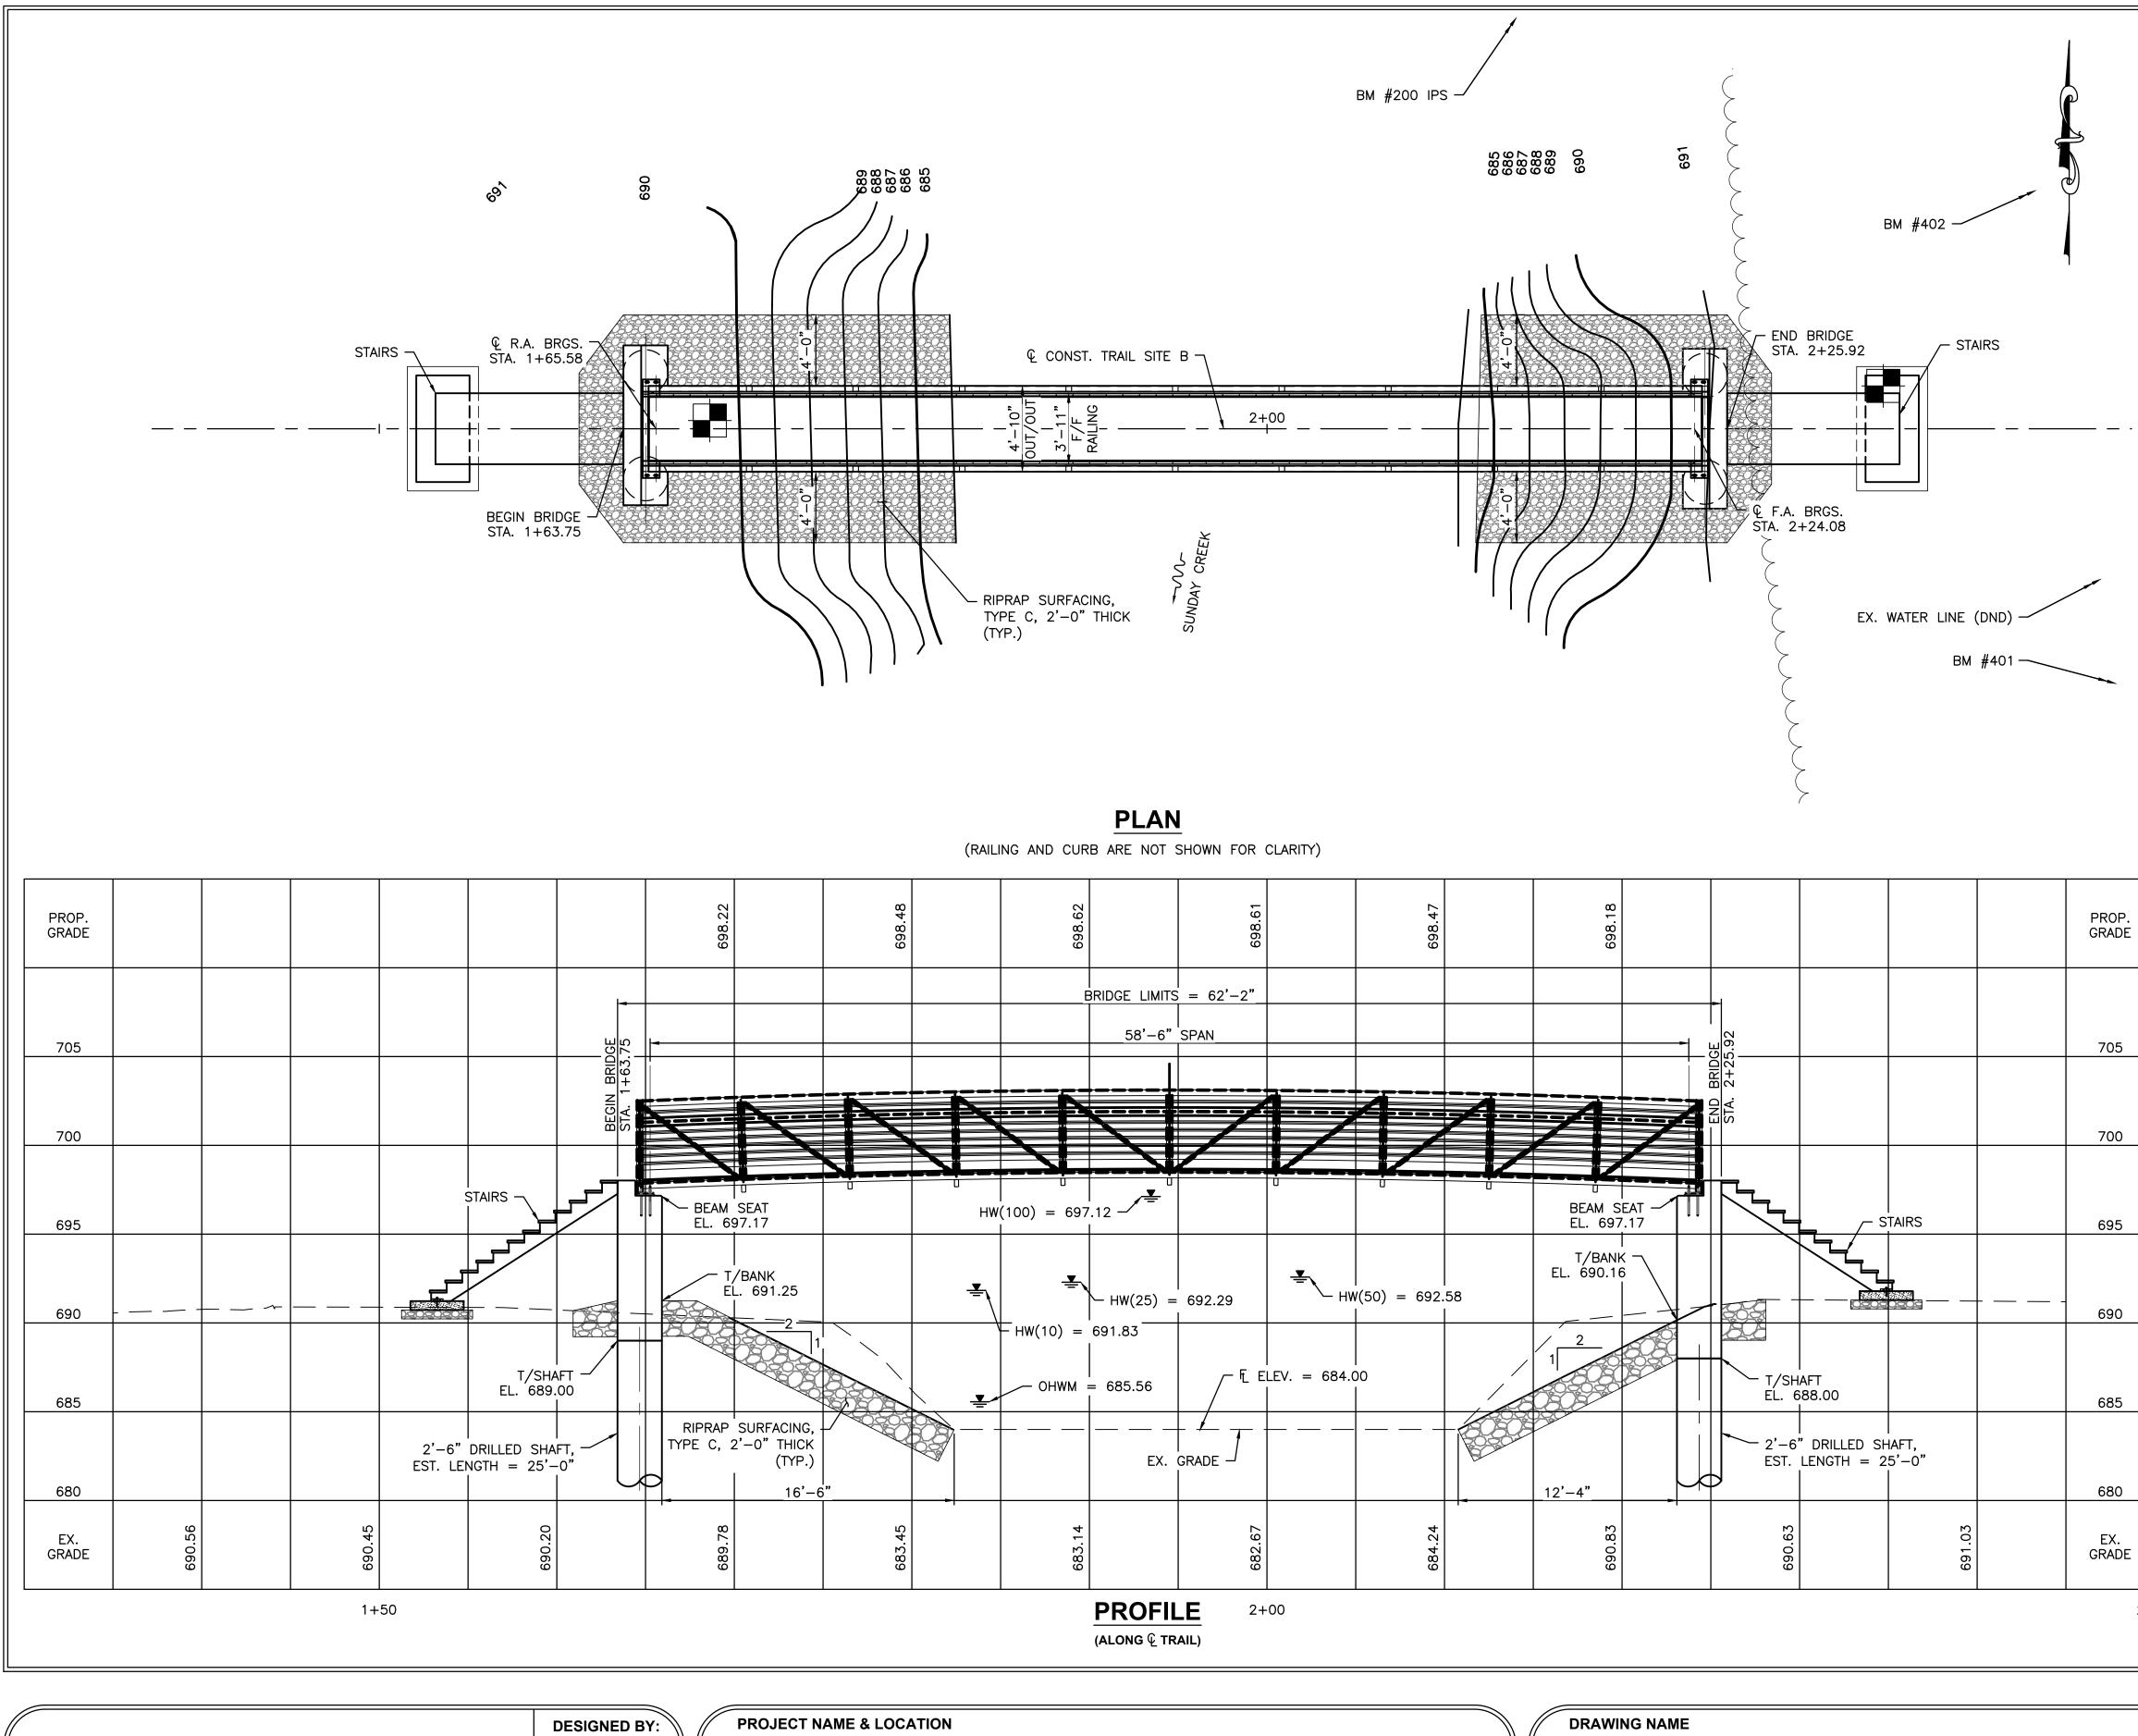



JYM CHECKED BY: PES **REVIEWED BY:** TML



WAYNE NATIONAL FOREST TRAIL BRIDGES **BUCKEYE TRAILS ASSOCIATION** 

#### SITE PLAN

2+50

BRIDGE SITE B - NCT ATHENS CENTRAL #1 OVER SUNDAY CREEK MAINSTEM

	BENCHMARK AND CONTROL DATA										
CONTROL POINT.	DESCRIPTION	NORTHING	EASTING	ELEV.	STATION	OFFSET					
BM#200	IRON PIN	562968.07	2092728.82	704.73	5+90.29	478.86' LT					
BM#401	MAG NAIL	562359.85	2092770.58	699.28	6+32.06	129.36' RT					
BM#402	MAG NAIL	562716.53	2092855.59	705.89	7+17.07	227.32' LT					
B.A	BEGIN ALIGNMENT	562241.502	2092243.643	SEE PROFILE	1+00.00	0'					
CL R.A.	POINT ALONG ALIGNMENT	562241.502	2092308.643	SEE PROFILE	1+65.58	0'					
CL F.A.	POINT ALONG ALIGNMENT	562241.502	2092367.643	SEE PROFILE	2+24.08	0'					
E.A.	END ALIGNMENT	562241.502	2092443.643	SEE PROFILE	8+00.00	0'					
FOR ADDIT	IONAL BENCHMARK INFOR	MATION, SEE	GENERAL NO	TES SHEET 3,	/49.						

LEGEND

BORING LOCATION

RIPRAP SURFACING, TYPE C, 2'-0" THICK


**HYDRAULIC DATA** 


DRAINAGE AREA = $24.2$ SQ.	MILES	
Q (10) = 2,340 CFS	V (10) = 5.56 FT/S	DESIGN
	V (25) = 5.56 FT/S	SCOUR DESIGN
Q (50) = 3,740 CFS	V (50) = 5.59 FT/S	SCOUR CHECK
Q (100) = 4,150 CFS	V (100) = 1.29 FT/S	FEMA
		FFFT

STRUCTURE CLEARS THE 100 YEAR DESIGN HW BY 0.24 FEET. STRUCTURE IS LOCATED IN FEMA ZONE AE.




TYPE:		FABRICATED STEE LED SHAFTS.	EL TI	RUSS	S ON	STUB	ABUTMENTS	S ON
SPANS:	58'-6" C/C BRGS. (INSIDE BOLTS)							
TRAIL:	TRAIL: 3'–11" CLEAR WIDTH BTW. RUB RAILS							
LOADING:	LOADING: 0.090 KSF PEDESTRIAN							
SKEW:	SKEW: NONE							
ALIGNMENT: TANGENT								
COORDINA	TES:	LATITUDE LONGITUDE			34.2 39.2			

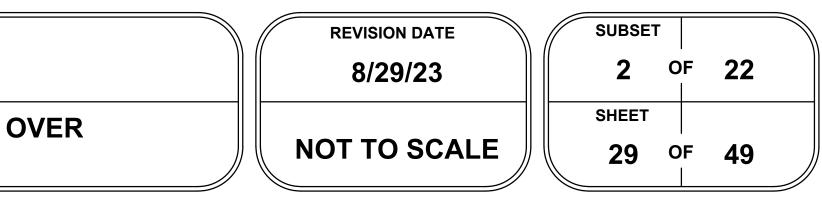

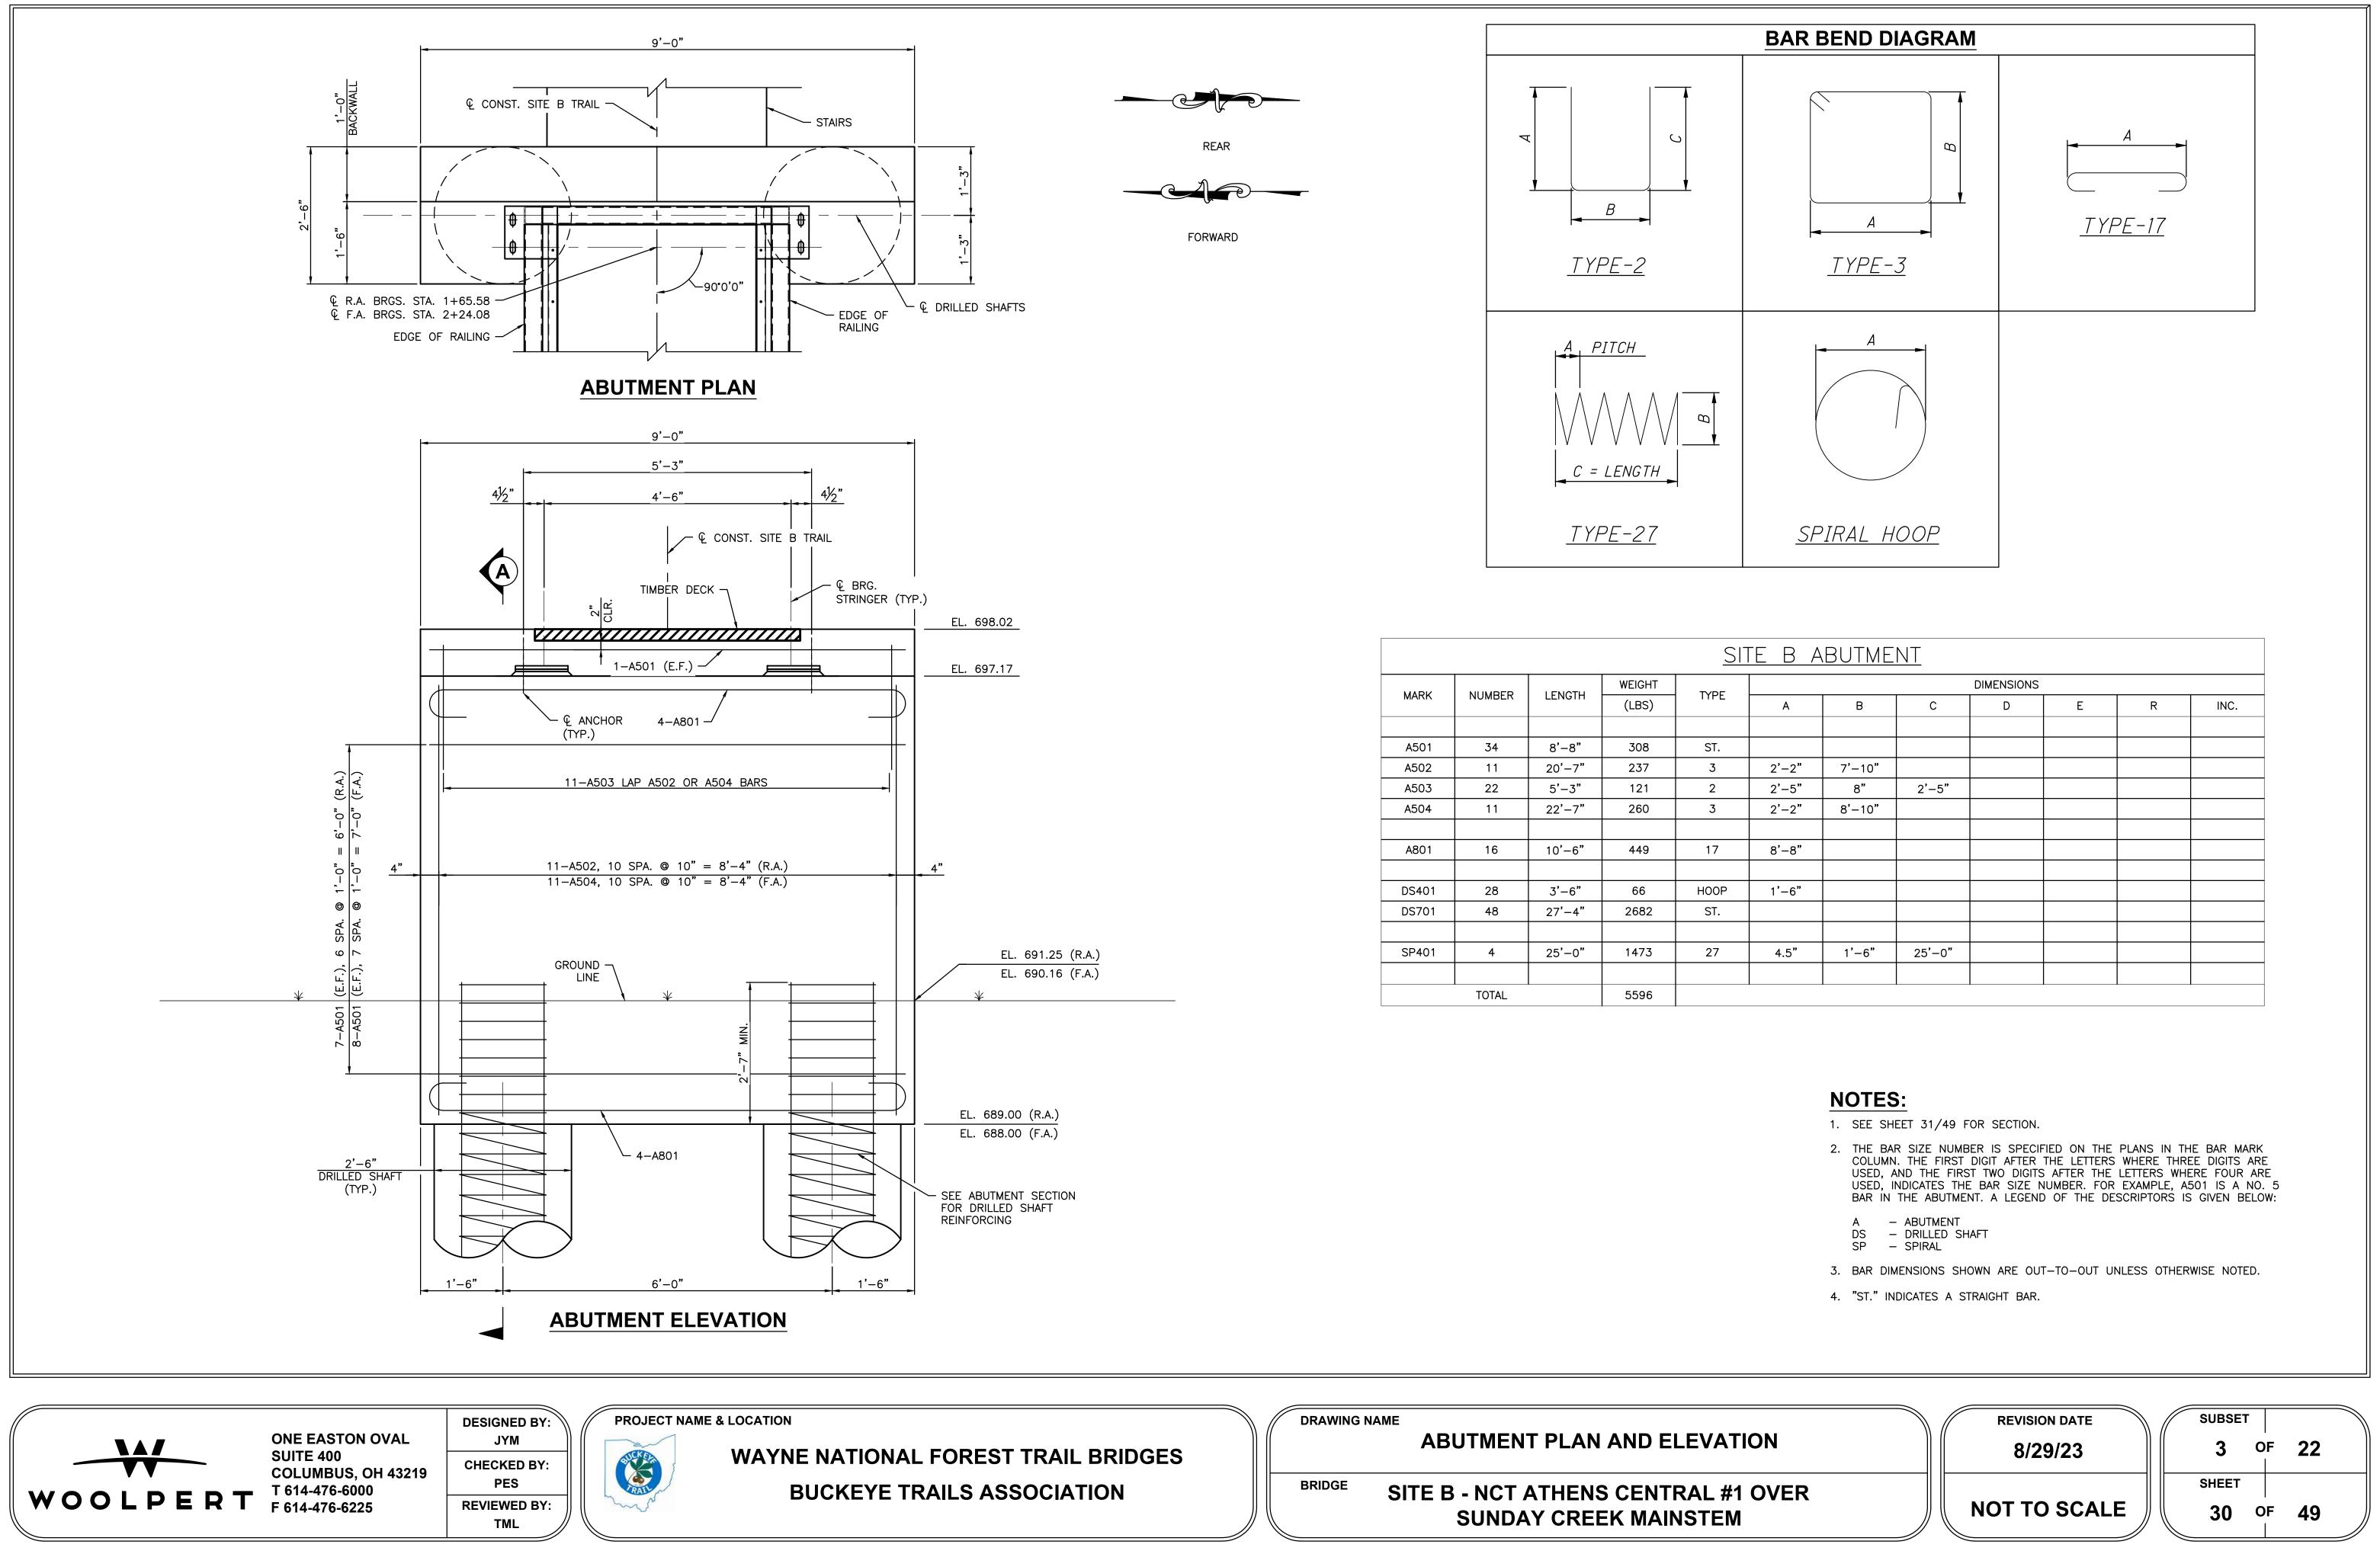


<u>E B ABUTMENT</u>											
	1	1	DIMENSIONS								
A	В	С	D	E	R	INC.					
2'-2"	7'-10"										
2'-5"	8"	2'-5"									
2'-2"	8'-10"										
8'-8"											
1'-6"											
4.5"	1'-6"	25'-0"									

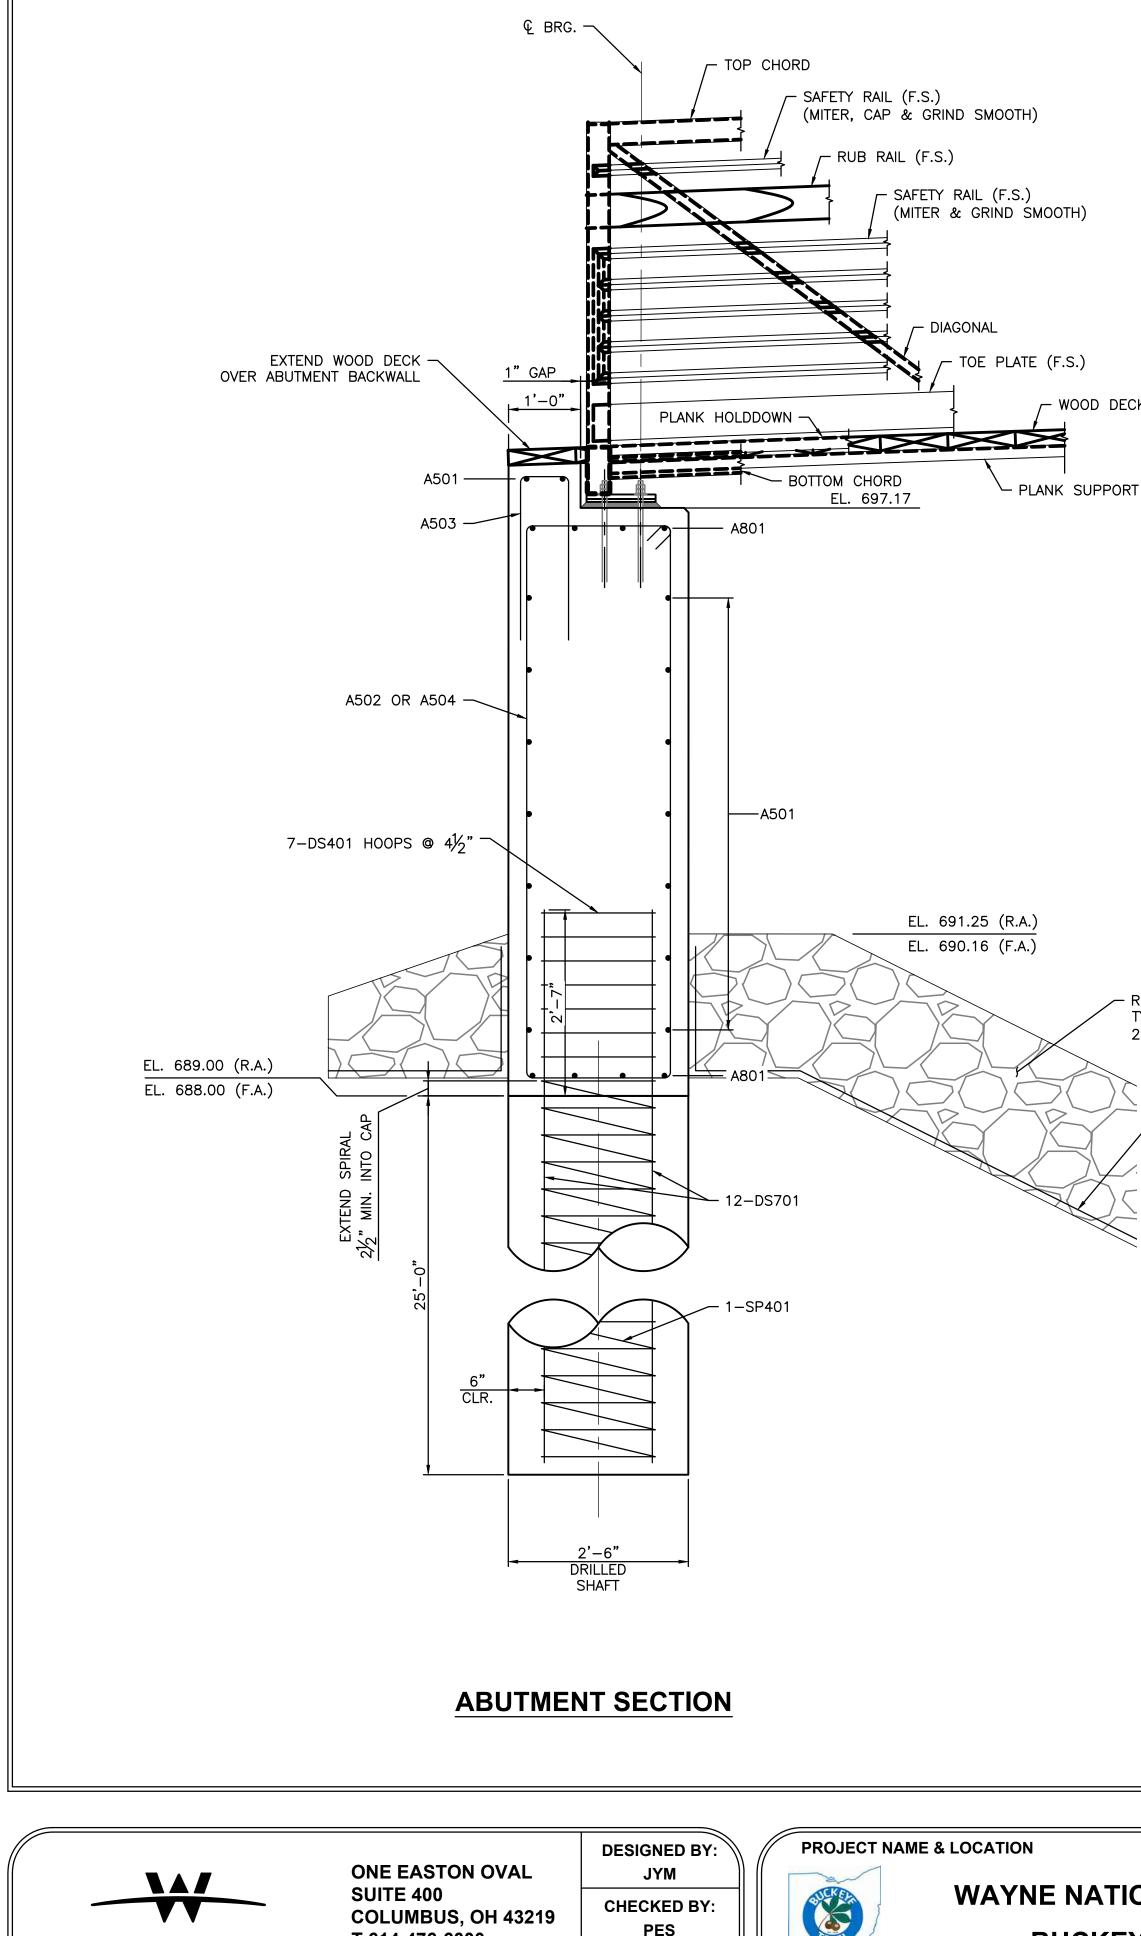

COLUMBUS, OH 43219 T 614-476-6000 WOOLPERT F 614-476-6225

CHECKED BY: PES **REVIEWED BY:** TML

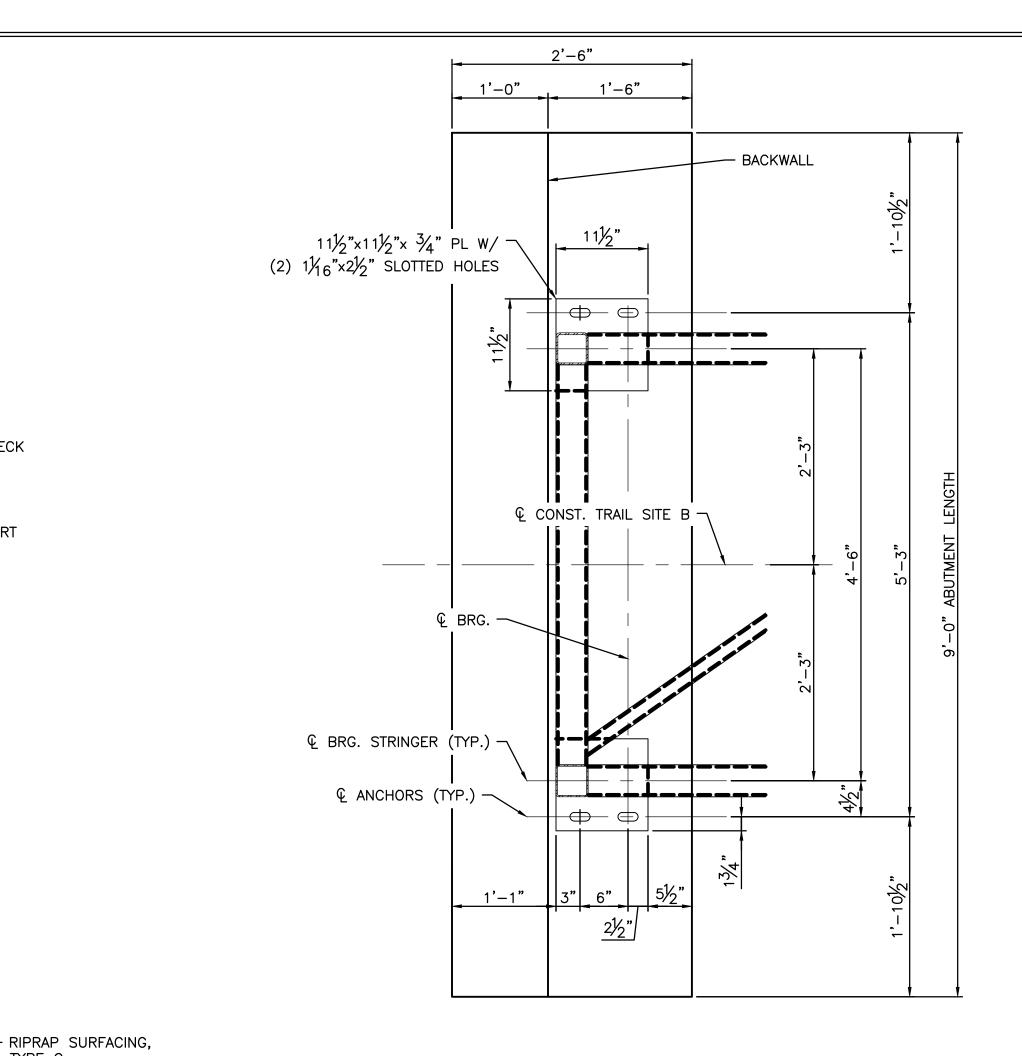

- WOOD DECK

### **BEARING DETAILS - PLAN VIEW**

2'-0" THICK NONWOVEN GEOTEXTILE FABRIC, INCLUDED IN RIPRAP SURFACING FOR PAYMENT

TYPE C,

58'-6" C/C INSIDE BOLTS € BRG. ¬ APPLY A THIN COAT OF -GREASE BETWEEN PLATES / 11½"×11½"× ¾" PL W/ (2) 1/16"x21/2" SLOTTED HOLES EL. 697.17 - 11½"x11½"x ¾" PL W/ ±1" NON-SHRINK GROUT (2)  $1\frac{1}{16}$  DIA. HOLES (2)  $\frac{3}{4}$ " DIA. ASTM F1554 GRADE 36 GALVANIZED ANCHOR RODS W/ (2) NUTS & (1) 2" O.D. WASHER EACH. TOP NUT TIGHT, BOTTOM NUT FINGER TIGHT AT ONE END – BOTH NUTS TIGHT OTHER END.


**BEARING DETAILS - SIDE VIEW** 

DRAWING NAME

WAYNE NATIONAL FOREST TRAIL BRIDGES **BUCKEYE TRAILS ASSOCIATION** 


**ABUTMENT SECTION AND BEARING DETAILS** 


BRIDGE SITE B - NCT ATHENS CENTRAL #1 OVER SUNDAY CREEK MAINSTEM

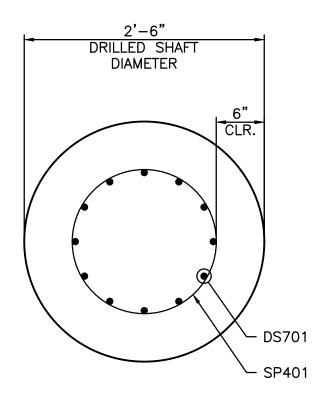

**DRILLED SHAFT SECTION** 

- 1. ALL WELDS TO BE VISUALLY INSPECTED.
- 2. SEE SHEET 30/49 FOR ABUTMENT PLAN AND ELEVATION.
- 3. ASSUME 3" CONCRETE COVER UNLESS NOTED OTHERWISE.
- 4. CENTERING DEVICES SHALL BE REQUIRED DURING CONSTRUCTION TO MAINTAIN ALIGNMENT OF CAGES AND MIN. CONCRETE COVER. CENTERING DEVICES SHALL BE PLACED AT INTERVALS NOT EXCEEDING 5-FT THROUGHOUT THE LENGTH OF THE SHAFT. PROVIDE MIN. ONE SET OF CENTERING DEVICES WITHIN 2-FT TOP AND 2-FT BOTTOM OF SHAFT. PROVIDE CENTERING DEVICES MIN. 60-DEGREE INTERVALS AROUND CIRCUMFERENCE OF SHAFT.
- 5. PROVIDE FEET (BOTTOM SUPPORTS) AT THE BOTTOM OF THE SHAFT ON VERTICAL BARS.

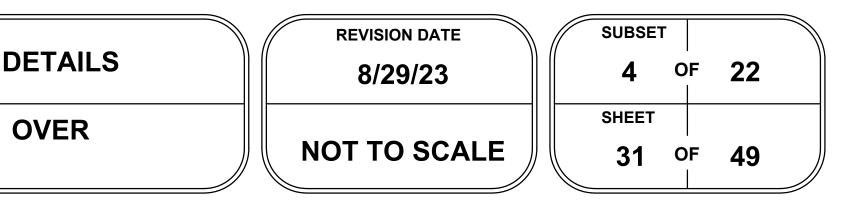

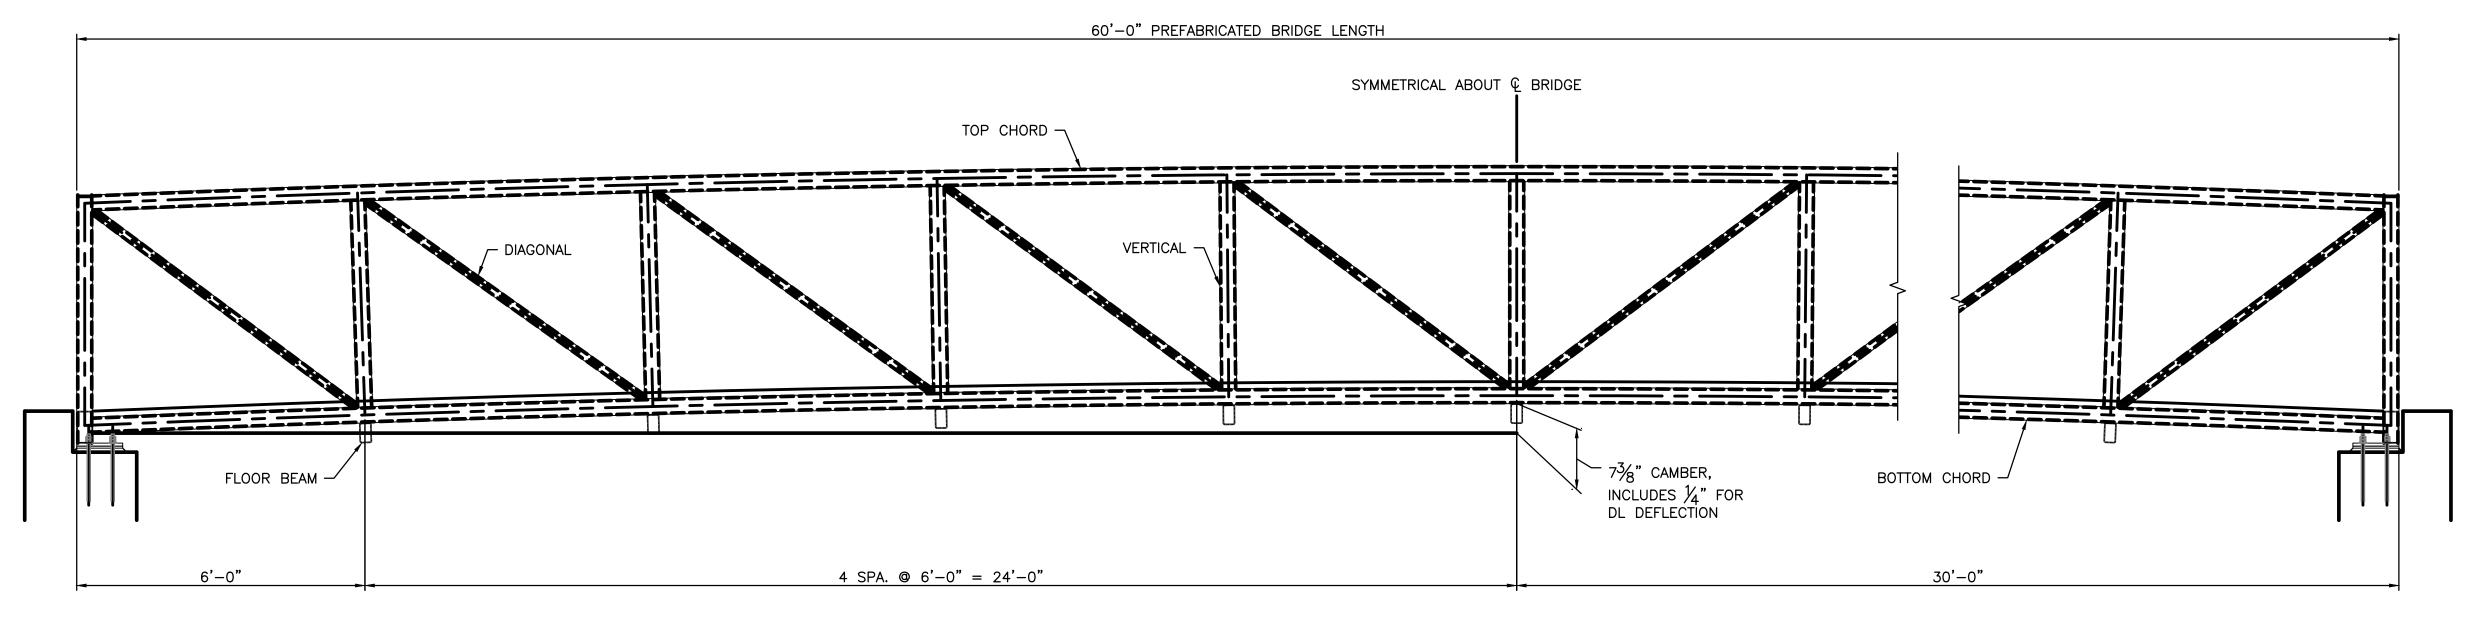



#### ELEVATION

(RUNNING PLANKS AND DECK PLANKS NOT SHOWN FOR CLARITY)


WAYNE NATIONAL FOREST TRAIL BRIDGES **BUCKEYE TRAILS ASSOCIATION** 


DRAWING NAME

**TRUSS ELEVATION** 

BRIDGE SITE B - NCT ATHENS CENTRAL #1 OVER SUNDAY CREEK MAINSTEM


- 1. VERTICALS TO BE FANNED, INSTALLED PERPENDICULAR TO THE BOTTOM CHORD.
- 2. SAFETY RAILS, RUB RAIL, AND TOW PLATE NOT SHOWN FOR CLARITY. SEE SHEET 33 FOR TRANSVERSE SECTION.
- 3. SEE SHEET 31 FOR ABUTMENT SECTION.

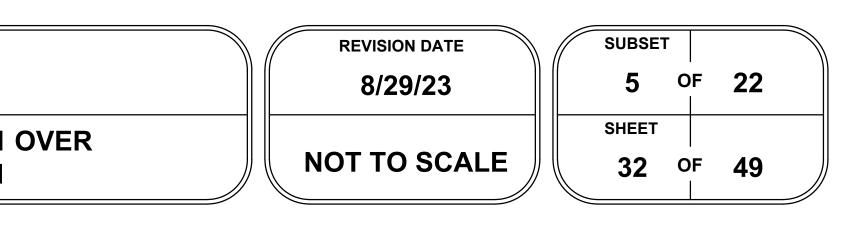

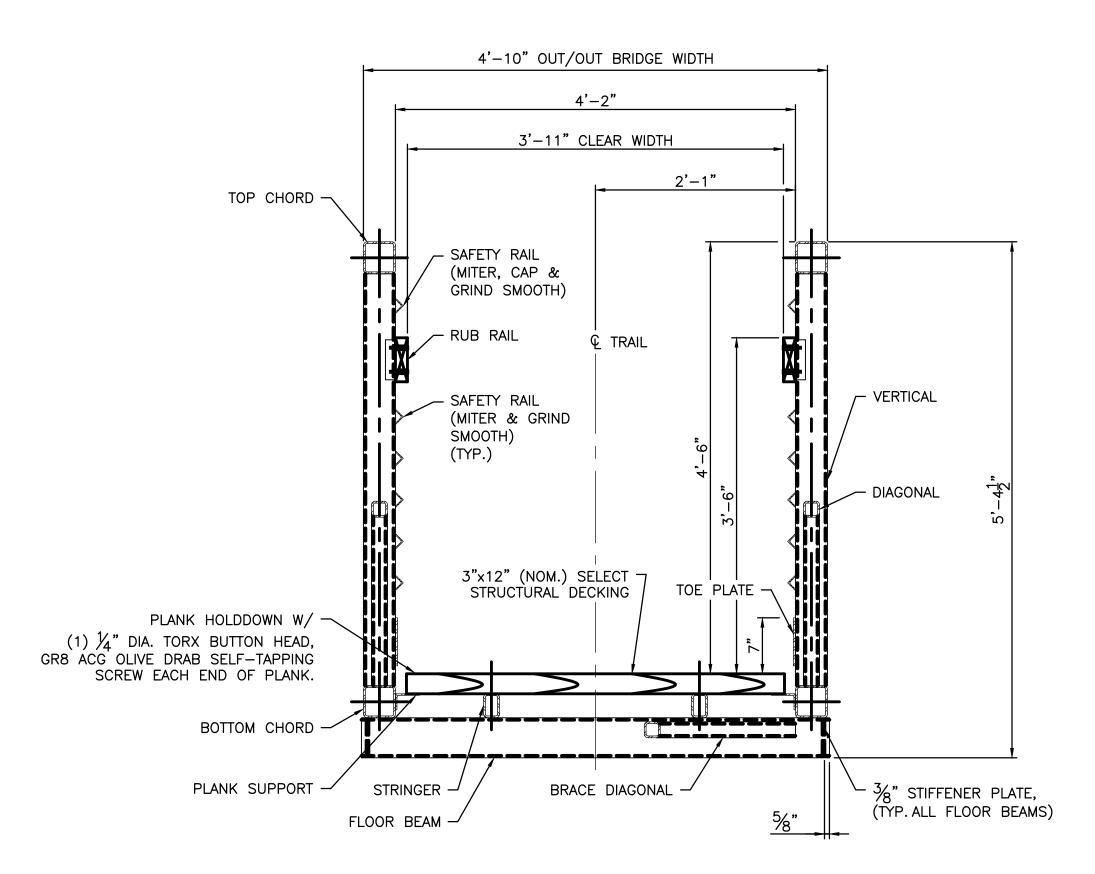

# **TRANSVERSE SECTION**



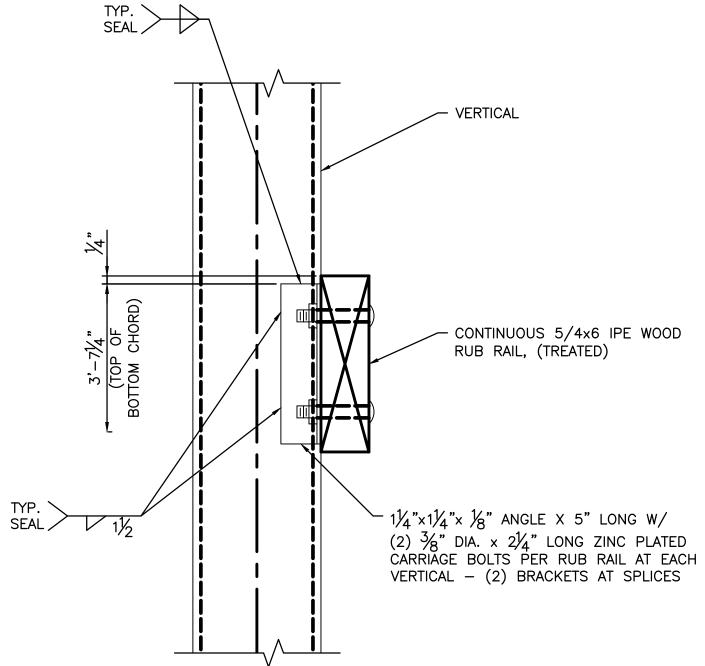

#### **RUB RAIL DETAIL**


# WAYNE NATIONAL FOREST TRAIL BRIDGES **BUCKEYE TRAILS ASSOCIATION**


DRAWING NAME

### **TRANSVERSE SECTION**

BRIDGE SITE B - NCT ATHENS CENTRAL #1 OVER SUNDAY CREEK MAINSTEM

- 1. SPACING OF SAFETY RAILS, RUB RAIL, AND TOE PLATE PRODUCE MAXIMUM OPENINGS OF LESS THAN 4", UP TO A HEIGHT OF 54".
- 2. REFER TO USFS STD-964-10-2A FOR ADDITIONAL DETAILS.

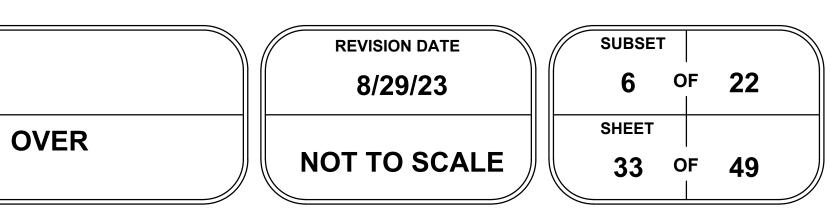

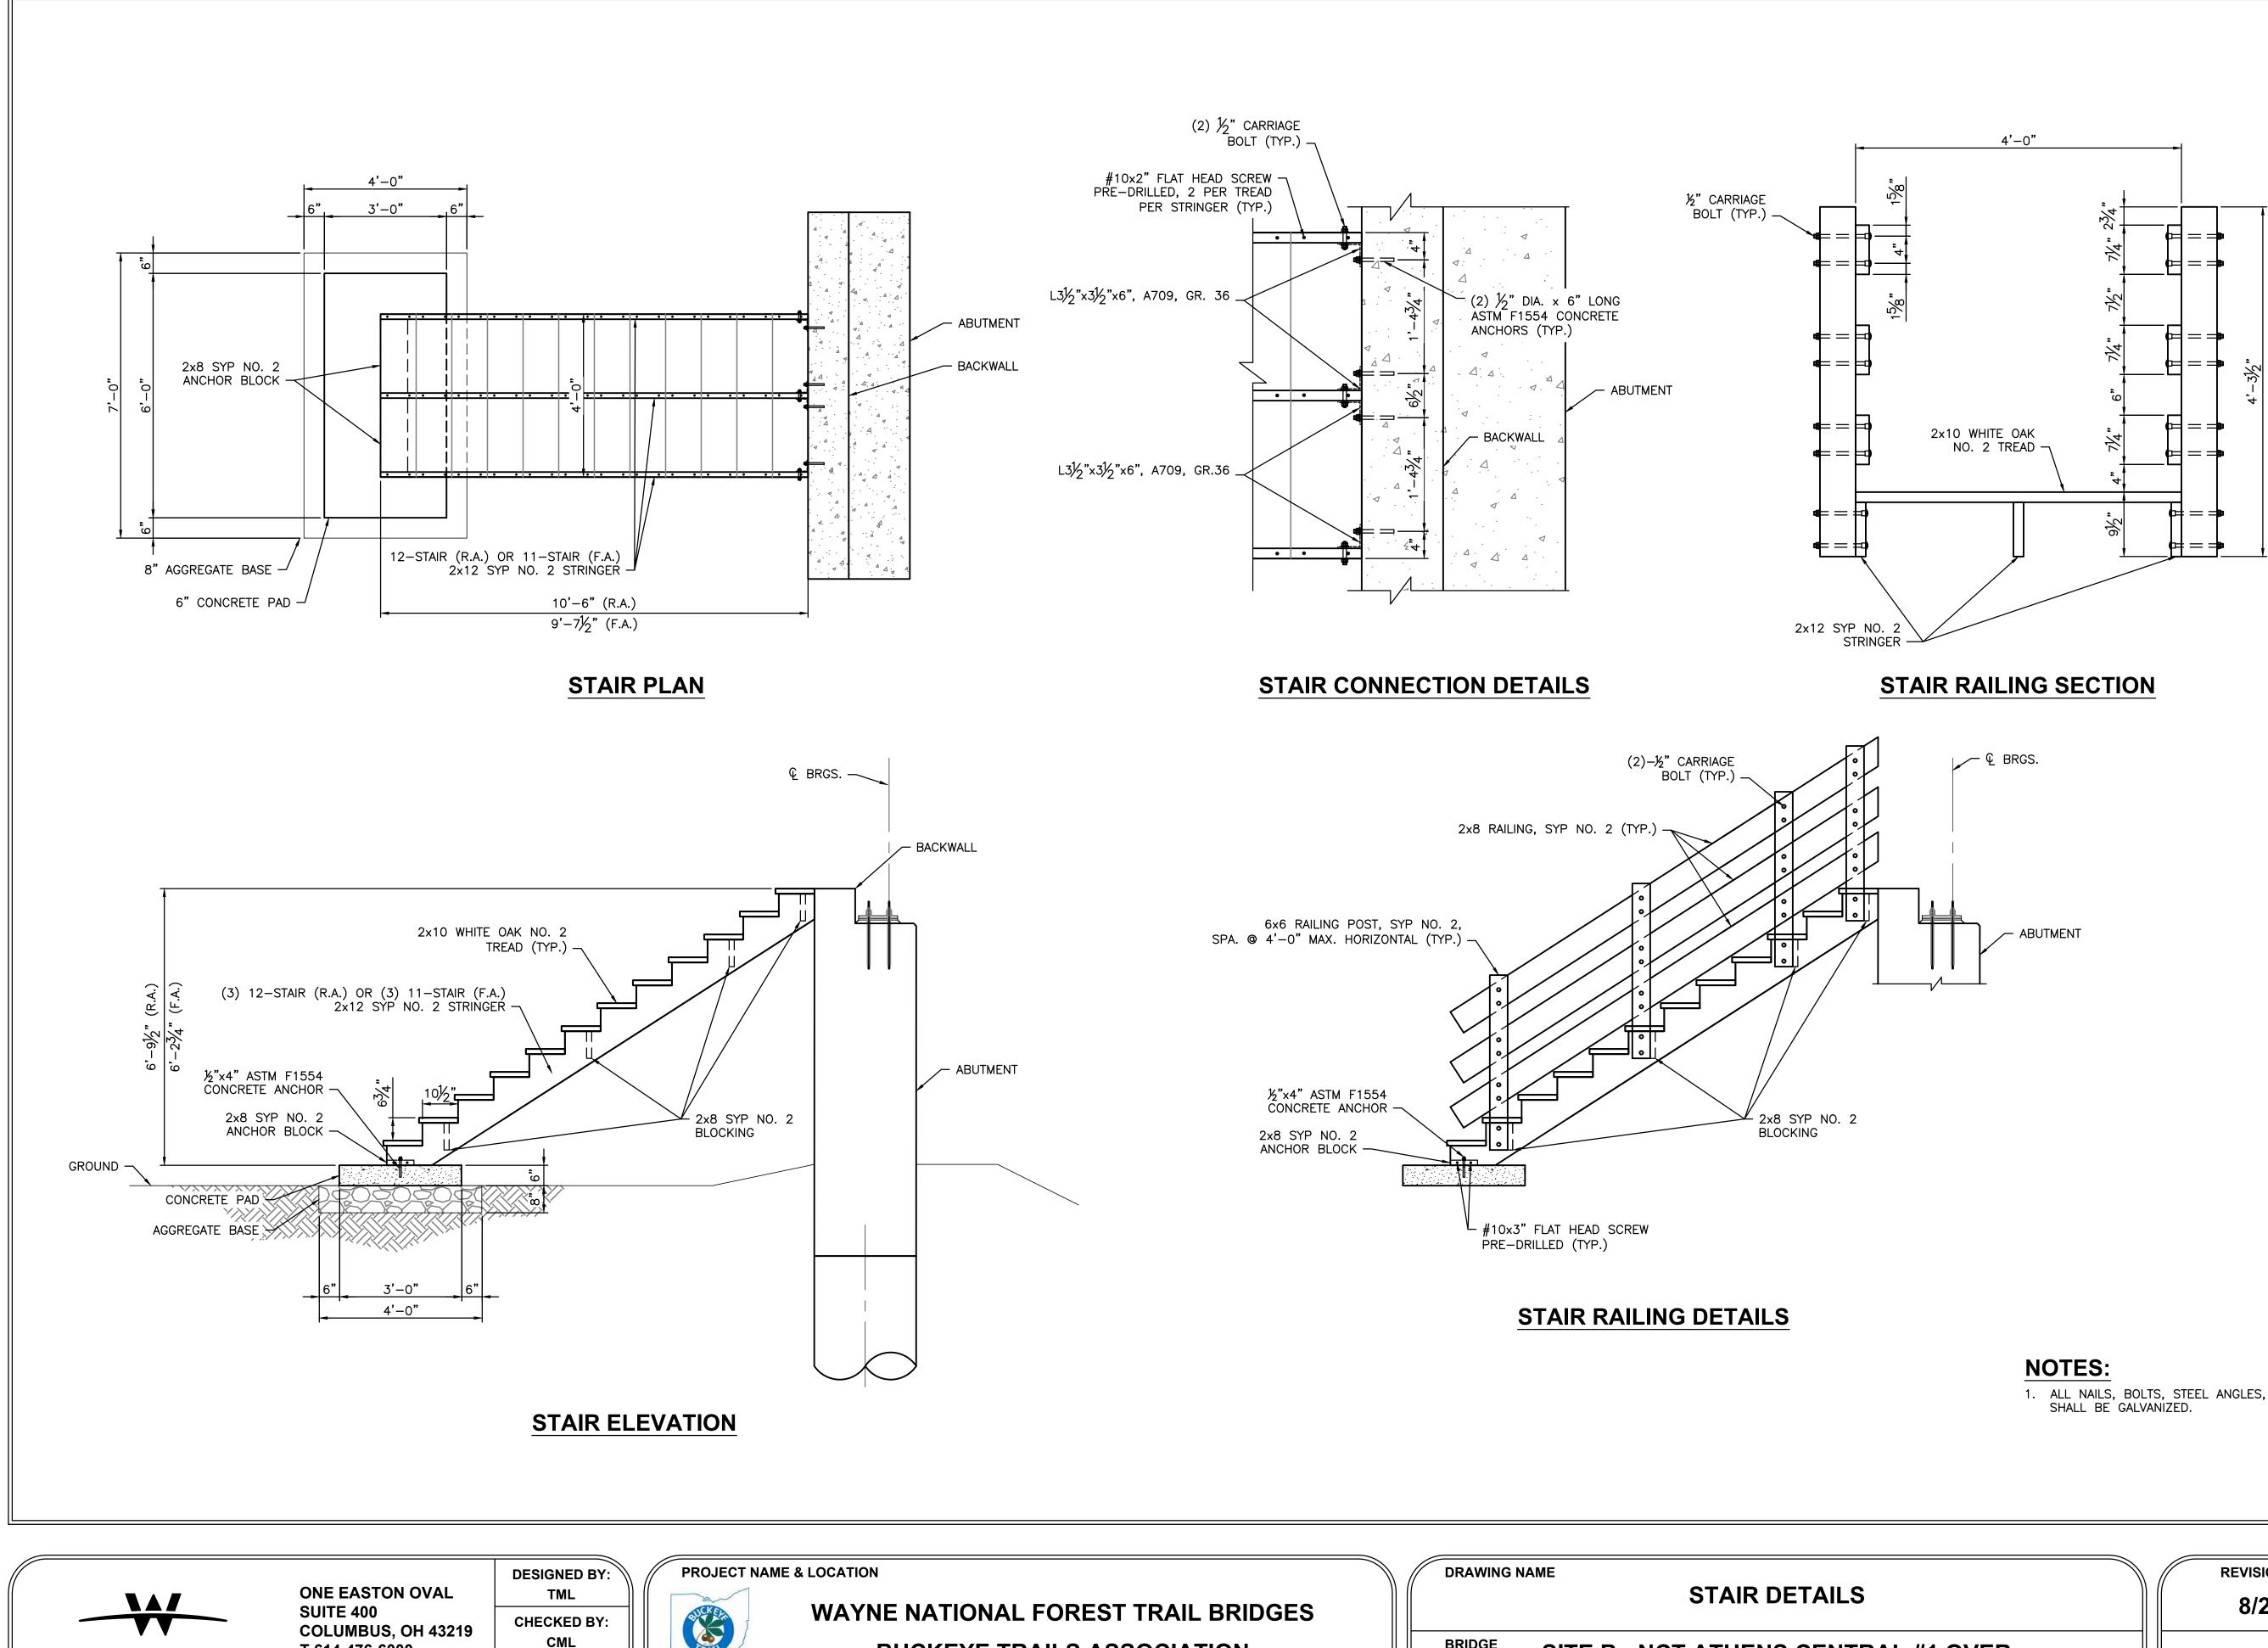

CHECKED BY:

CML

**REVIEWED BY:** 

MJZ


COLUMBUS, OH 43219


T 614-476-6000 F 614-476-6225

WOOLPERT

BRIDGE SITE B - NCT ATHENS CENTRAL #1 OVER SUNDAY CREEK MAINSTEM

1. ALL NAILS, BOLTS, STEEL ANGLES, ANCHORS, AND STEEL HARDWARE SHALL BE GALVANIZED.

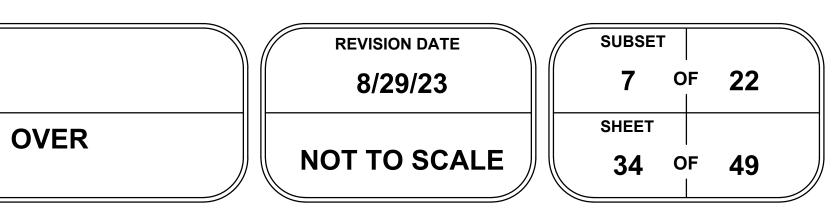

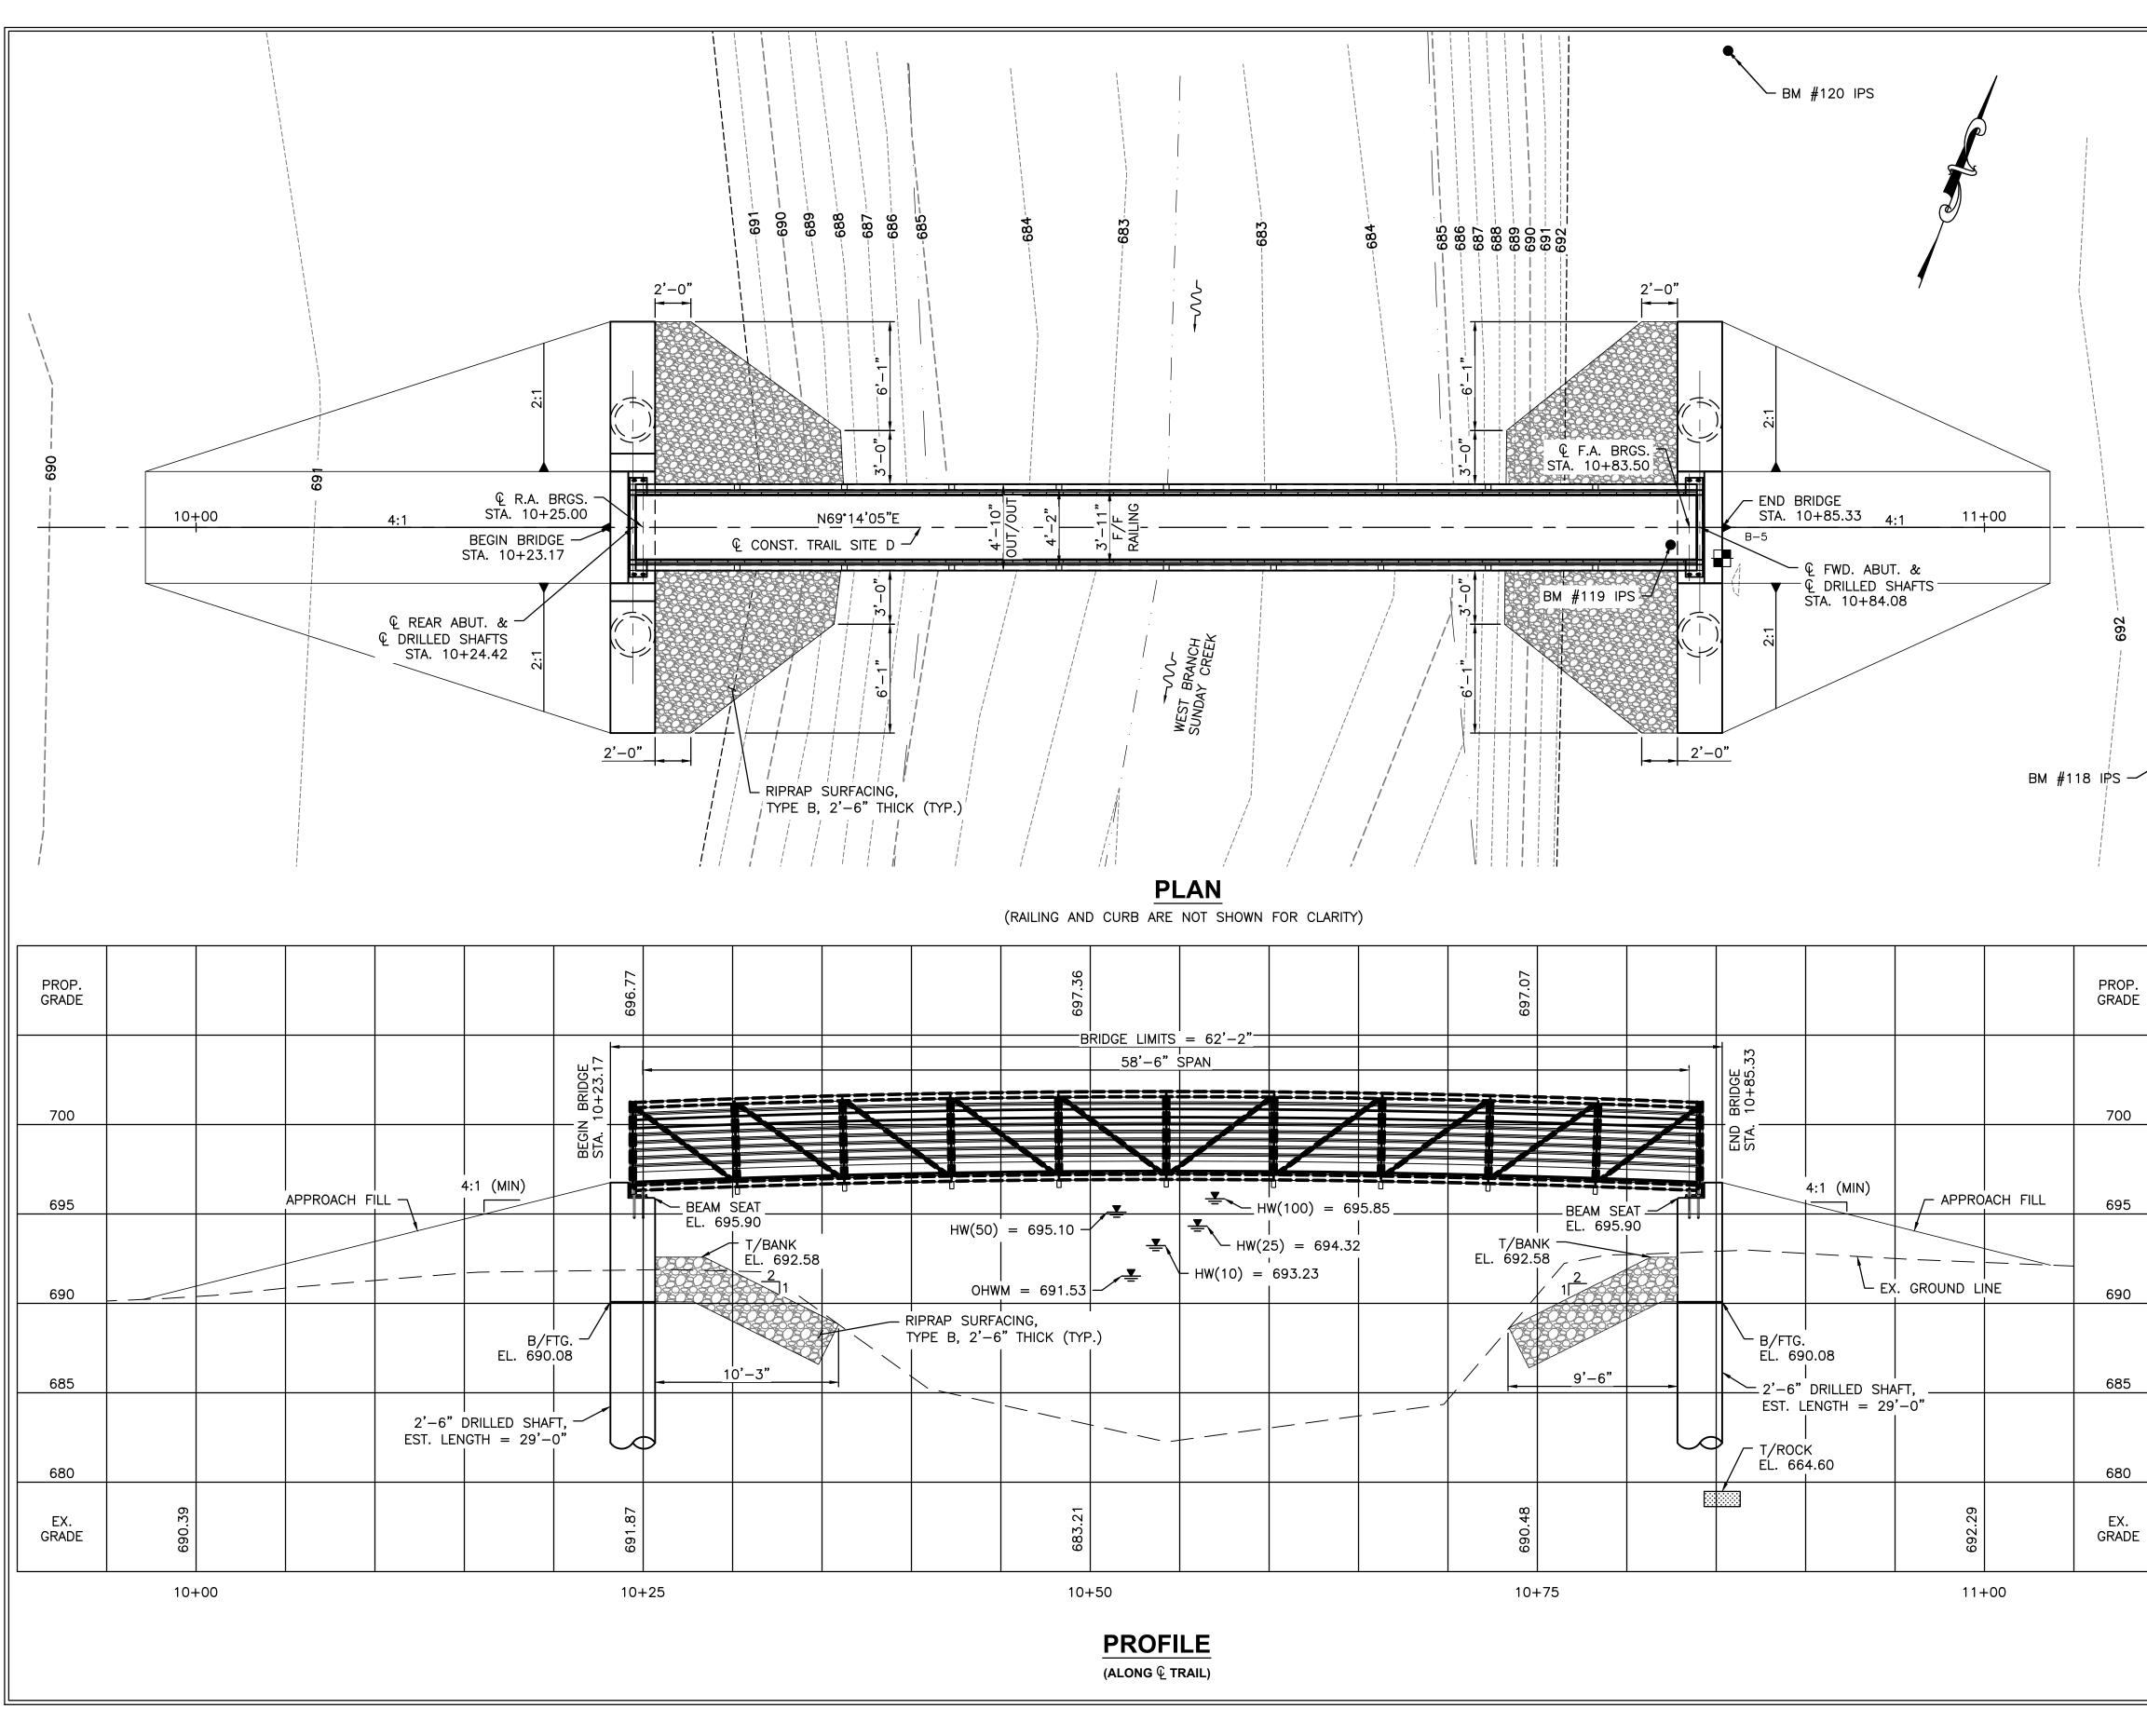




**DESIGNED BY:** JYM CHECKED BY: PES **REVIEWED BY:** TML

**PROJECT NAME & LOCATION** 

m l

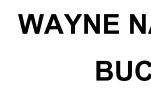

WAYNE NATIONAL FOREST TRAIL BRIDGES **BUCKEYE TRAILS ASSOCIATION** 

DRAWING NAME

BRIDGE

SITE PLAN

SITE D - TRAIL OVER W BRANCH SUNDAY CREEK

	BENCHMARK AND CONTROL DATA											
CONTROL POINT.	DESCRIPTION	NORTHING	EASTING	ELEV.	STATION	OFFSET						
BM#100	IRON PIN	576829.572	2054105.708	1056.709								
BM#118	IRON PIN	557544.953	2080784.072	691.694	11+42.43	18.76' RT						
BM#119	IRON PIN	557538.987	2080718.182	693.130	10+78.70	0.98' RT						
BM#120	IRON PIN	557585.048	2080703.674	693.224	10+81.47	47.24' LT						
B.A	BEGIN ALIGNMENT	557511.999	2080644.246	SEE PROFILE	10+00.00	0'						
CL R.A.	POINT ALONG ALIGNMENT	557519.325	2080663.571	SEE PROFILE	10+20.67	0'						
CL F.A.	POINT ALONG ALIGNMENT	557540.479	2080719.361	SEE PROFILE	10+80.33	0'						
E.A.	END ALIGNMENT	557565.179	2080784.503	SEE PROFILE	11+50.00	0'						

FOR ADDITIONAL BENCHMARK INFORMATION, SEE GENERAL NOTES SHEET 3/49.

LEGEND

BORING LOCATION

RIPRAP SURFACING, TYPE B, 2'-6" THICK


**HYDRAULIC DATA** 


DRAINAGE AREA = 32.9 SQ.	MILES	
Q (10) = 2760 CFS	V (10) = 7.82 FT/S	DESIGN
Q (25) = 3640 CFS	V (25) = 8.42 FT/S	SCOUR DESIGN
Q (50) = 4350 CFS	V (50) = 8.82 FT/S	SCOUR CHECK
Q (100) = 5100 CFS	V(100) = 9.22  FT/S	FEMA
STRUCTURE CLEARS THE 10	0-YEAR HIGH WATER ELEVATION	BY 0.24 FEET.

STRUCTURE IS LOCATED IN FEMA ZONE A.



PREFABRICATED STEEL TRUSS ON STUB ABUTMENTS ON SPREAD FOOTINGS. TYPE: SPANS: 58'-6" C/C BRGS. (INSIDE BOLT) TRAIL: 3'-11" CLEAR WIDTH BTW. RUB RAILS LOADING: 0.090 KSF PEDESTRIAN SKEW: NONE ALIGNMENT: TANGENT CROWN: NONE 39°31'48.72"N COORDINATES: LATITUDE LONGITUDE 82°6'9.36"W

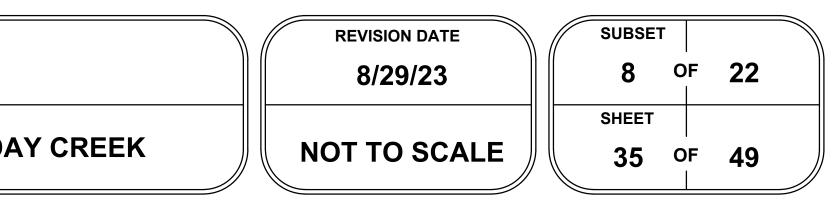

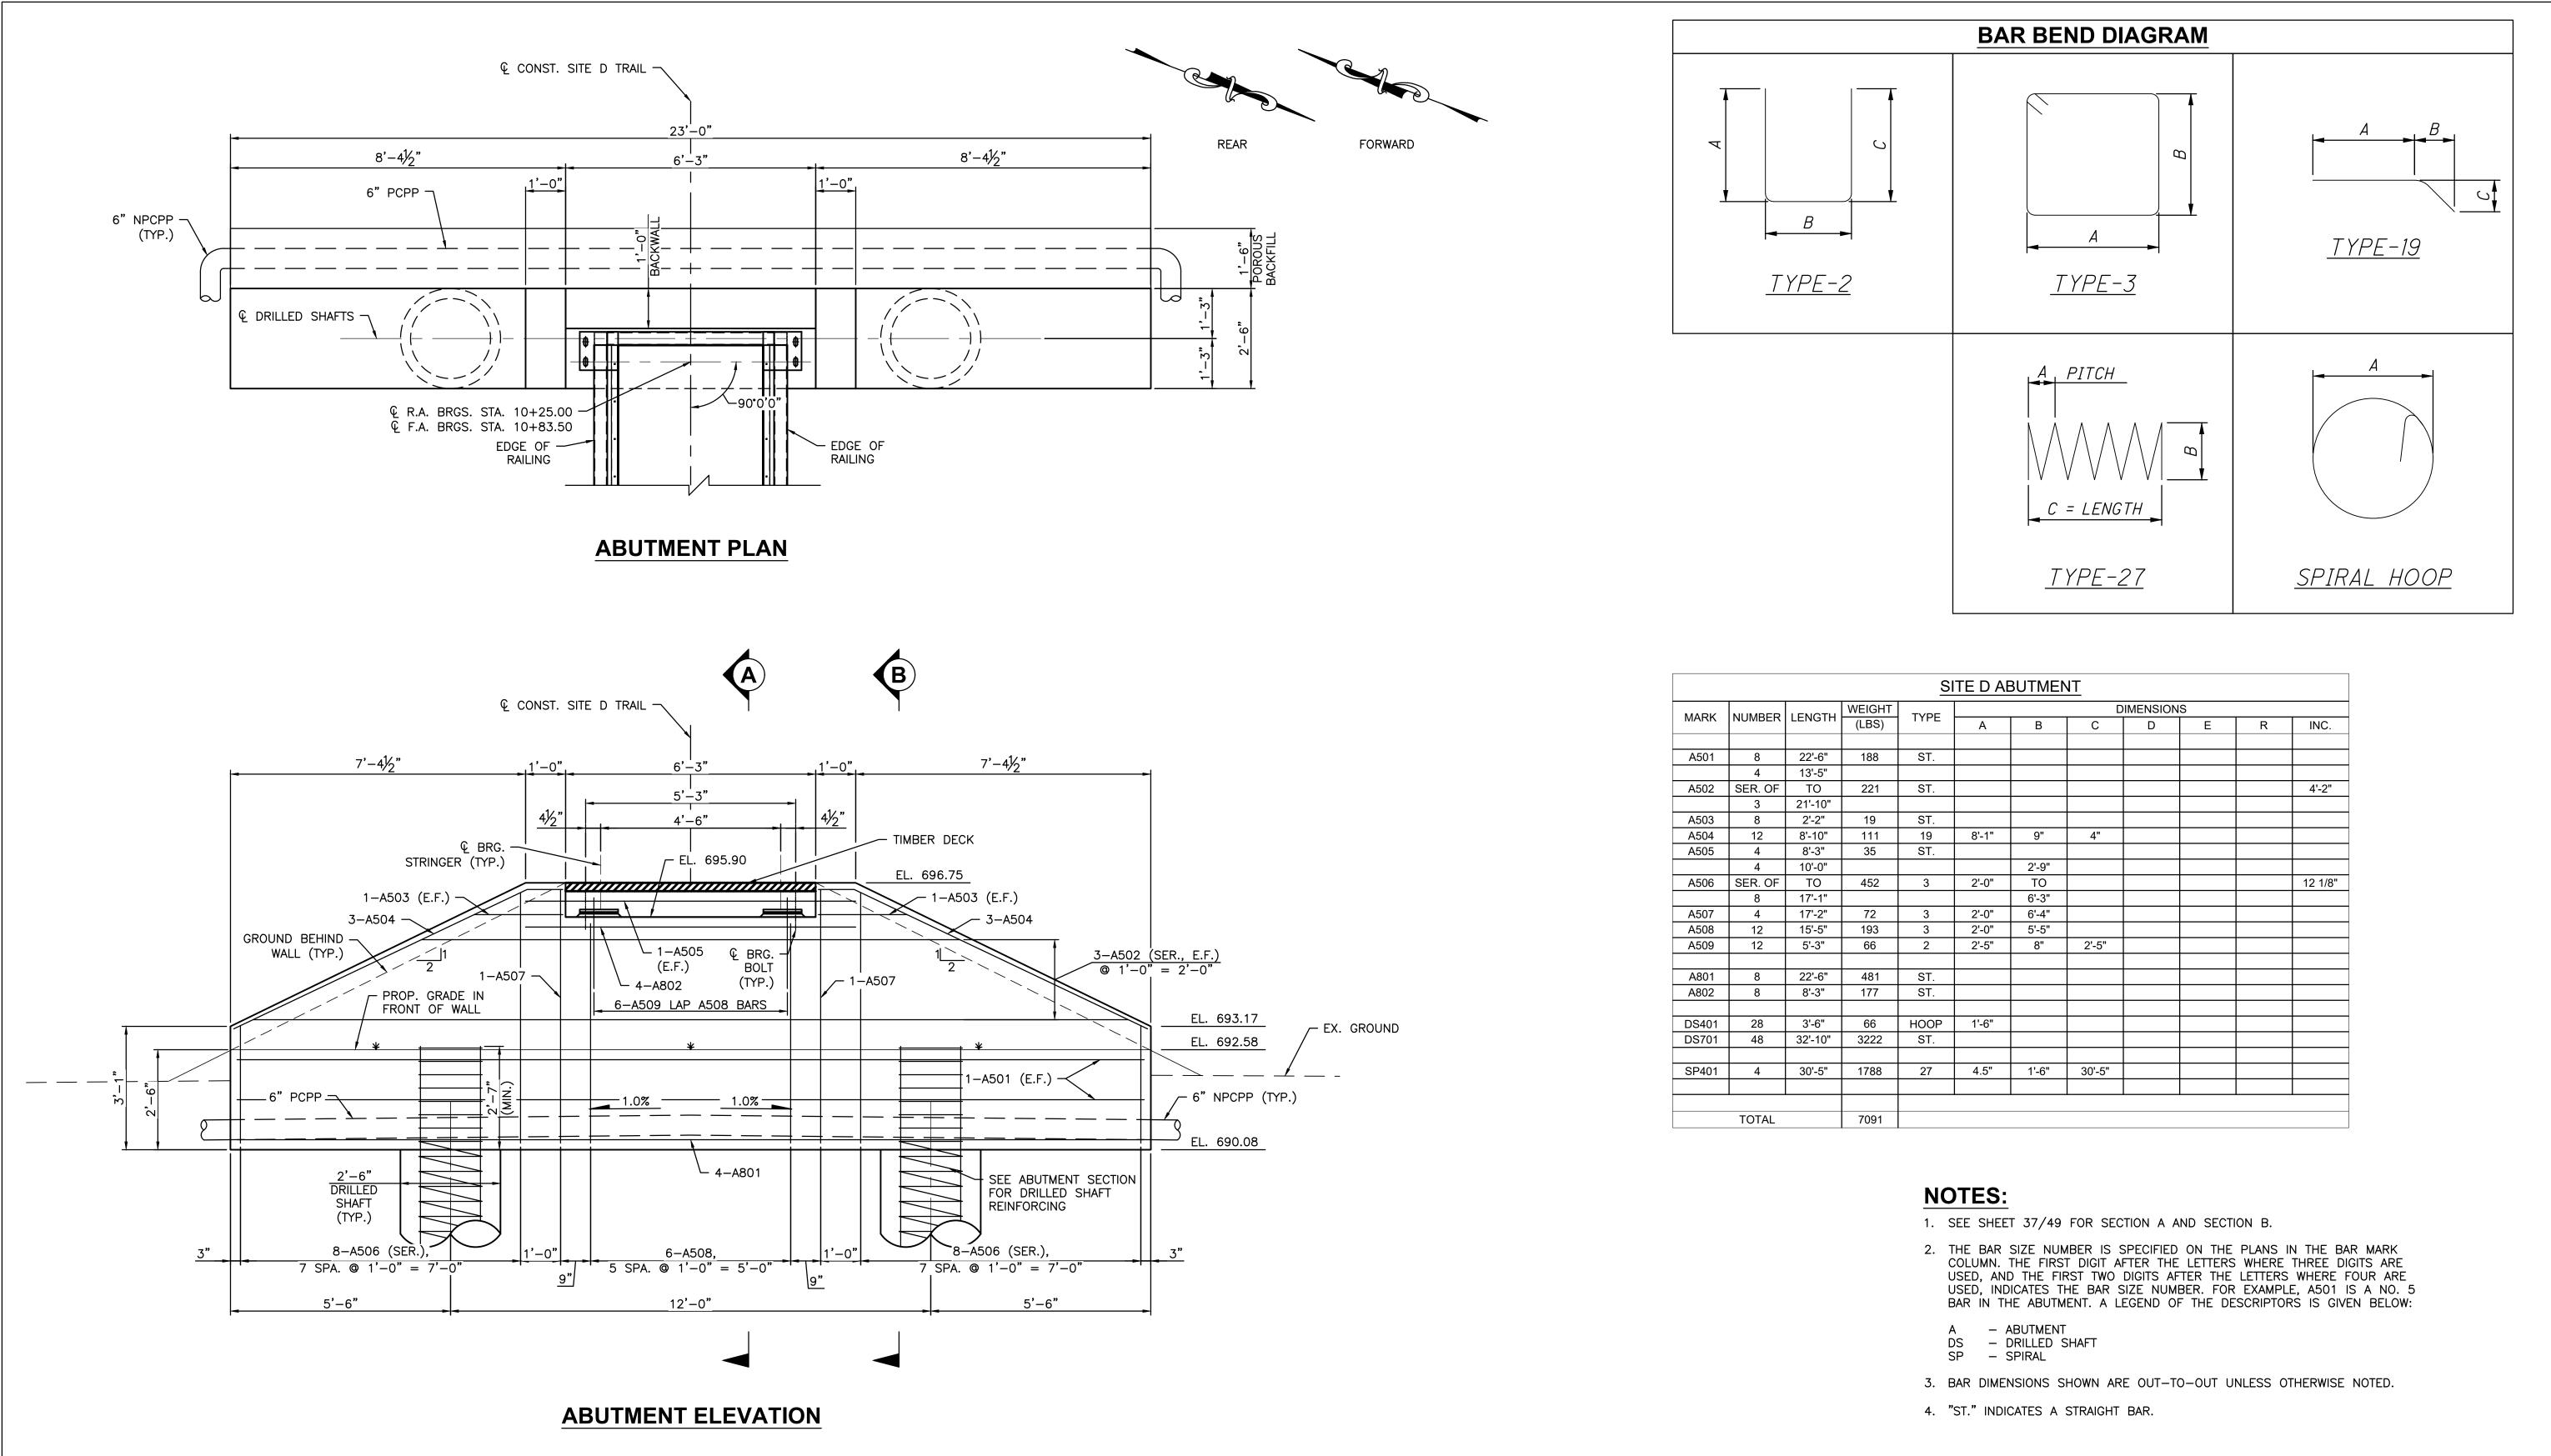



		WEIGHT
NUNDER	LENGTH	(LBS)
8	22'-6"	188
4	13'-5"	
SER. OF	ТО	221
3	21'-10"	
8	2'-2"	19
12	8'-10"	111
4	8'-3"	35
4	10'-0"	
SER. OF	то	452
8	17'-1"	
4	17'-2"	72
12	15'-5"	193
12	5'-3"	66
8	22'-6"	481
8	8'-3"	177
28	3'-6"	66
48	32'-10"	3222
4	30'-5"	1788
TOTAL		
	8 4 SER. OF 3 8 12 4 4 4 5ER. OF 8 4 12 12 12 12 12 12 8 8 8 8 8 8 28 48 28 48	4    13'-5"      SER. OF    TO      3    21'-10"      8    2'-2"      12    8'-10"      4    8'-3"      4    10'-0"      SER. OF    TO      8    17'-1"      4    17'-2"      12    5'-3"      12    5'-3"      8    22'-6"      8    8'-3"      28    3'-6"      48    32'-10"      4    30'-5"


DRAWING NAME


BRIDGE


**ABUTMENT PLAN AND ELEVATION** 


SITE D - TRAIL OVER W BRANCH SUNDAY CREEK

SI	TE D A	BUTMEN	NT_					
TYPE	DIMENSIONS							
	А	В	С	D	E	R	INC.	
ST.								
01.								
ST.							4'-2"	
ST.								
19	8'-1"	9"	4"					
ST.								
		2'-9"						
3	2'-0"	ТО					12 1/8"	
		6'-3"						
3	2'-0"	6'-4"						
3	2'-0"	5'-5"						
2	2'-5"	8"	2'-5"					
ST.								
ST.								
HOOP	1'-6"							
ST.								
27	4.5"	1'-6"	30'-5"					
		I	· · · · · · · · · · · · · · · · · · ·		I	L		

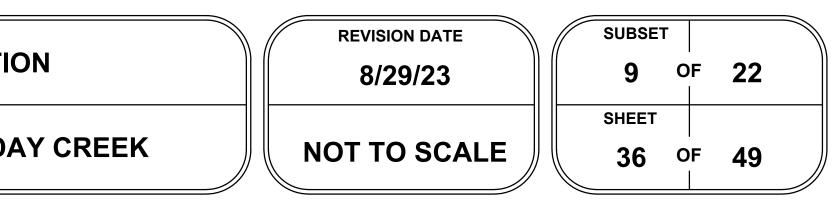

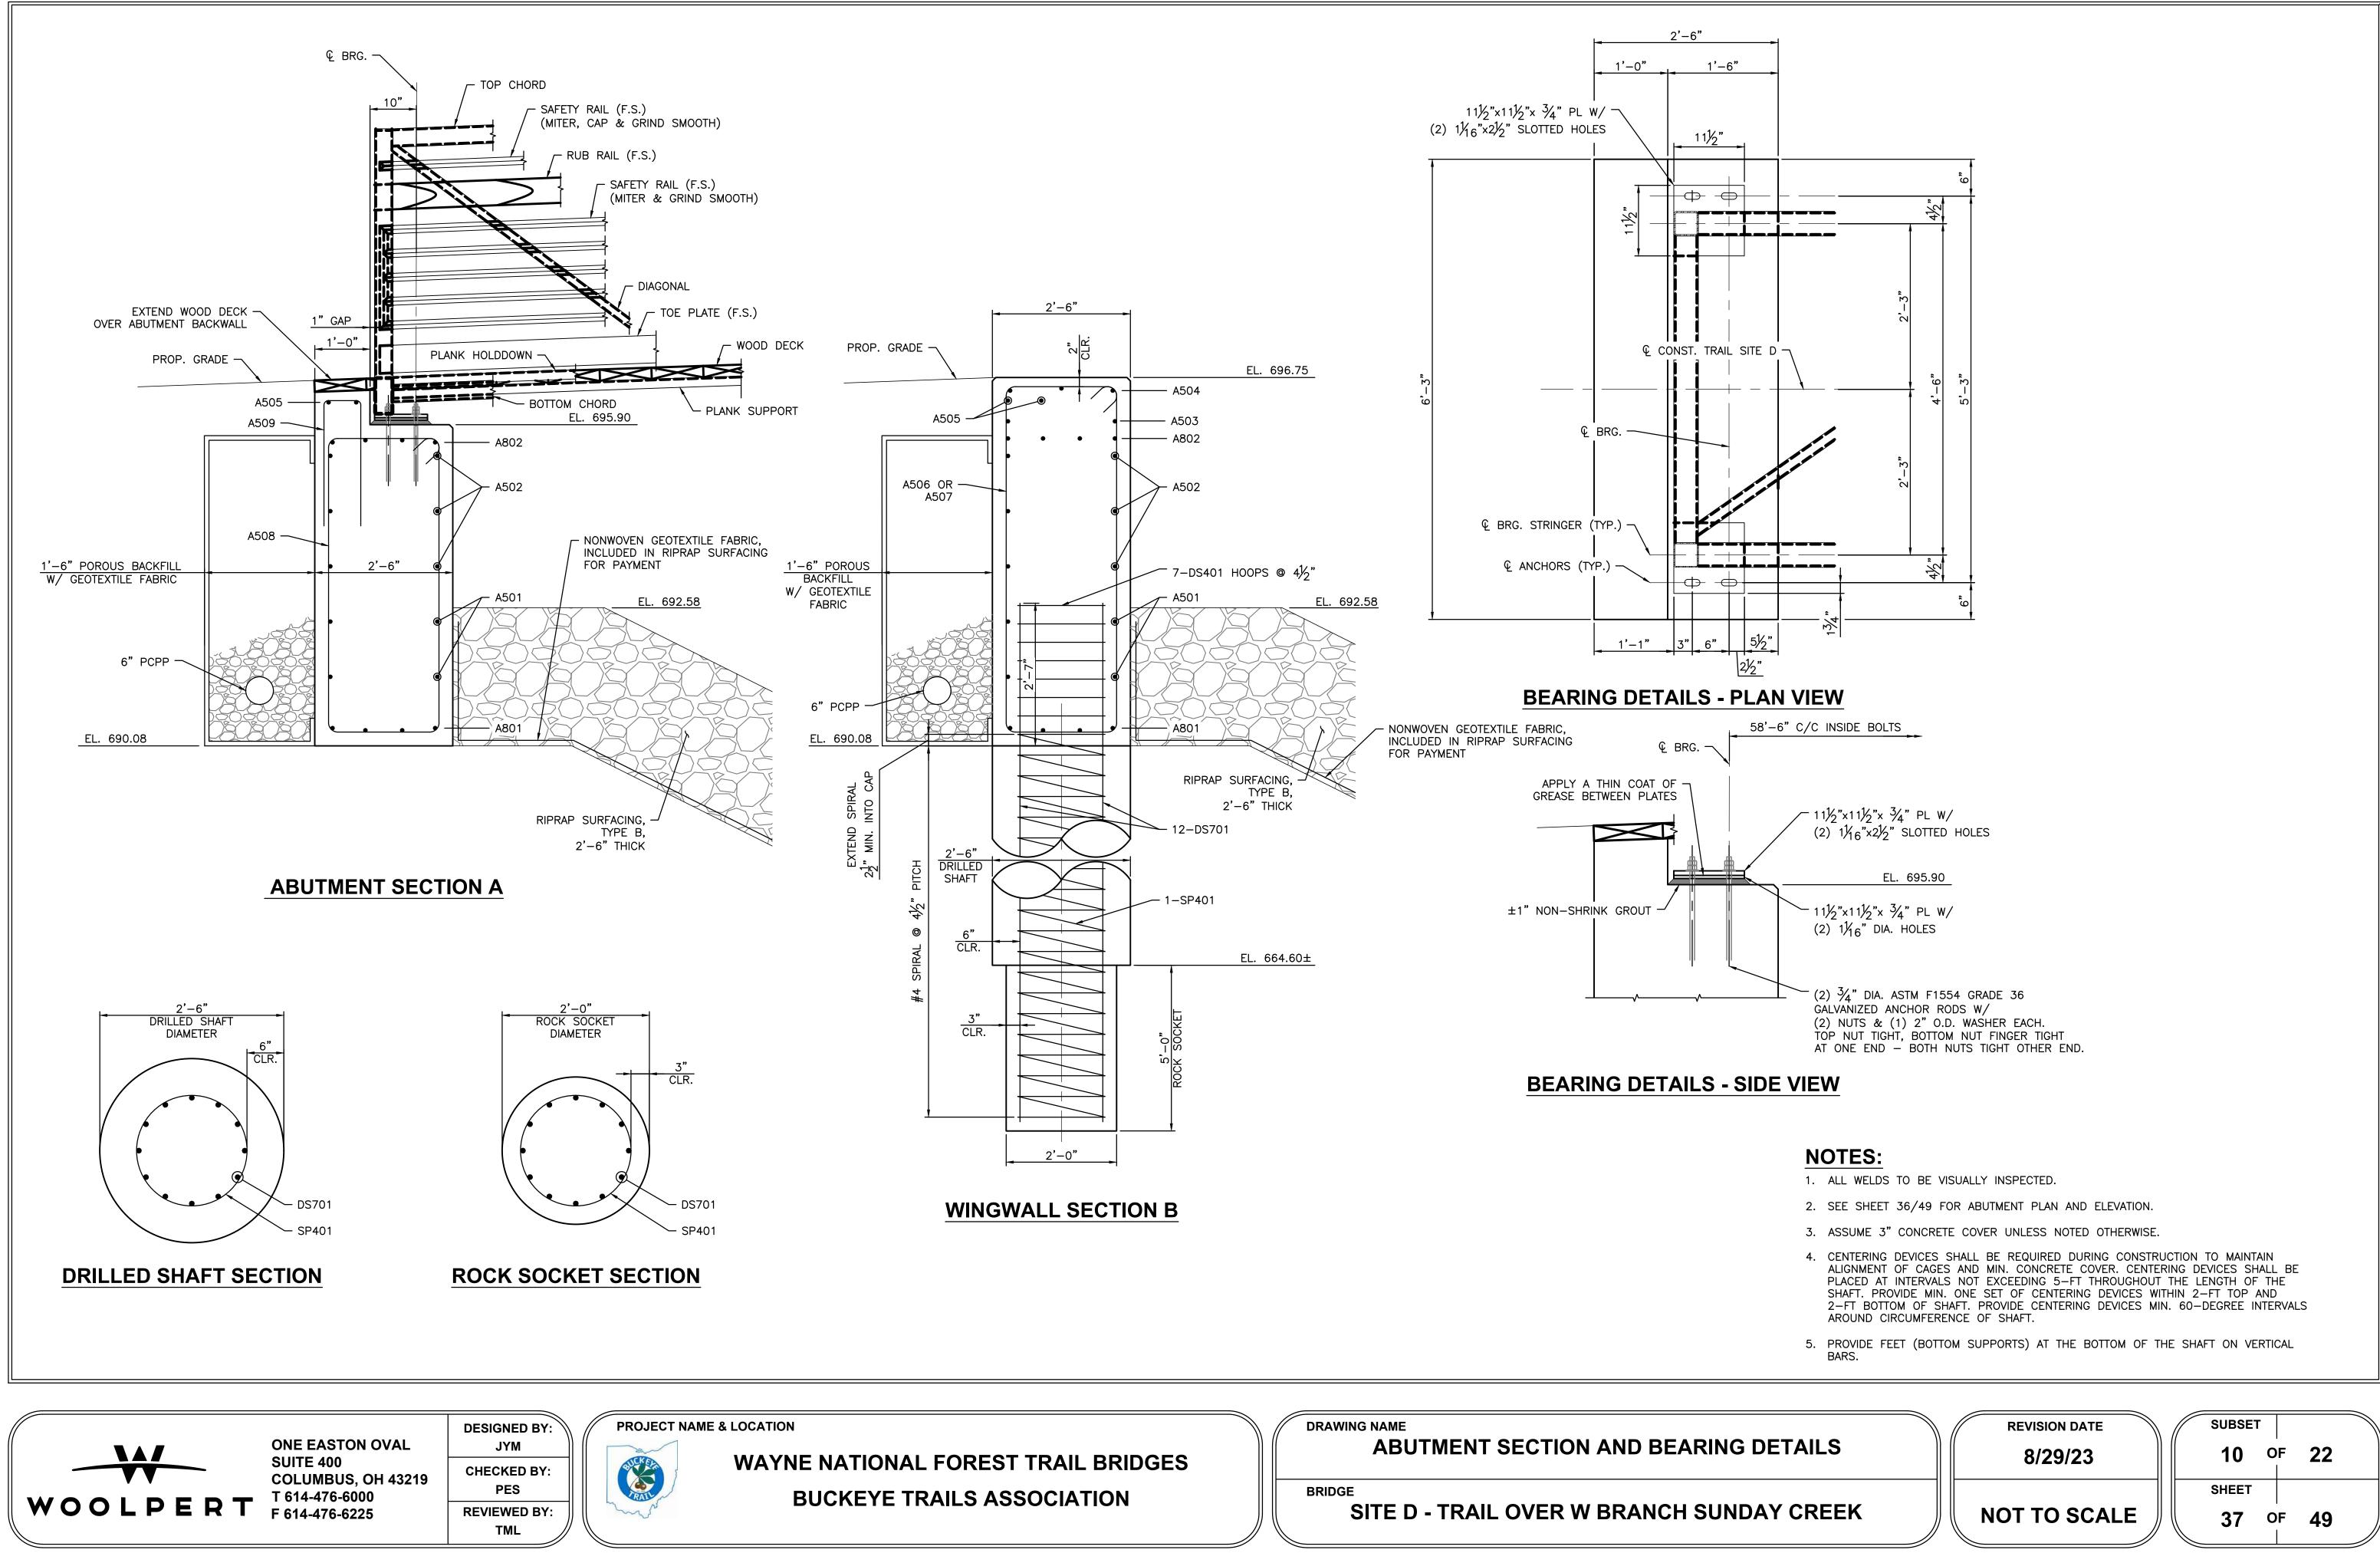

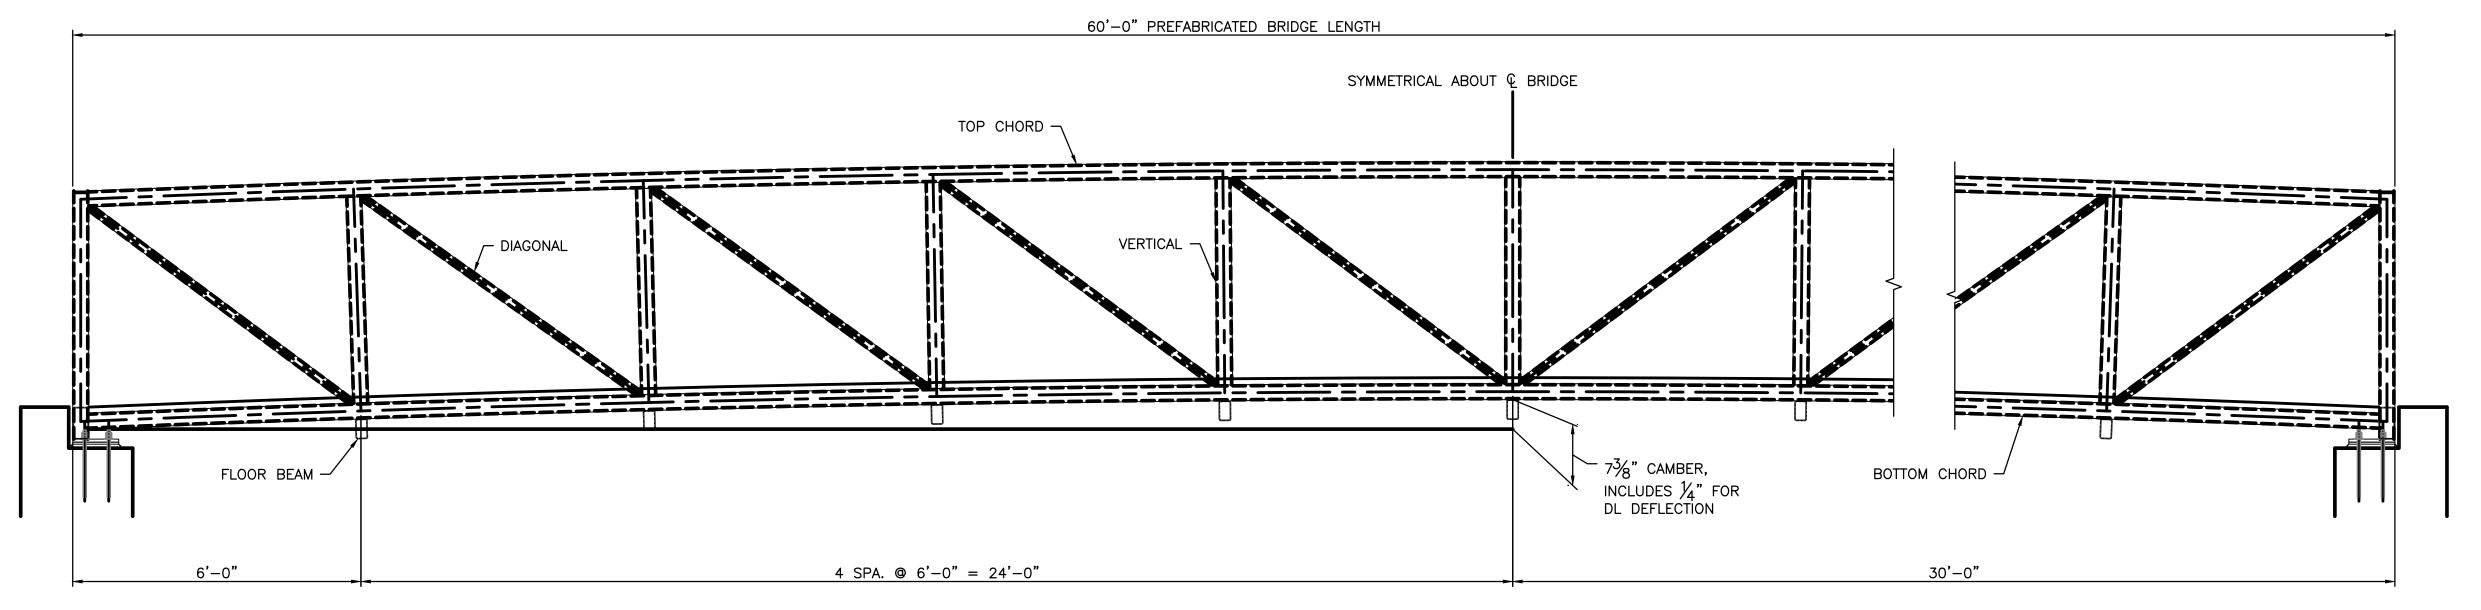

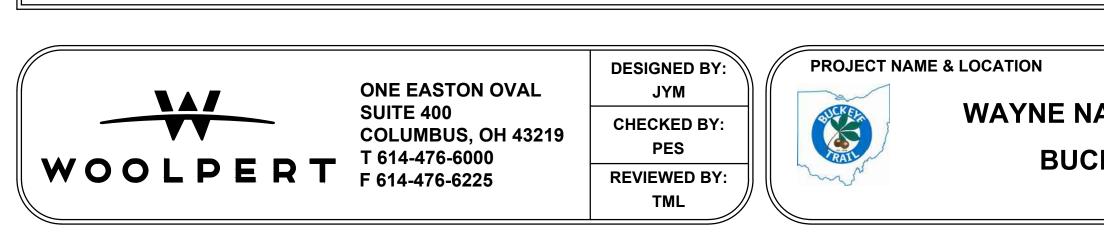

# ELEVATION

(RUNNING PLANKS AND DECK PLANKS NOT SHOWN FOR CLARITY)


WAYNE NATIONAL FOREST TRAIL BRIDGES **BUCKEYE TRAILS ASSOCIATION** 


DRAWING NAME

**TRUSS ELEVATION** 


BRIDGE SITE D - TRAIL OVER W BRANCH SUNDAY CREEK


- 1. VERTICALS TO BE FANNED, INSTALLED PERPENDICULAR TO THE BOTTOM CHORD.
- 2. SAFETY RAILS, RUB RAIL, AND TOW PLATE NOT SHOWN FOR CLARITY. SEE SHEET 39 FOR TRANSVERSE SECTION.
- 3. SEE SHEET 37 FOR ABUTMENT SECTION.

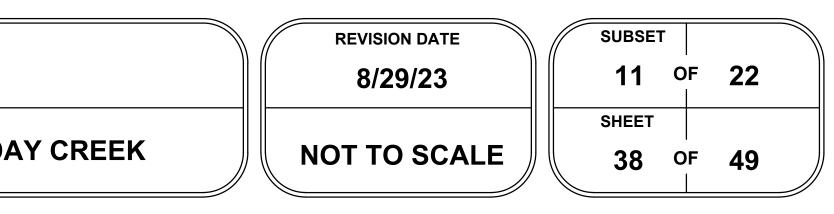

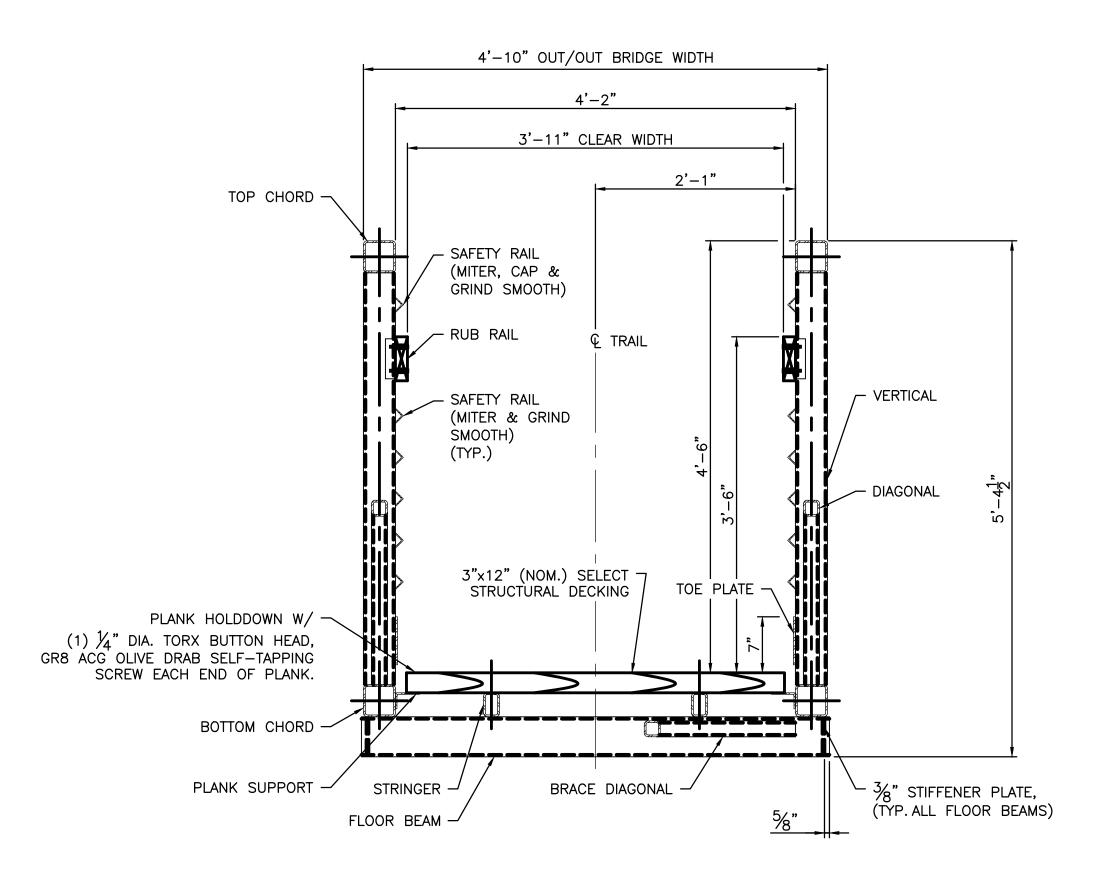

# **TRANSVERSE SECTION**

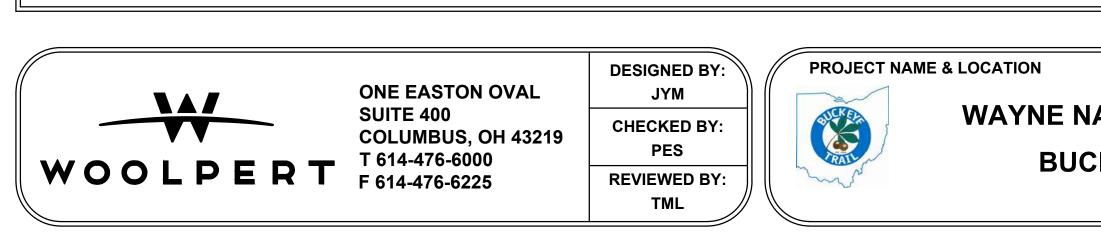

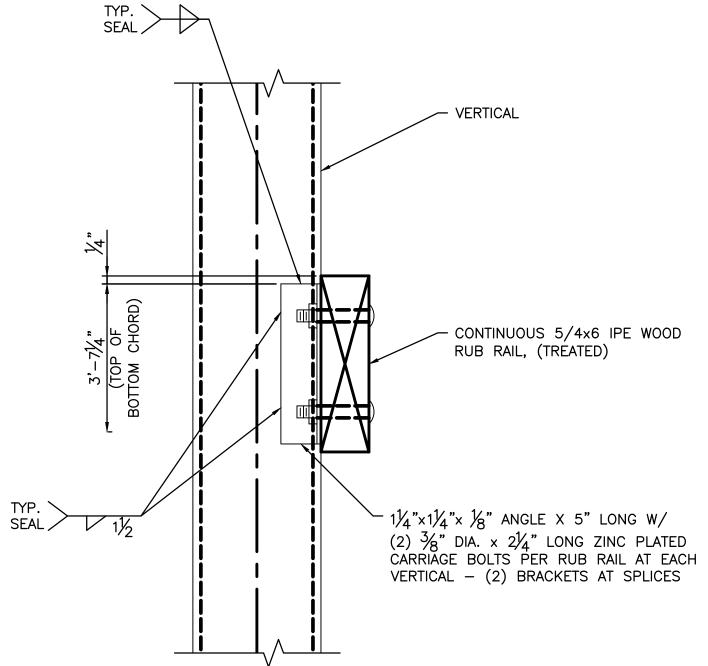

### **RUB RAIL DETAIL**

# WAYNE NATIONAL FOREST TRAIL BRIDGES **BUCKEYE TRAILS ASSOCIATION**


DRAWING NAME


BRIDGE

## **TRANSVERSE SECTION**

SITE D - TRAIL OVER W BRANCH SUNDAY CREEK

- 1. SPACING OF SAFETY RAILS, RUB RAIL, AND TOE PLATE PRODUCE MAXIMUM OPENINGS OF LESS THAN 4", UP TO A HEIGHT OF 54".
- 2. REFER TO USFS STD-964-10-2A FOR ADDITIONAL DETAILS.

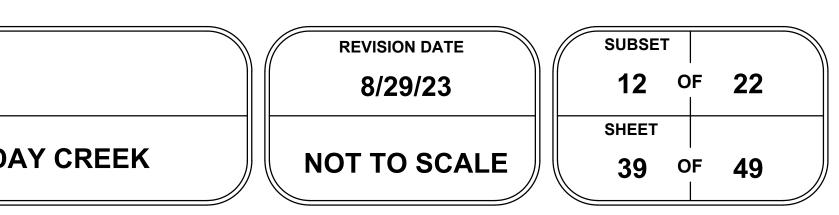

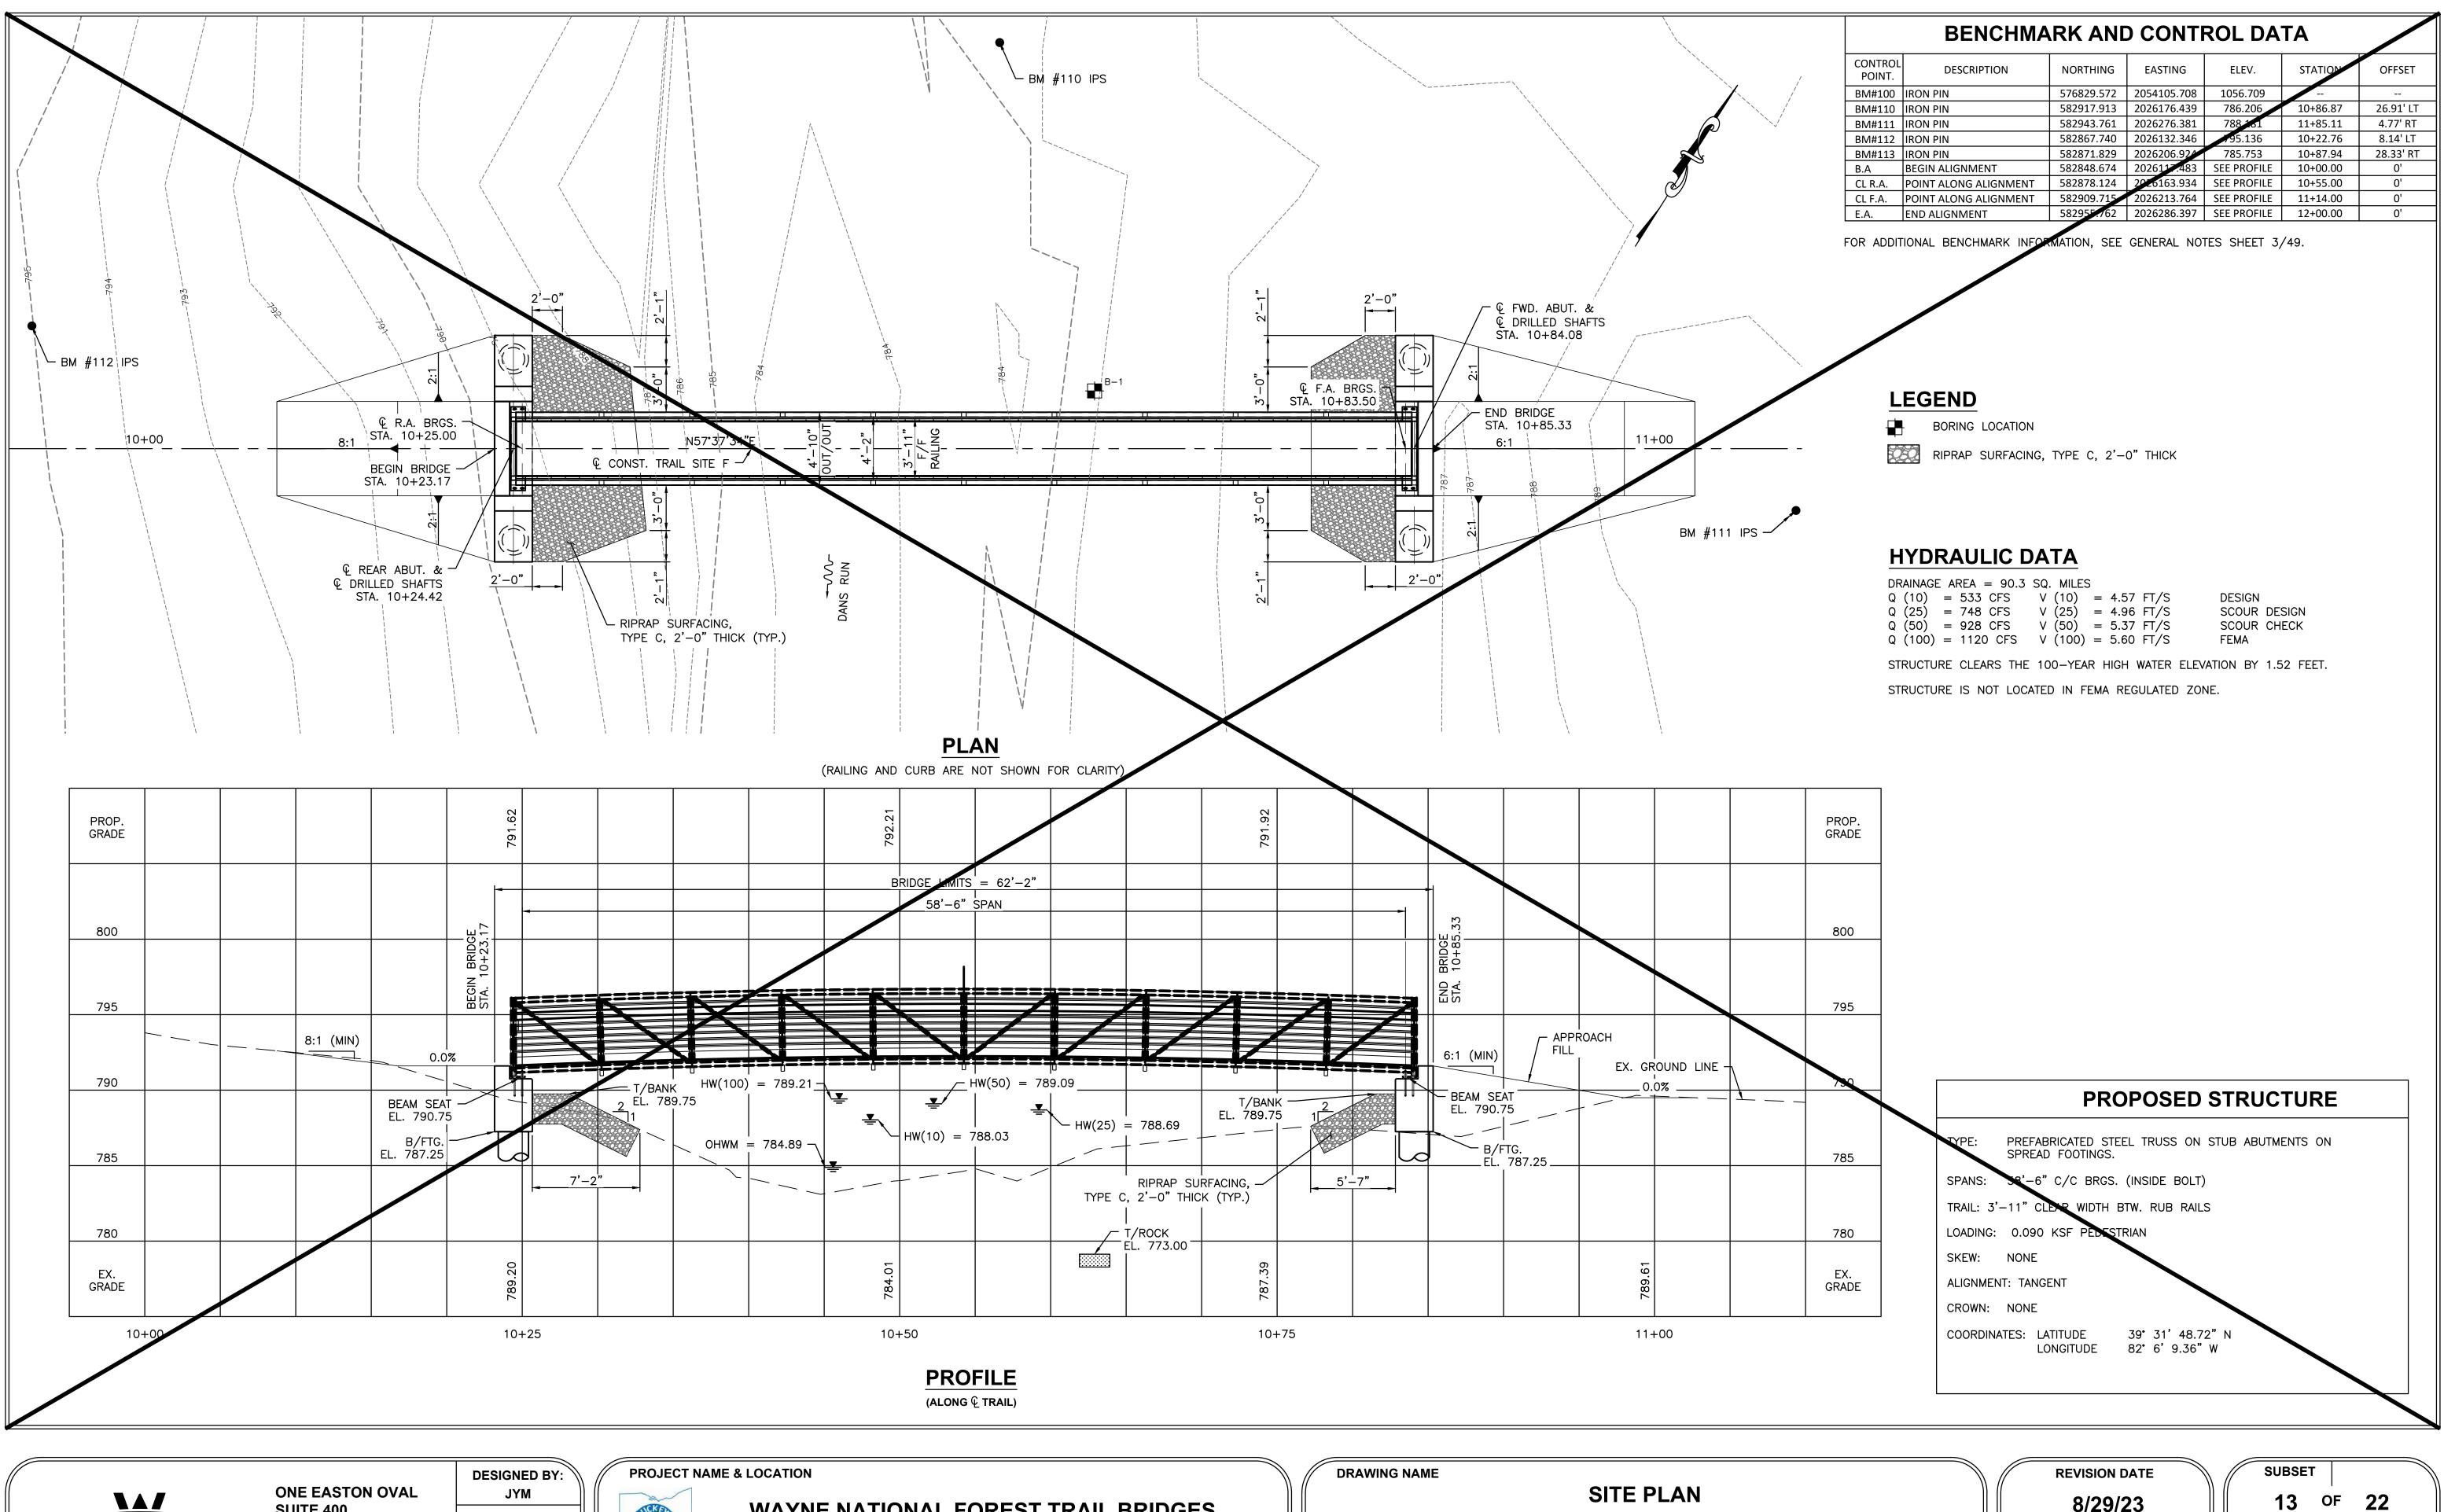

SUITE 400 COLUMBUS, OH 43219 T 614-476-6000 F 614-476-6225 WOOLPERT

CHECKED BY: PES **REVIEWED BY:** TML




WAYNE NATIONAL FOREST TRAIL BRIDGES **BUCKEYE TRAILS ASSOCIATION** 

BRIDGE

SITE PLAN OF **22** 13 8/29/23 SHEET SITE F - TRAIL OVER DANS RUN NOT TO SCALE 40 OF 49

	BENCHMARK AND CONTROL DATA							
CONTROL POINT.	DESCRIPTION	NORTHING	EASTING	ELEV.	STATION	OFFSET		
BM#100	IRON PIN	576829.572	2054105.708	1056.709				
BM#110	IRON PIN	582917.913	2026176.439	786.206	10+86.87	26.91' LT		
BM#111	IRON PIN	582943.761	2026276.381	788 161	11+85.11	4.77' RT		
BM#112	IRON PIN	582867.740	2026132.346	195.136	10+22.76	8.14' LT		
BM#113	IRON PIN	582871.829	2026206.924	785.753	10+87.94	28.33' RT		
B.A	BEGIN ALIGNMENT	582848.674	2026117.483	SEE PROFILE	10+00.00	0'		
CL R.A.	POINT ALONG ALIGNMENT	582878.124	2026163.934	SEE PROFILE	10+55.00	0'		
CL F.A.	POINT ALONG ALIGNMENT	582909.715	2026213.764	SEE PROFILE	11+14.00	0'		
E.A.	END ALIGNMENT	582955.762	2026286.397	SEE PROFILE	12+00.00	0'		
FOR ADDITIONAL BENCHMARK INFORMATION, SEE GENERAL NOTES SHEET 3/49.								

DRAINAGE AREA = $90.3$ Q (10) = $533$ CFS Q (25) = 748 CFS Q (50) = $928$ CFS Q (100) = $1120$ CFS	V (10) = 4.57 FT/S V (25) = 4.96 FT/S V (50) = 5.37 FT/S	DESIGN SCOUR DESIGN SCOUR CHECK FEMA
STRUCTURE CLEARS THE	100–YEAR HIGH WATER	ELEVATION BY 1.52 FEET.

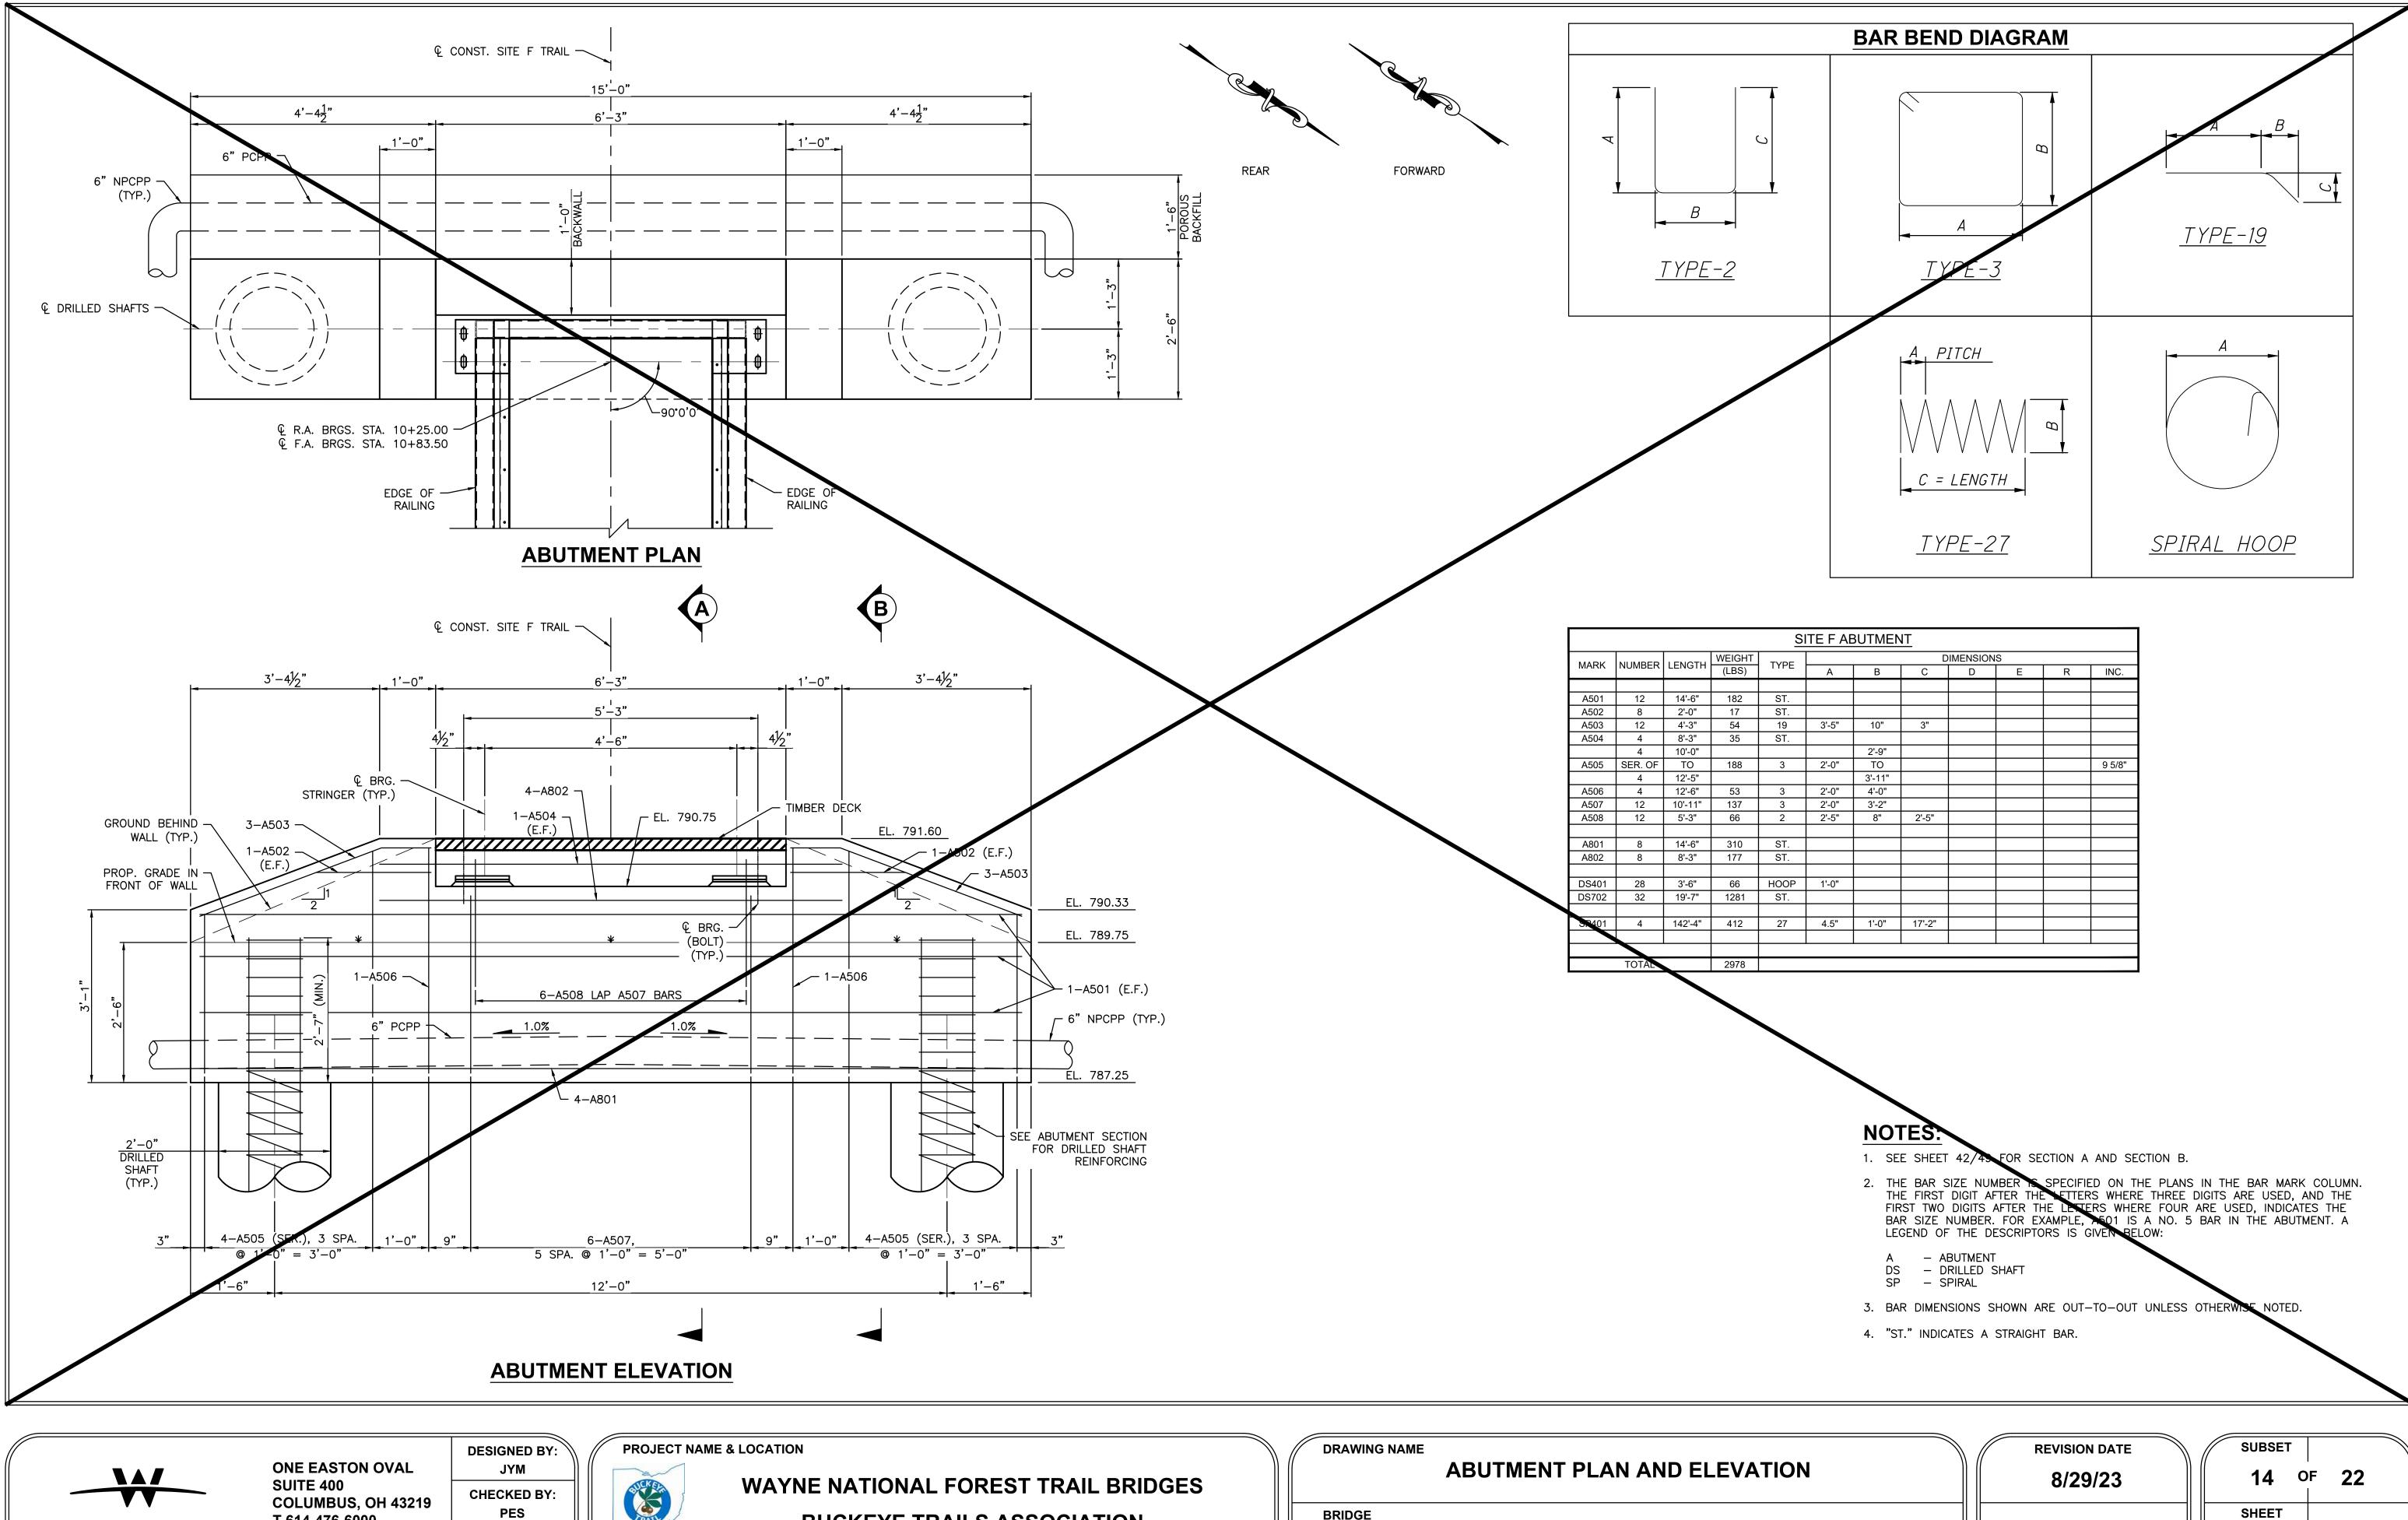

# **BUCKEYE TRAILS ASSOCIATION**

T 614-476-6000 F 614-476-6225

**REVIEWED BY:** 


TML


WOOLPERT

BRIDGE


SITE F - TRAIL OVER DANS RUN


S	SITE F ABUTMENT								
	DIMENSIONS								
YPE	Α	В	С	D	Е	R	INC.		
ST.									
ST.									
19	3'-5"	10"	3"						
ST.									
		2'-9"							
3	2'-0"	TO					9 5/8"		
		3'-11"							
3	2'-0"	4'-0"							
3	2'-0"	3'-2"							
2	2'-5"	8"	2'-5"						
ST.									
ST.									
OOP	1'-0"								
ST.									
27	4.5"	1'-0"	17'-2"						

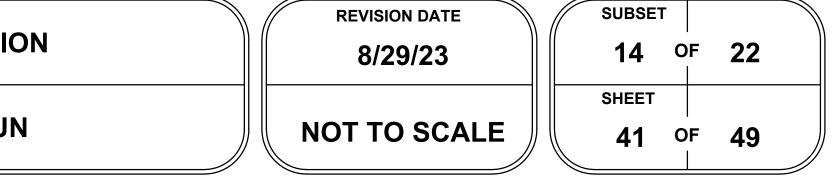


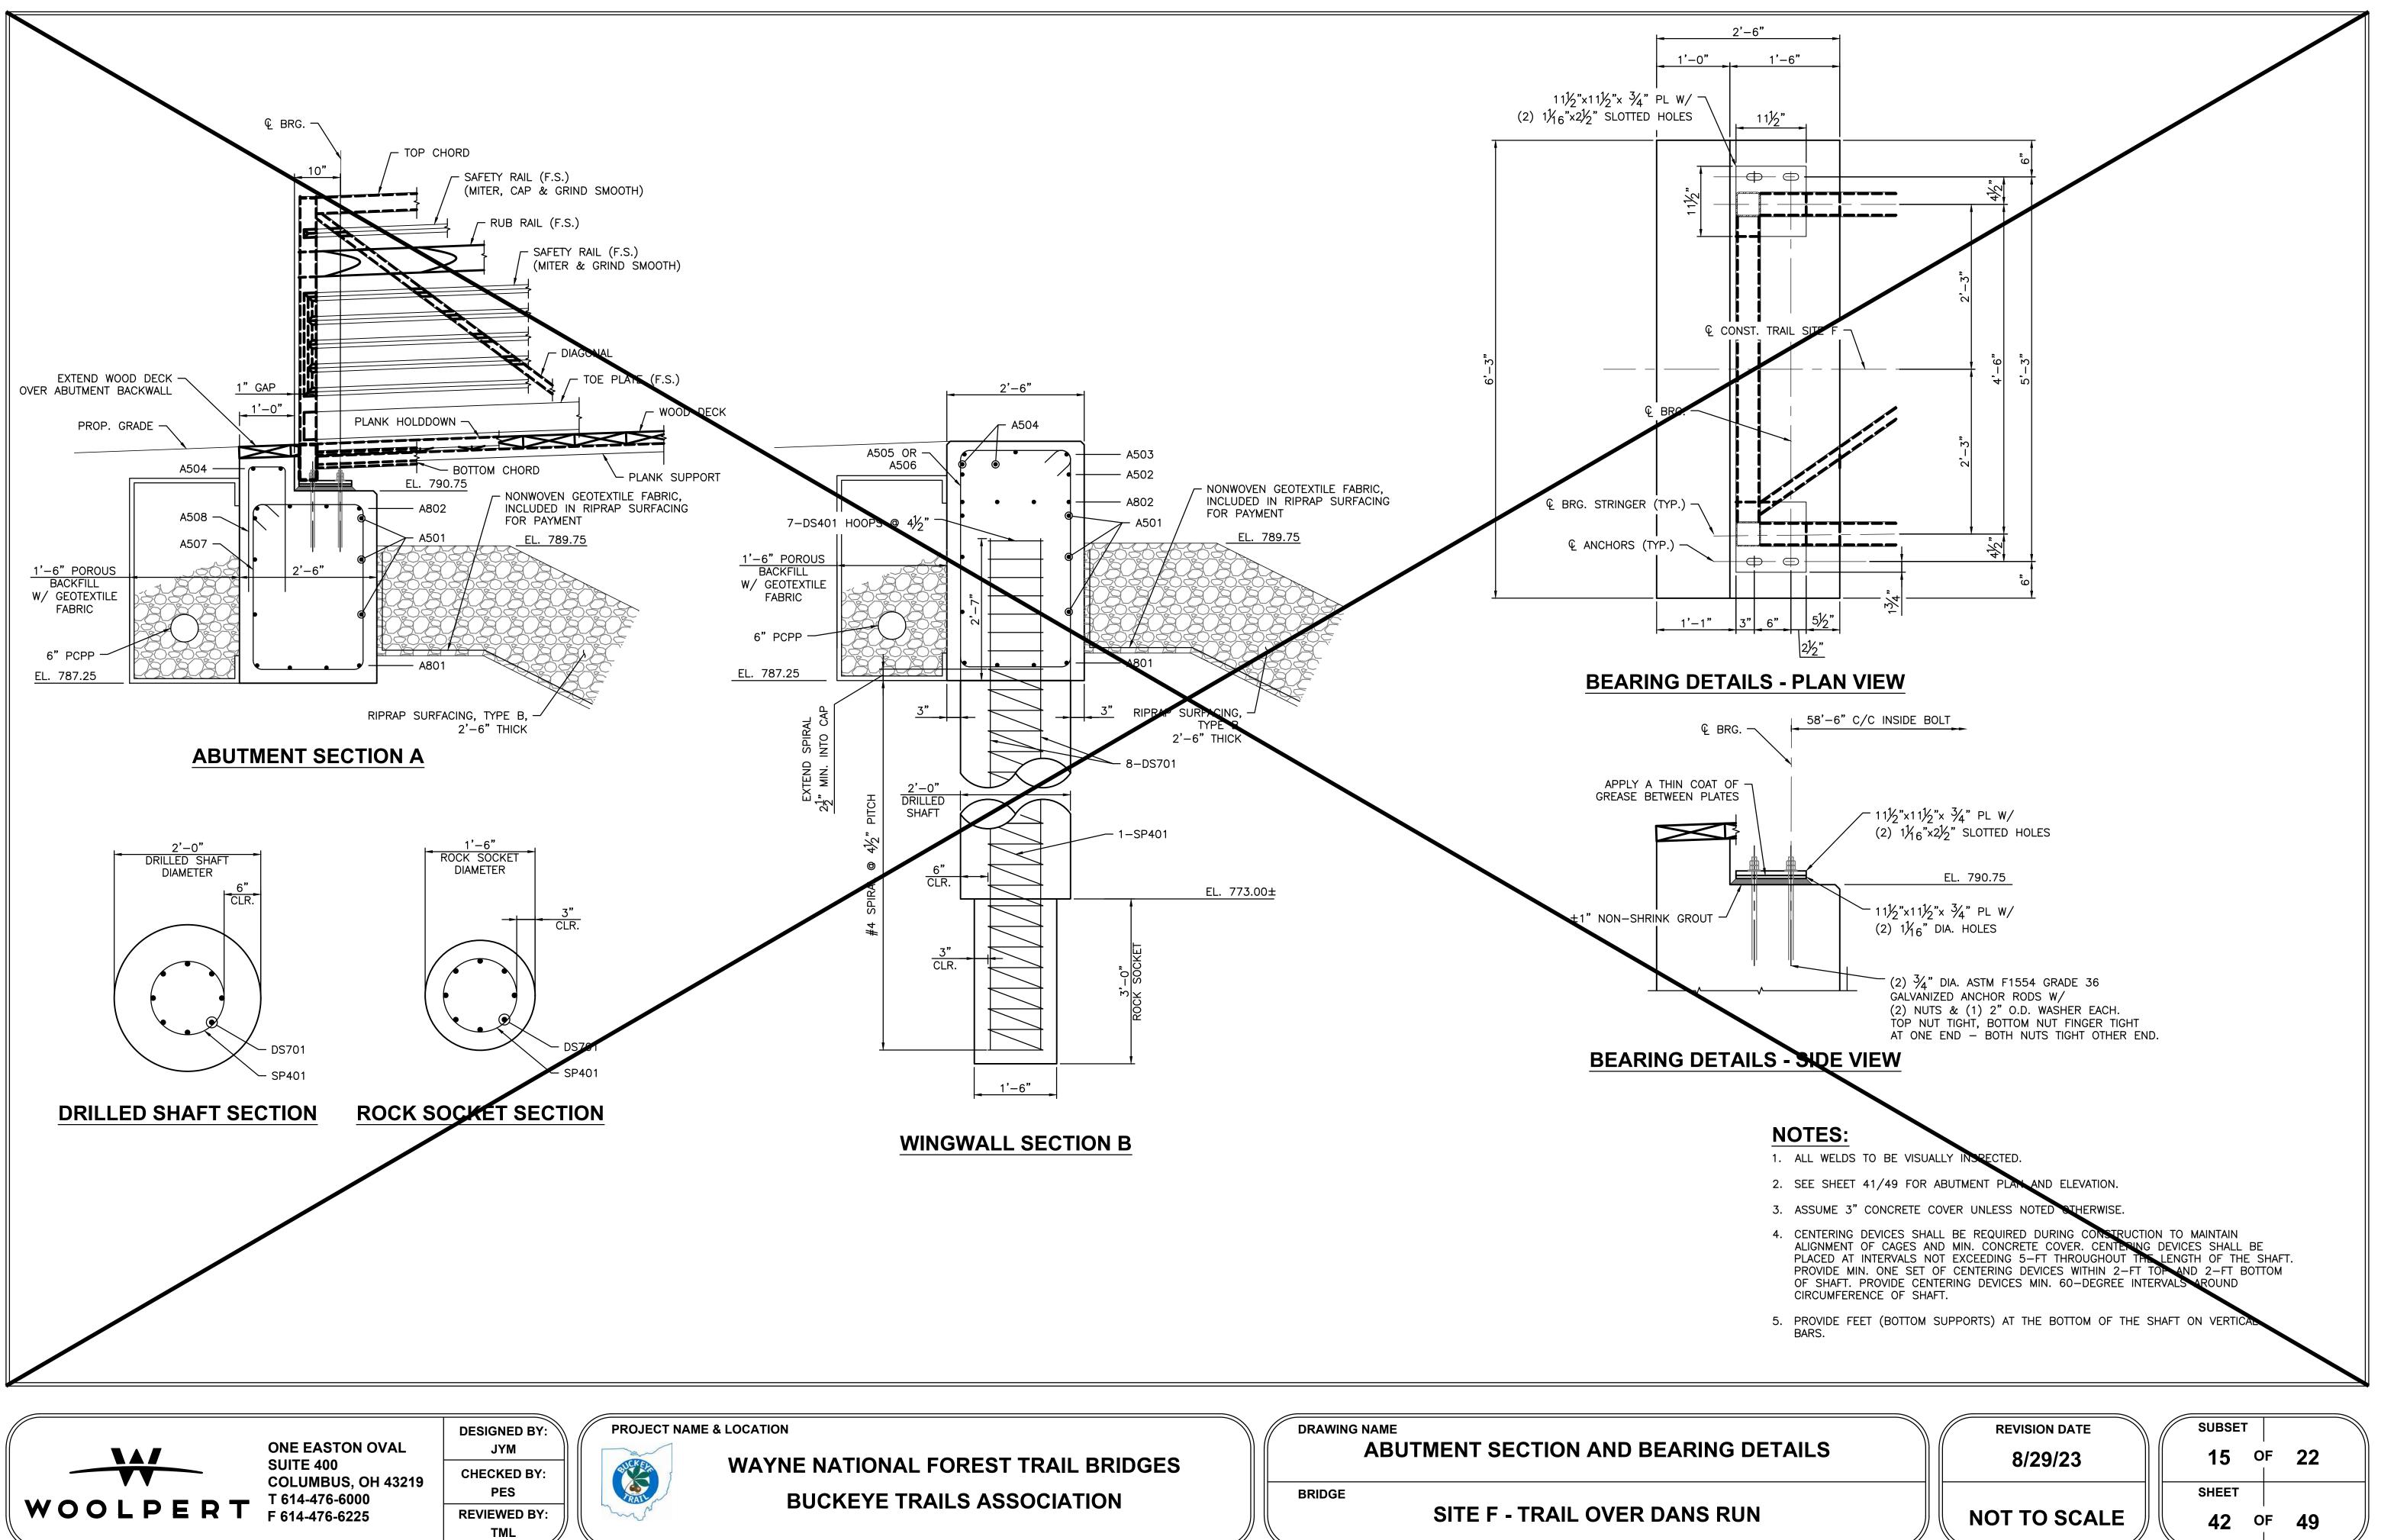

N

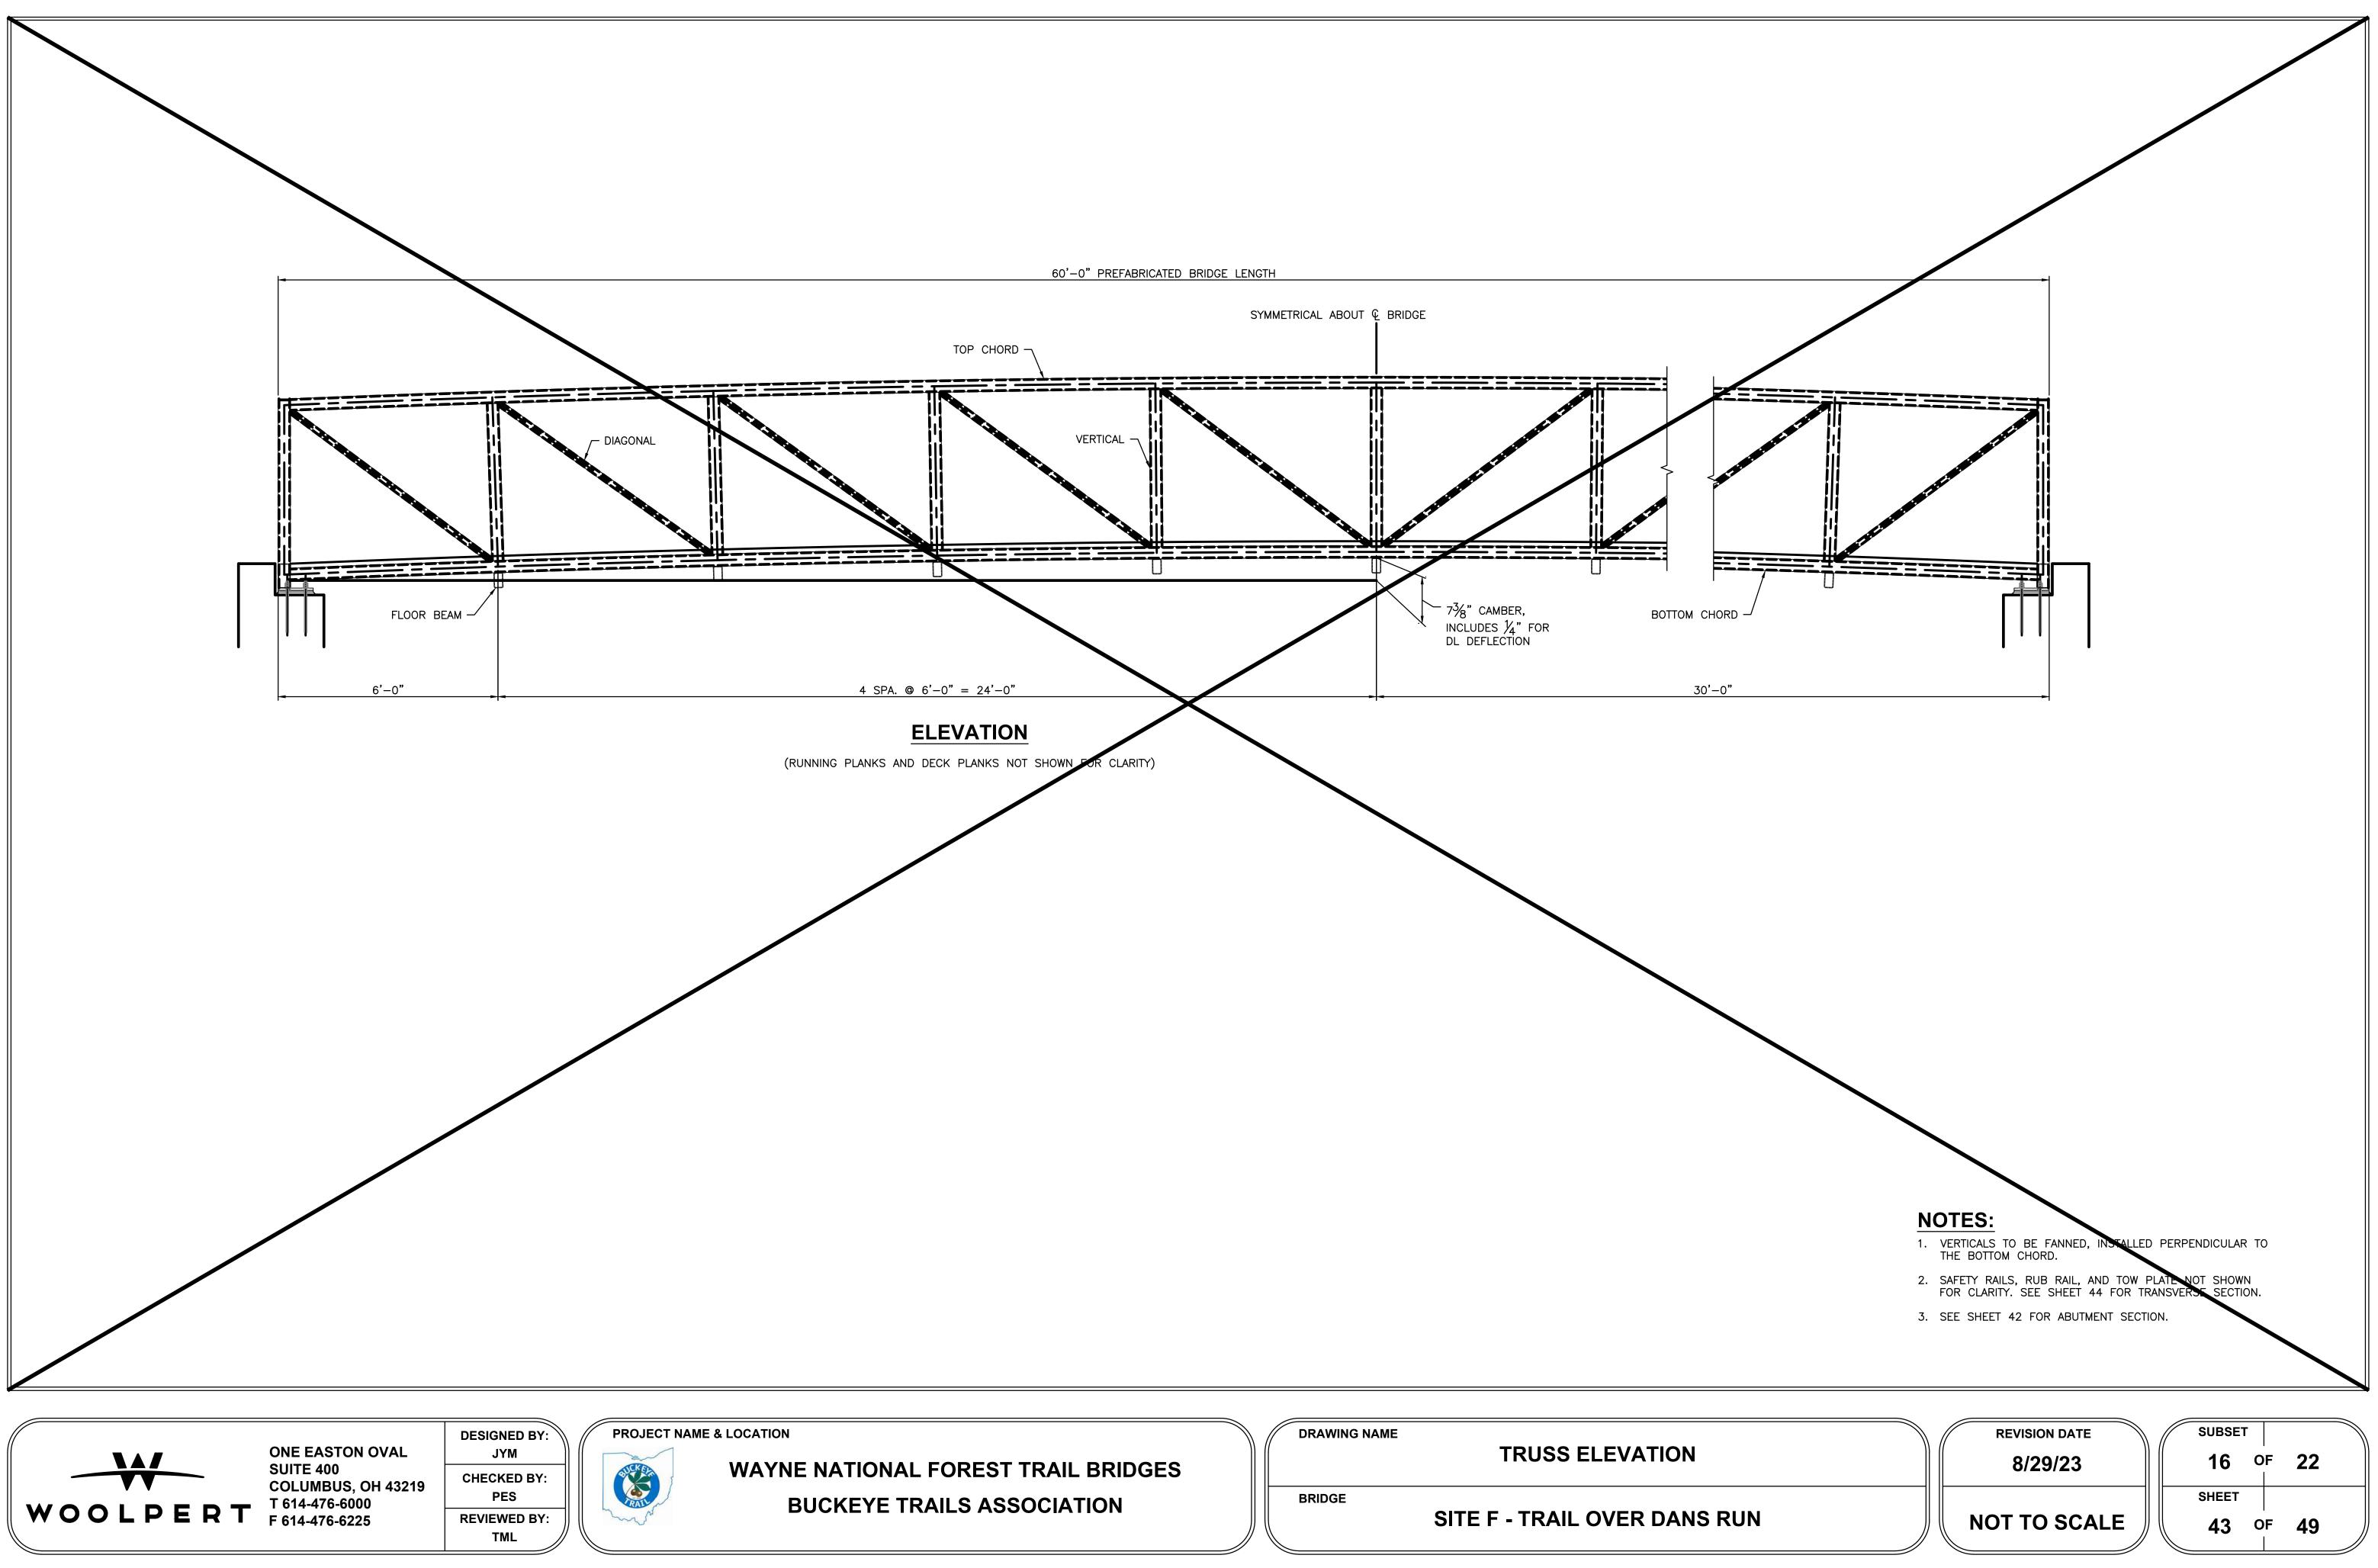

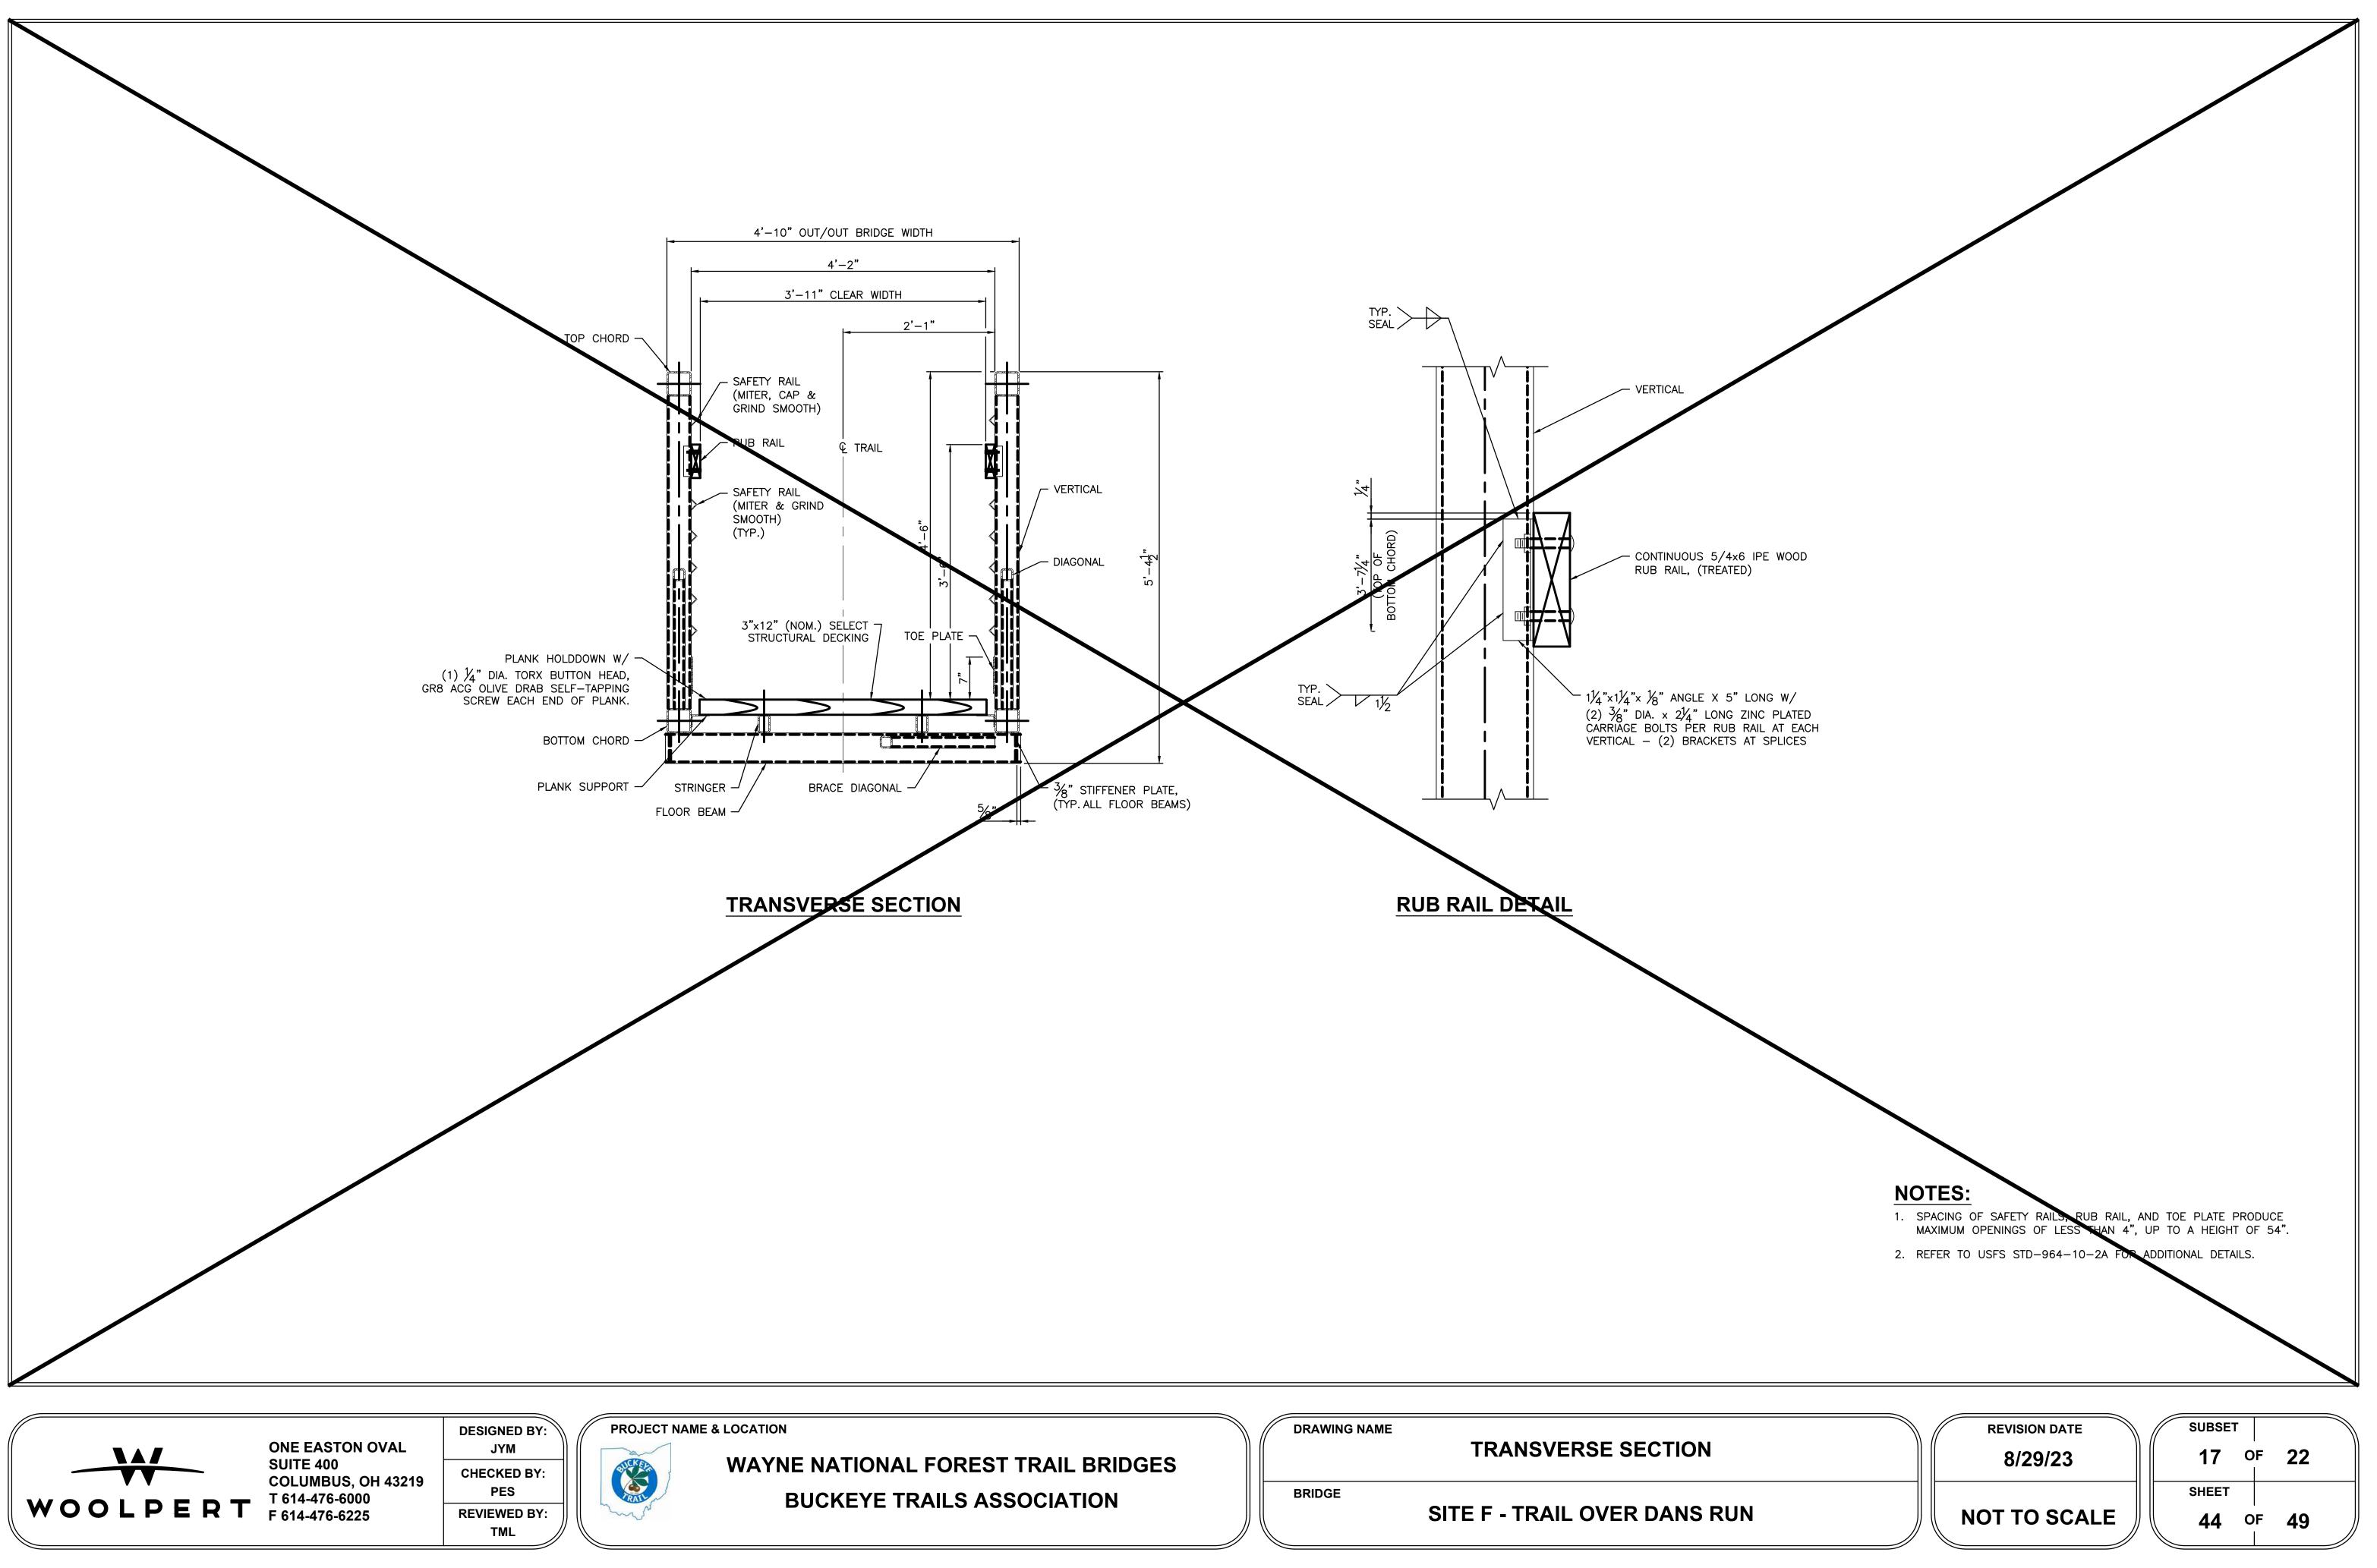

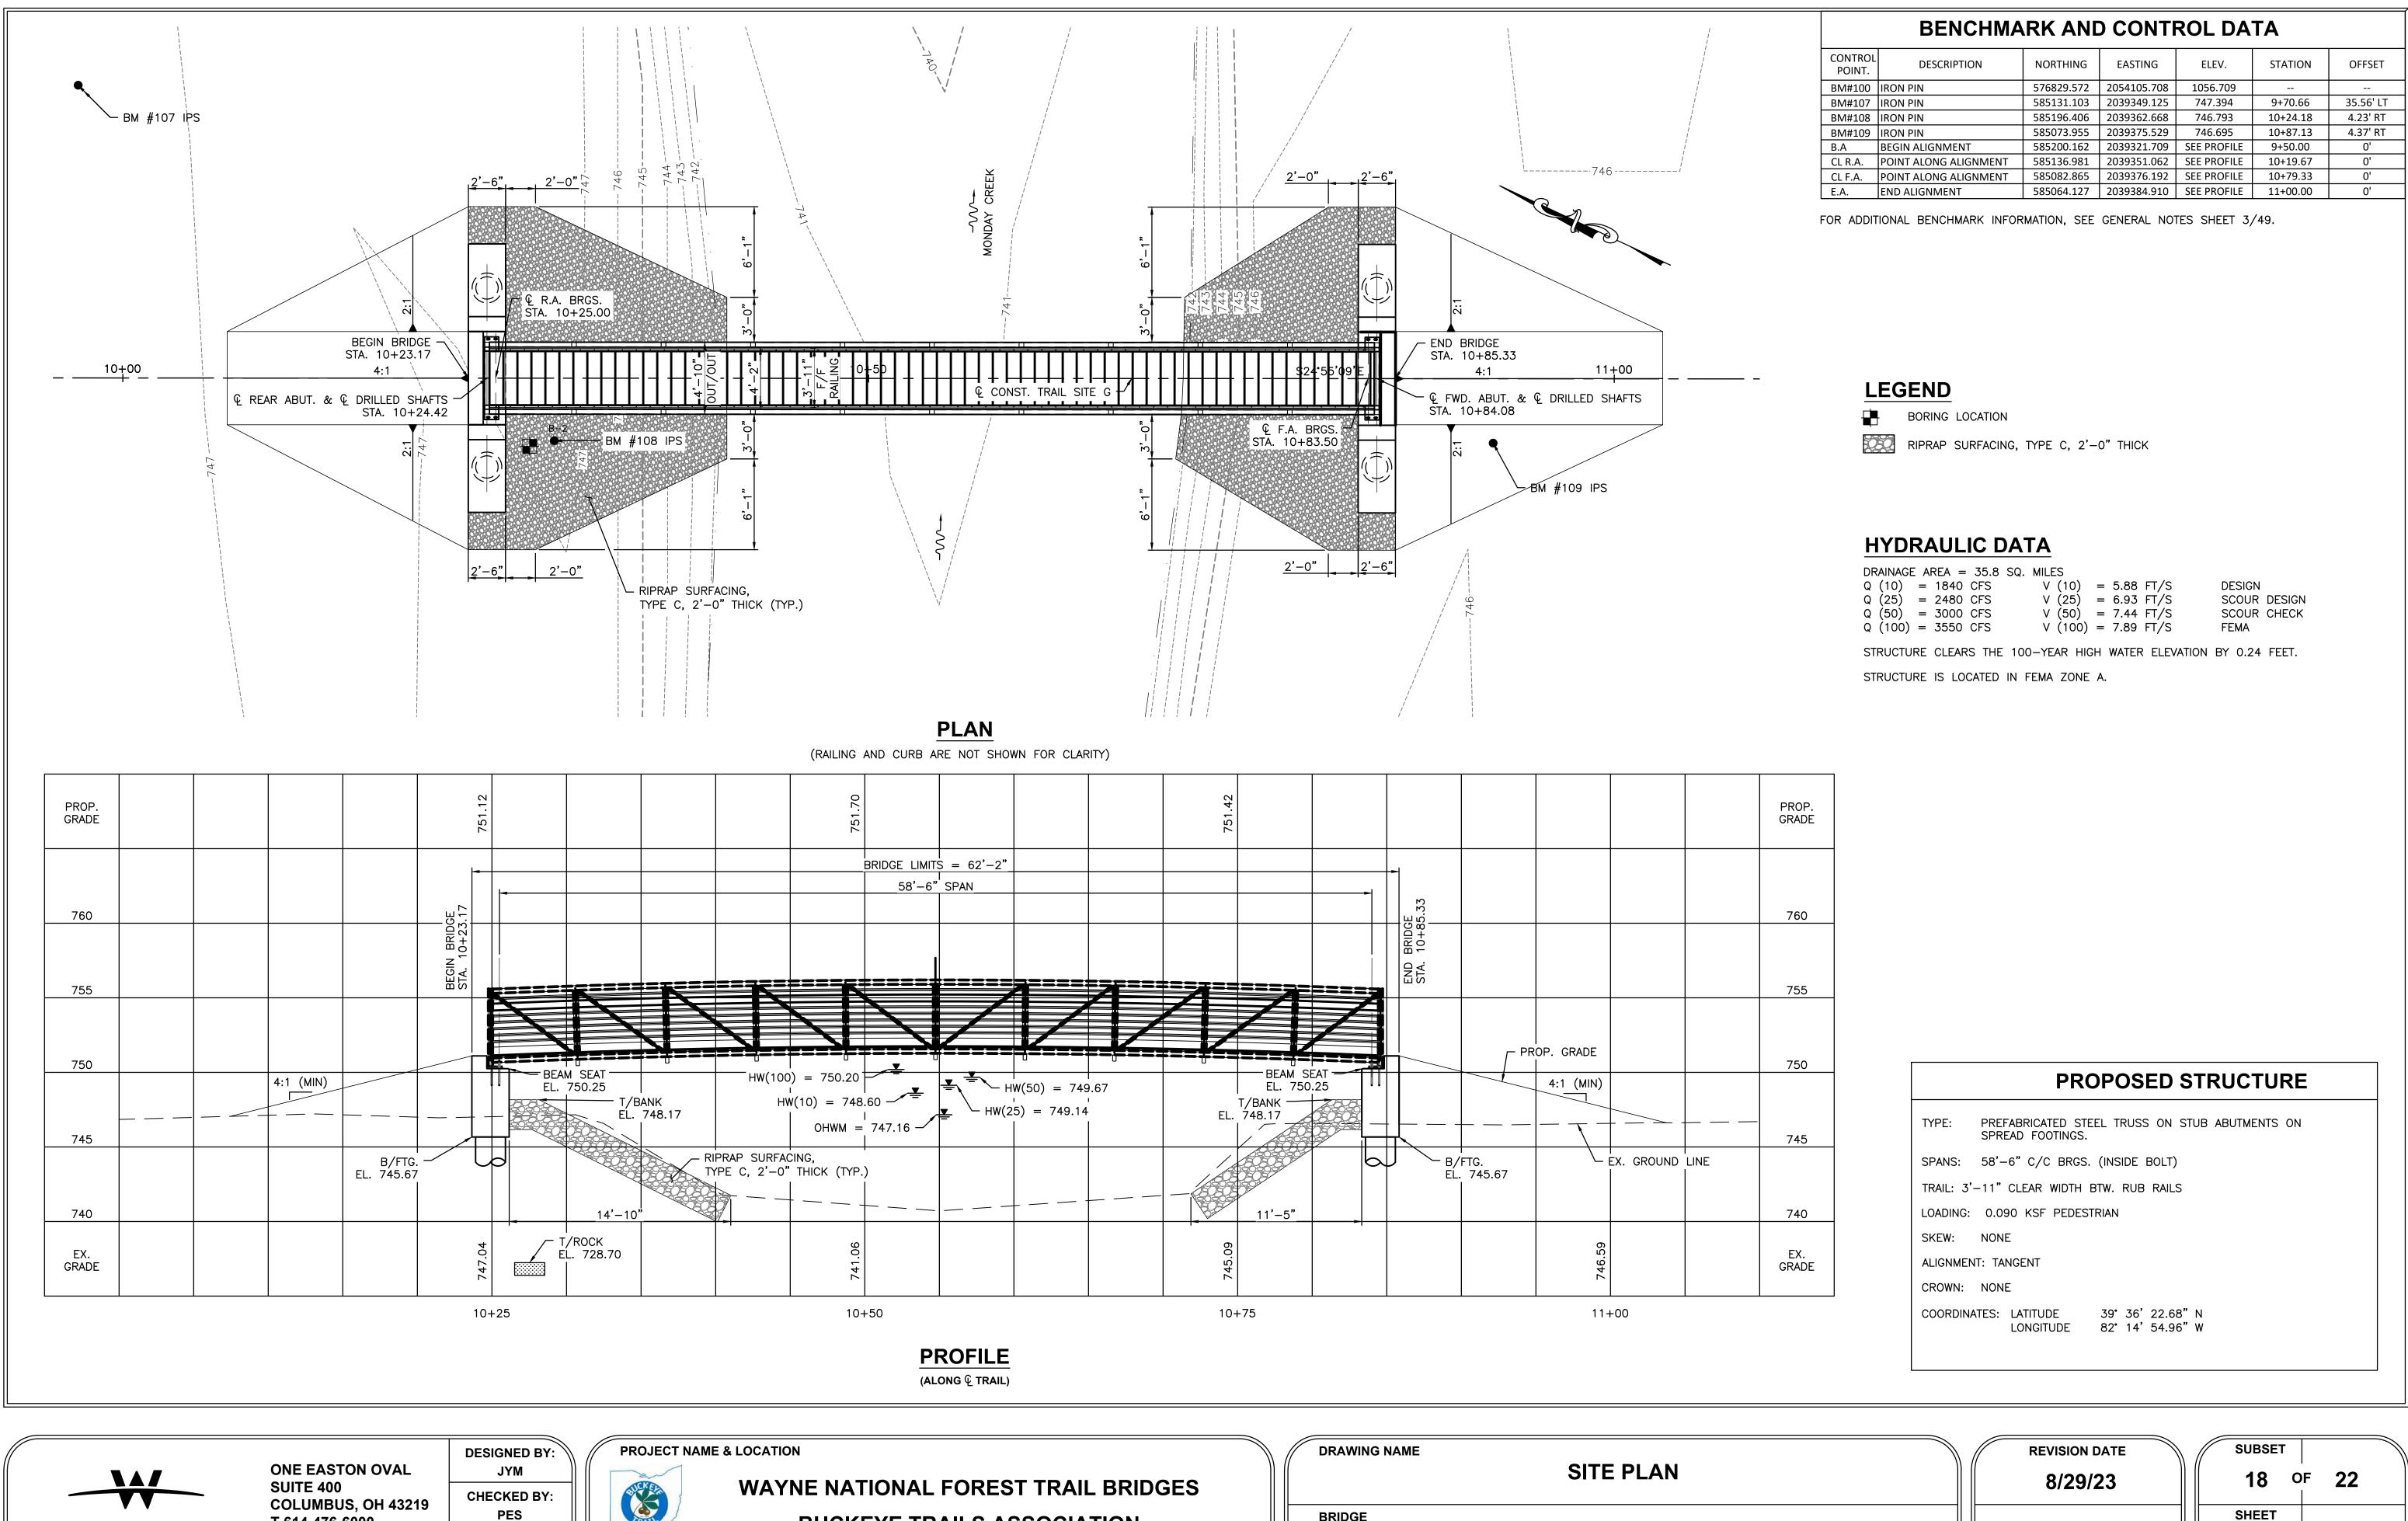

SUITE 400 COLUMBUS, OH 43219 T 614-476-6000 F 614-476-6225 WOOLPERT

CHECKED BY: PES **REVIEWED BY:** TML


my


# WAYNE NATIONAL FOREST TRAIL BRIDGES **BUCKEYE TRAILS ASSOCIATION**


BRIDGE SITE G - NCT ATHENS CENTRAL #5 OVER MONDAY CREEK


	BENCHMARK AND CONTROL DATA								
CONTROL POINT.	DESCRIPTION	NORTHING	EASTING	ELEV.	STATION	OFFSET			
BM#100	IRON PIN	576829.572	2054105.708	1056.709					
BM#107	IRON PIN	585131.103	2039349.125	747.394	9+70.66	35.56' LT			
BM#108	IRON PIN	585196.406	2039362.668	746.793	10+24.18	4.23' RT			
BM#109	IRON PIN	585073.955	2039375.529	746.695	10+87.13	4.37' RT			
B.A	BEGIN ALIGNMENT	585200.162	2039321.709	SEE PROFILE	9+50.00	0'			
CL R.A.	POINT ALONG ALIGNMENT	585136.981	2039351.062	SEE PROFILE	10+19.67	0'			
CL F.A.	POINT ALONG ALIGNMENT	585082.865	2039376.192	SEE PROFILE	10+79.33	0'			
E.A.	END ALIGNMENT	585064.127	2039384.910	SEE PROFILE	11+00.00	0'			


DRAINAGE AREA = 35.8 SQ.	MILES	
Q (10) = 1840 CFS	V (10) = 5.88 FT/S	DESIGN
Q (25) = 2480 CFS	V (25) = 6.93 FT/S	SCOUR DESIGN
Q (50) = 3000 CFS	V (50) = 7.44 FT/S	SCOUR CHECK
Q (100) = 3550 CFS	V (100) = 7.89 FT/S	FEMA
STRUCTURE CLEARS THE 10	0-YEAR HIGH WATER ELEVATION	BY 0.24 FEET.

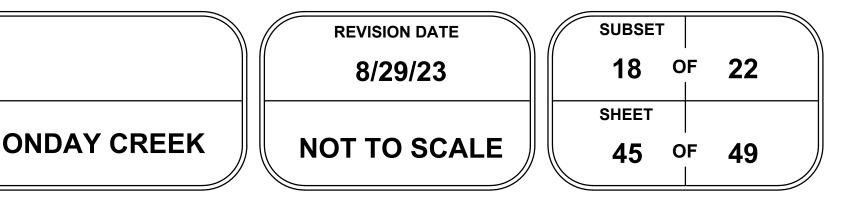

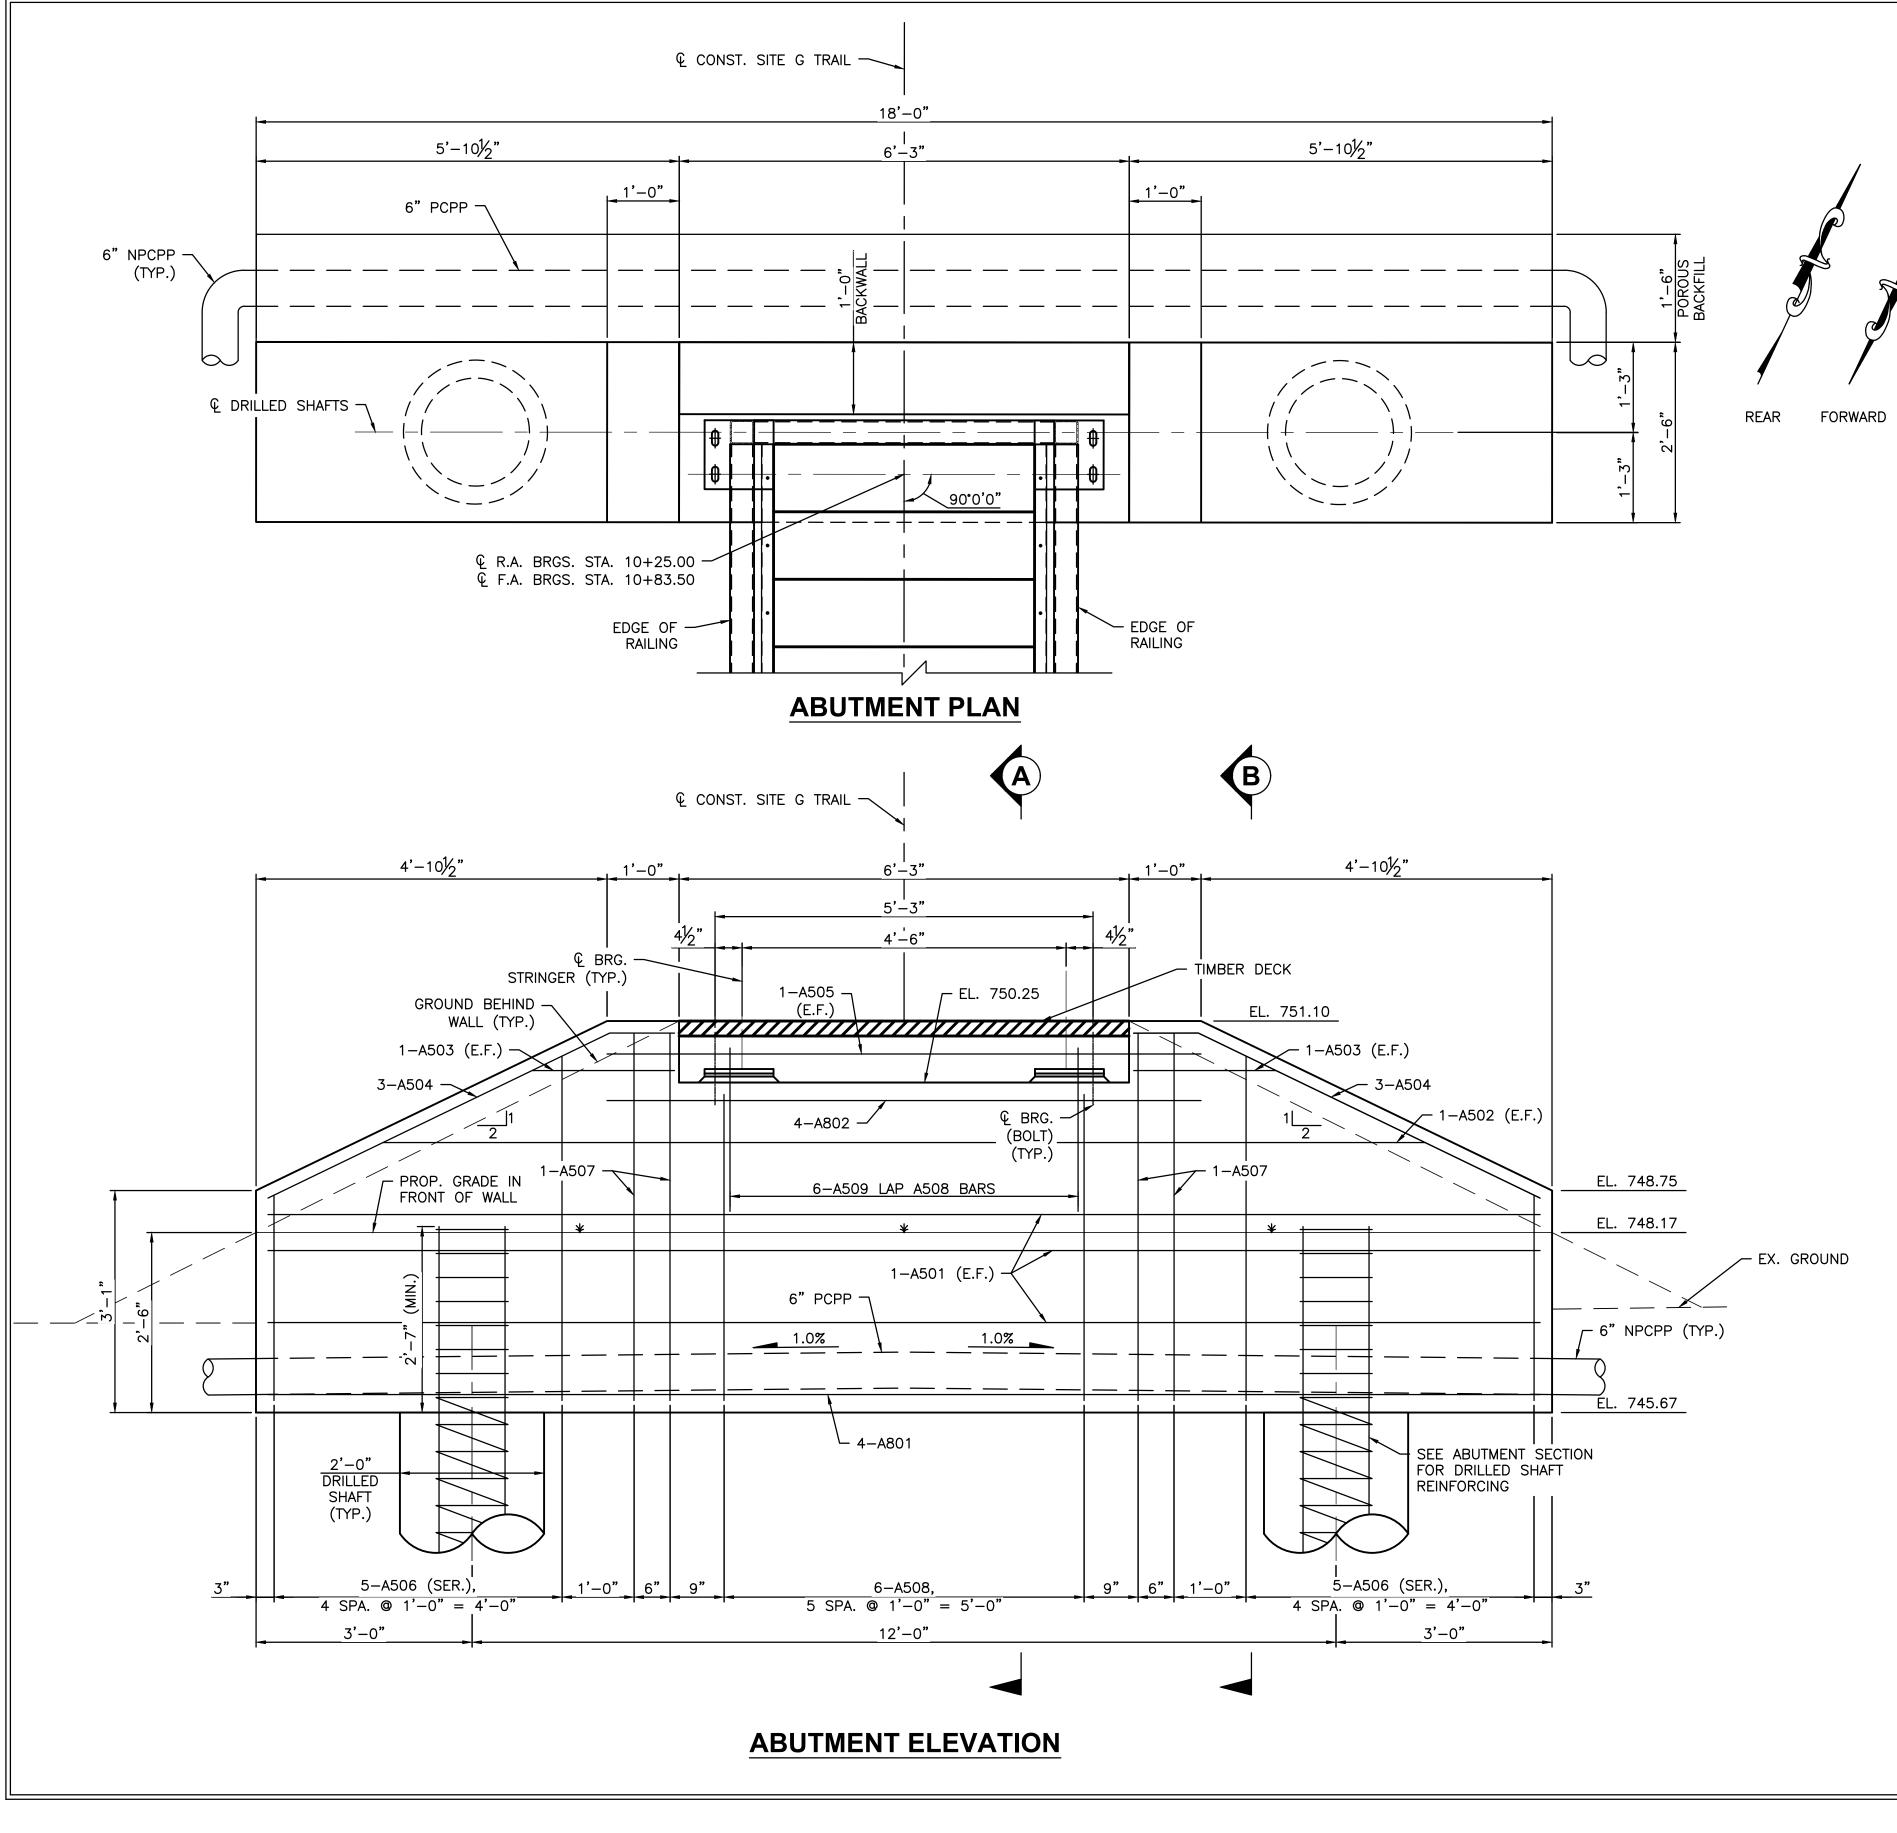

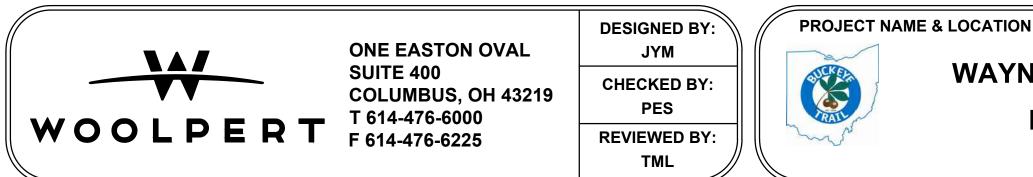

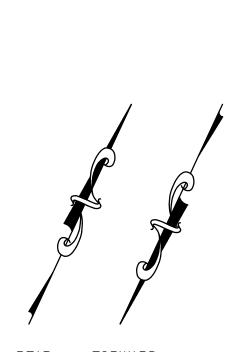

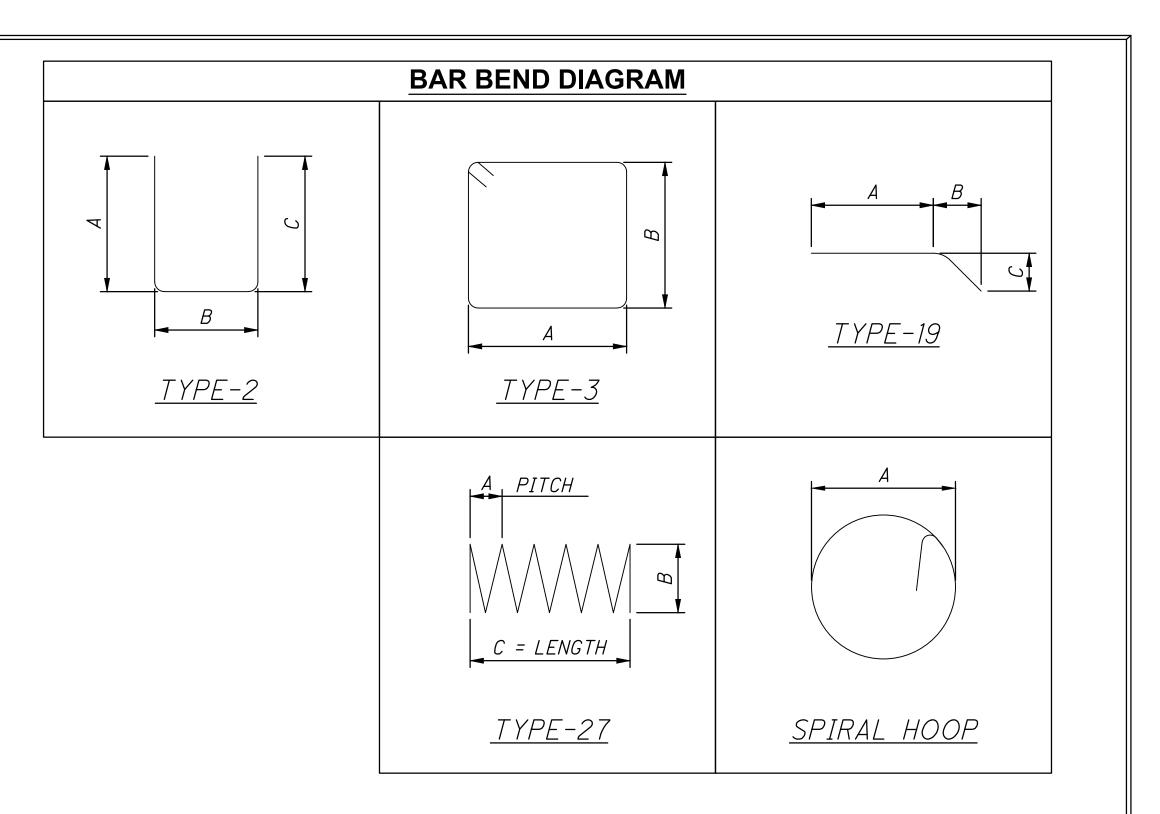

				SI	TE G AI	BUTME	NT				
MARK			WEIGHT			DIMENSIONS					
MARK	NUMBER	LENGTH	(LBS)	TYPE	А	В	С	D	E	R	INC.
A501	12	17'-6"	220	ST.							
A502	4	14'-5"	61	ST.							
A503	8	1'-11"	16	ST.							
A504	12	6'-0"	76	19	5'-3"	9"	4"				
A505	4	8'-3"	35	ST.							
	4	10'-0"				2'-9"					
A506	SER. OF	то	256	3	2'-0"	ТО					13 1/2"
	5	14'-6"				5'-0"					
A507	8	14'-9"	124	3	2'-0"	5'-1"					
A508	12	13'-0"	163	3	2'-0"	4'-3"					
A509	12	5'-3"	66	2	2'-5"	8"	2'-5"				
A801	8	17'-6"	374	ST.							
A802	8	8'-3"	177	ST.							
DS401	28	3'-6"	66	HOOP	1'-0"						
DS702	32	22'-3"	1456	ST.	1-0						
SP401	4	167'-8"	474	27	4.5"	1'-0"	19'-11"				
	1					I	1		1	ļ	1
	TOTAL		3564								

DRAWING NAME

BRIDGE


**ABUTMENT PLAN AND ELEVATION** 


WAYNE NATIONAL FOREST TRAIL BRIDGES **BUCKEYE TRAILS ASSOCIATION** 

SITE G - NCT ATHENS CENTRAL #5 OVER MONDAY CREEK

- 1. SEE SHEET 47/49 FOR SECTION A AND SECTION B.
- 2. THE BAR SIZE NUMBER IS SPECIFIED ON THE PLANS IN THE BAR MARK COLUMN. THE FIRST DIGIT AFTER THE LETTERS WHERE THREE DIGITS ARE USED, AND THE FIRST TWO DIGITS AFTER THE LETTERS WHERE FOUR ARE USED, INDICATES THE BAR SIZE NUMBER. FOR EXAMPLE, A501 IS A NO. 5 BAR IN THE ABUTMENT. A LEGEND OF THE DESCRIPTORS IS GIVEN BELOW:

- 3. BAR DIMENSIONS SHOWN ARE OUT-TO-OUT UNLESS OTHERWISE NOTED.
- 4. "ST." INDICATES A STRAIGHT BAR.

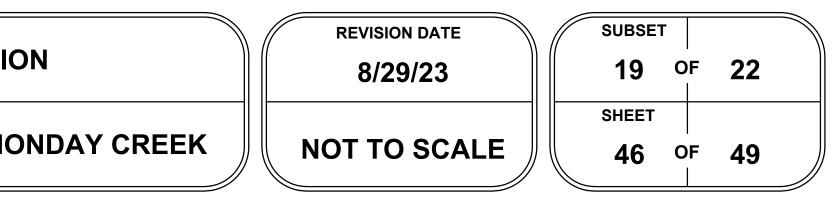

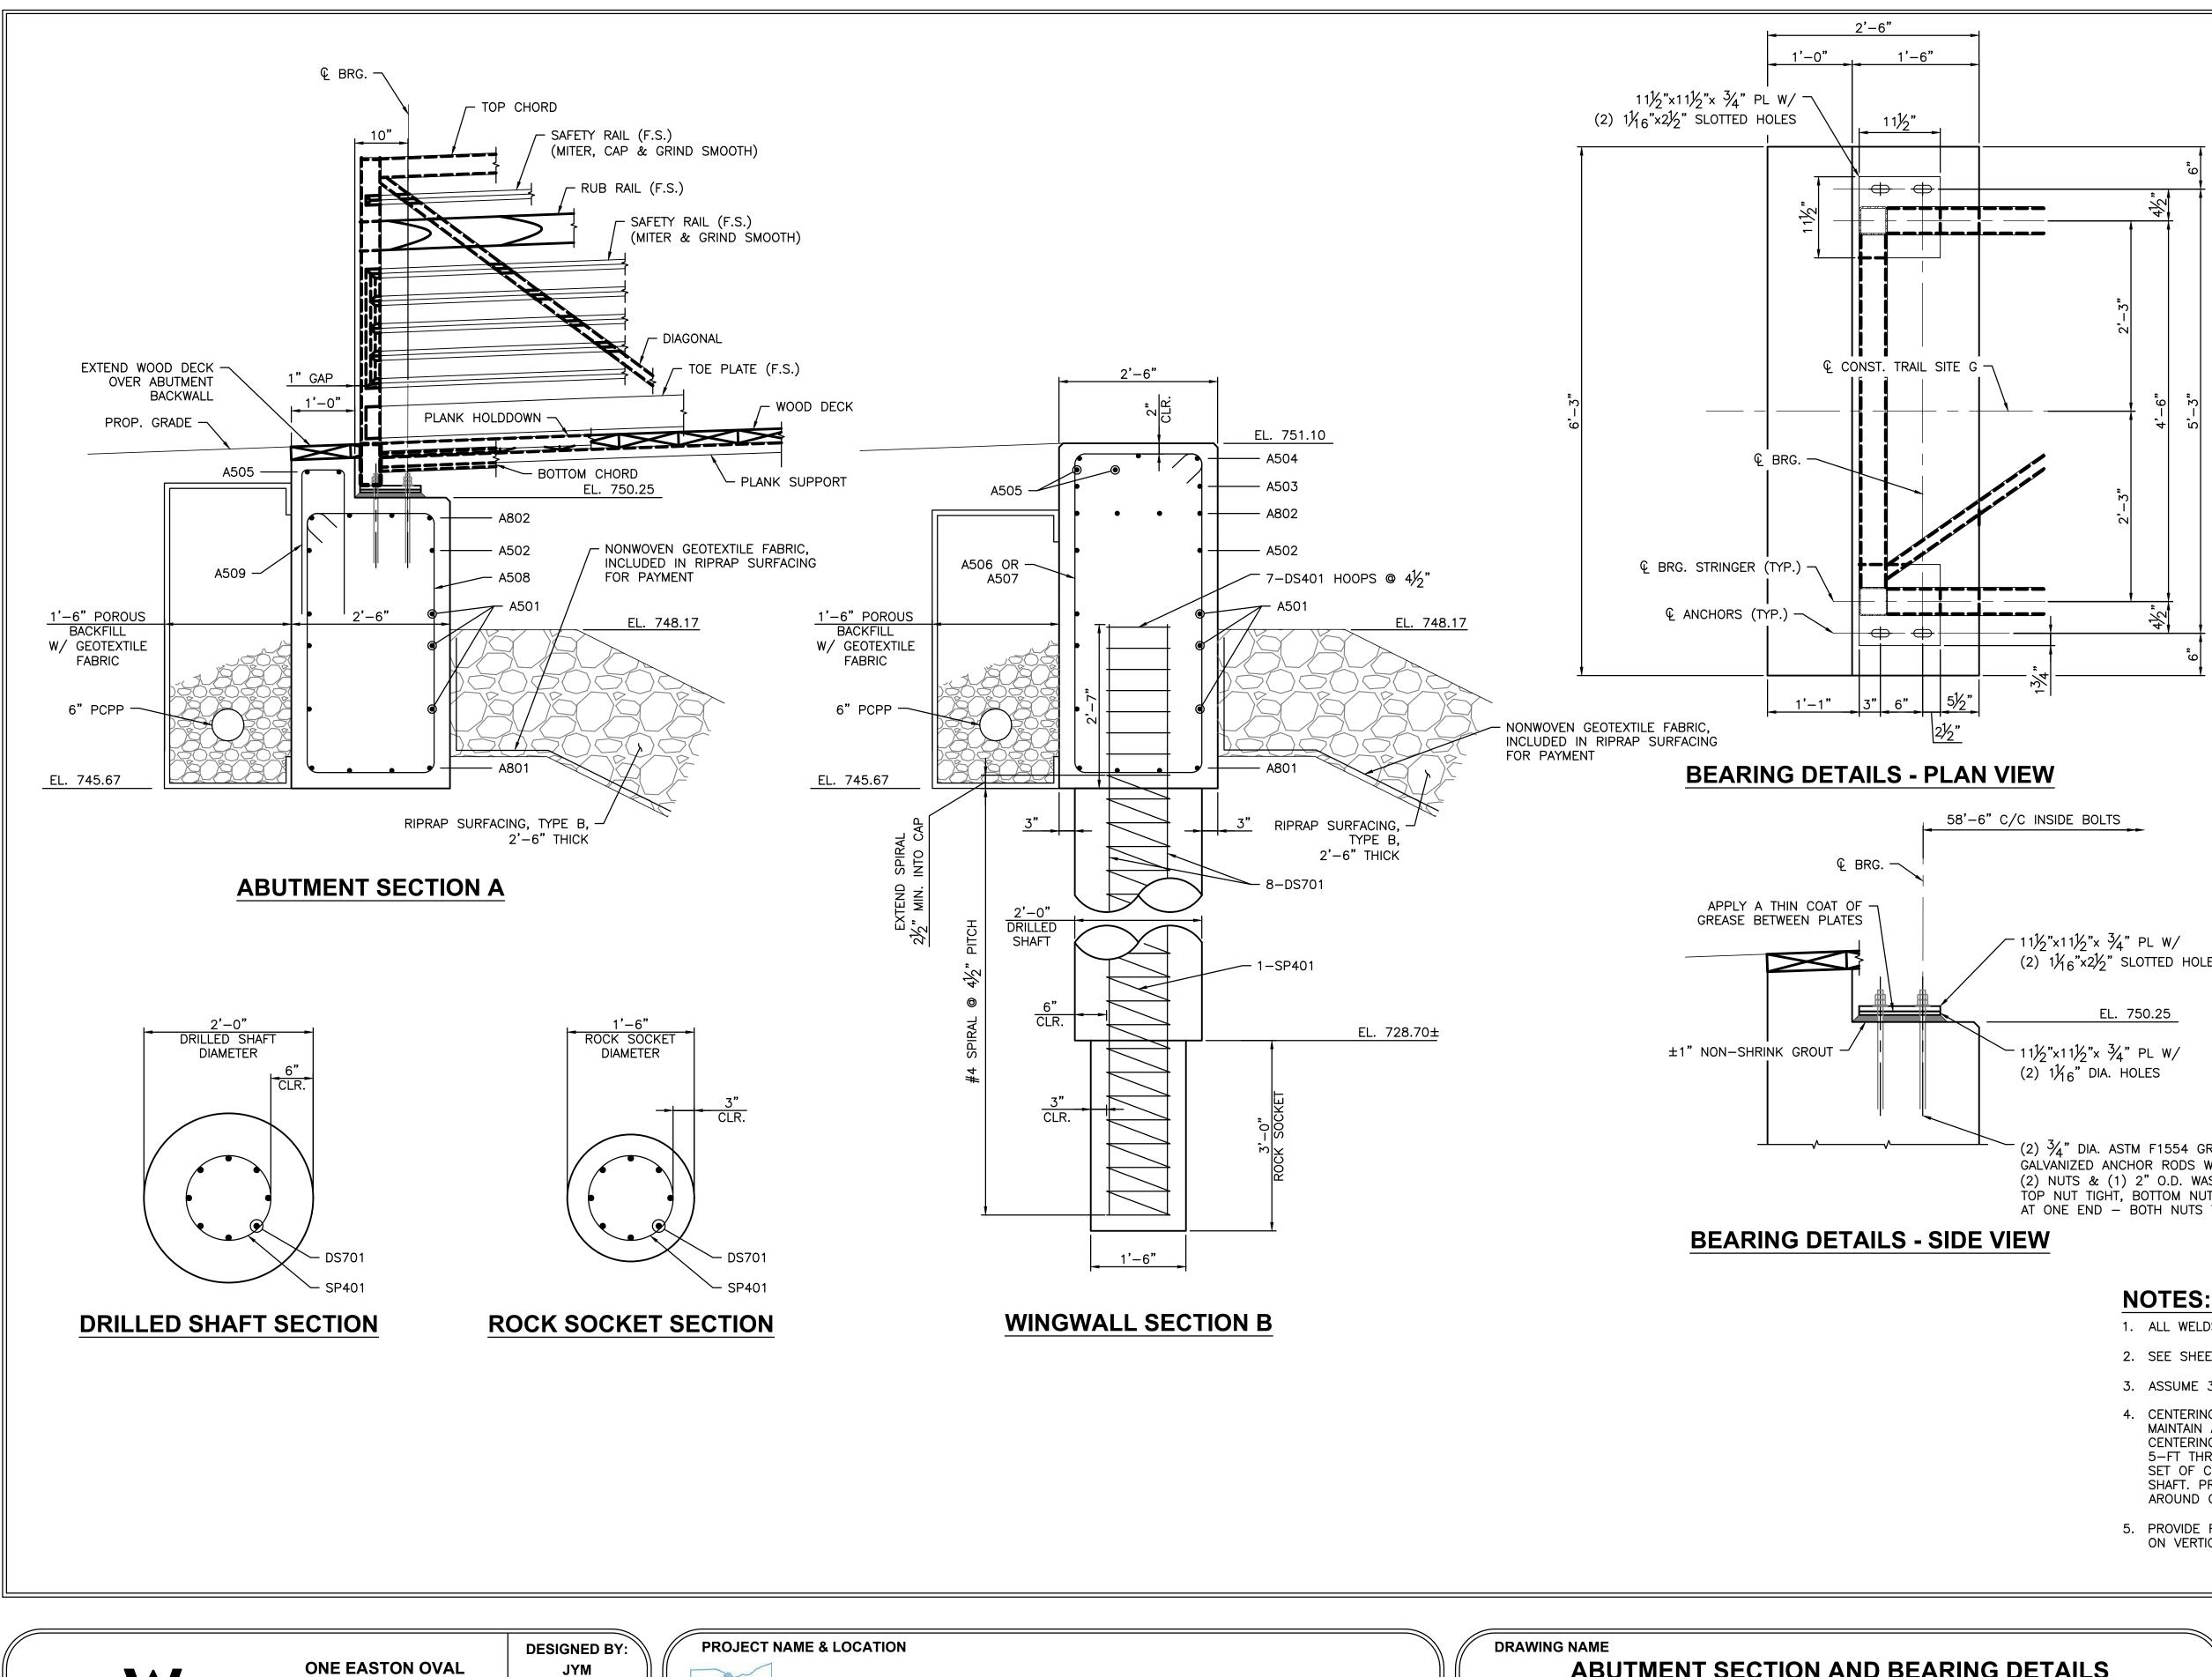

WAYNE NATIONAL FOREST TRAIL BRIDGES **BUCKEYE TRAILS ASSOCIATION** 

WOOLPERT

SUITE 400

T 614-476-6000

F 614-476-6225

COLUMBUS, OH 43219

STORE STORE

**CHECKED BY:** 

PES

**REVIEWED BY:** 

TML

**ABUTMENT SECTION AND BEARING DETAILS** 


SITE G - NCT ATHENS CENTRAL #5 OVER MONDAY CREEK


BRIDGE


(2) 1/16"x21/2" SLOTTED HOLES

- (2)  $\frac{3}{4}$ " DIA. ASTM F1554 GRADE 36 GALVANIZED ANCHOR RODS W/ (2) NUTS & (1) 2" O.D. WASHER EACH. TOP NUT TIGHT, BOTTOM NUT FINGER TIGHT AT ONE END – BOTH NUTS TIGHT OTHER END.

- 1. ALL WELDS TO BE VISUALLY INSPECTED.
- 2. SEE SHEET 46/49 FOR ABUTMENT PLAN AND ELEVATION.
- 3. ASSUME 3" CONCRETE COVER UNLESS NOTED OTHERWISE.
- 4. CENTERING DEVICES SHALL BE REQUIRED DURING CONSTRUCTION TO MAINTAIN ALIGNMENT OF CAGES AND MIN. CONCRETE COVER. CENTERING DEVICES SHALL BE PLACED AT INTERVALS NOT EXCEEDING 5-FT THROUGHOUT THE LENGTH OF THE SHAFT. PROVIDE MIN. ONE SET OF CENTERING DEVICES WITHIN 2-FT TOP AND 2-FT BOTTOM OF SHAFT. PROVIDE CENTERING DEVICES MIN. 60-DEGREE INTERVALS AROUND CIRCUMFERENCE OF SHAFT.
- 5. PROVIDE FEET (BOTTOM SUPPORTS) AT THE BOTTOM OF THE SHAFT ON VERTICAL BÀRS.

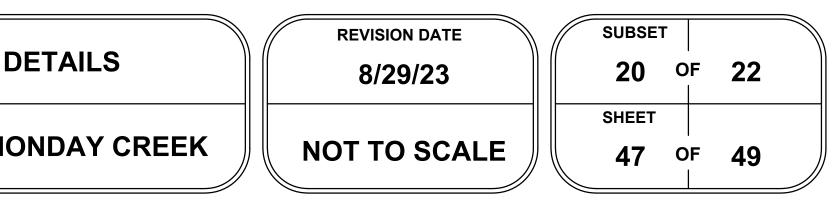

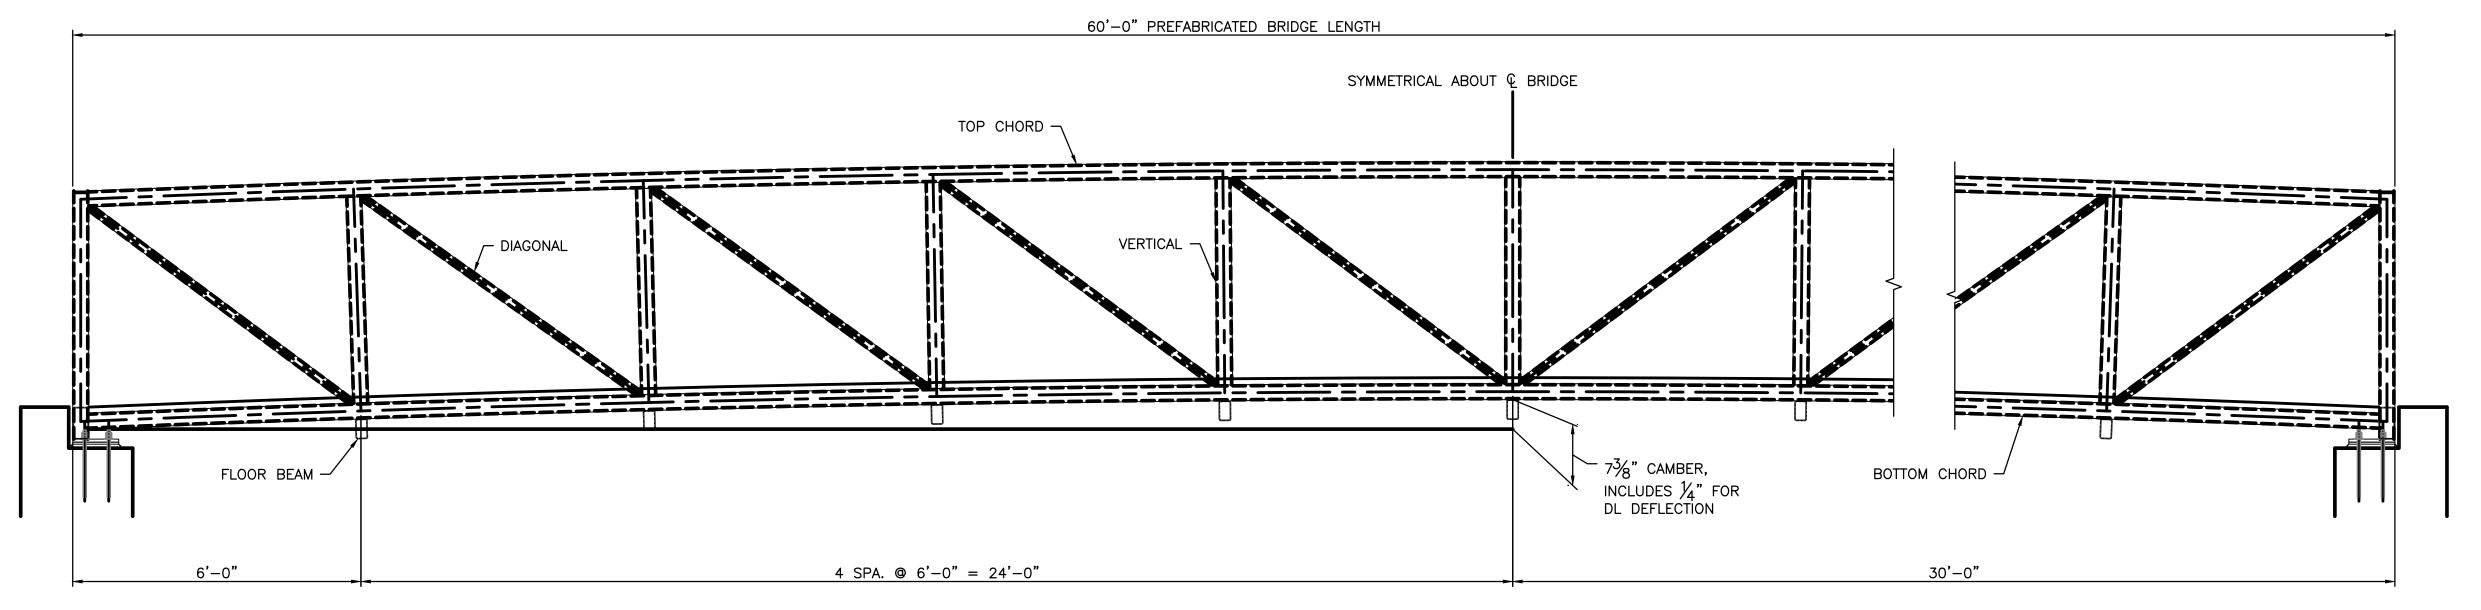

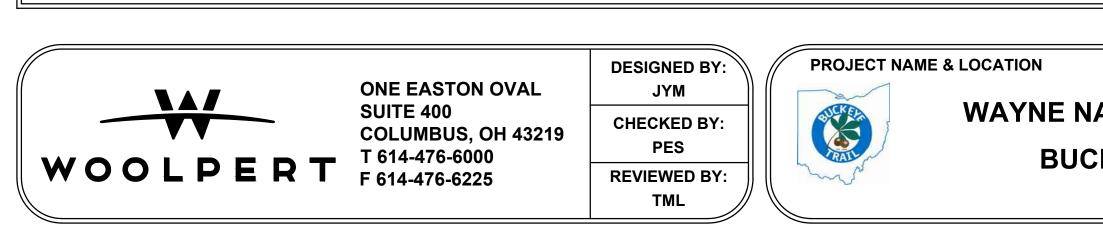

# ELEVATION

(RUNNING PLANKS AND DECK PLANKS NOT SHOWN FOR CLARITY)


WAYNE NATIONAL FOREST TRAIL BRIDGES **BUCKEYE TRAILS ASSOCIATION** 


DRAWING NAME

**TRUSS ELEVATION** 


BRIDGE SITE G - NCT ATHENS CENTRAL #5 OVER MONDAY CREEK


- 1. VERTICALS TO BE FANNED, INSTALLED PERPENDICULAR TO THE BOTTOM CHORD.
- 2. SAFETY RAILS, RUB RAIL, AND TOW PLATE NOT SHOWN FOR CLARITY. SEE SHEET 49 FOR TRANSVERSE SECTION.
- 3. SEE SHEET 47 FOR ABUTMENT SECTION.

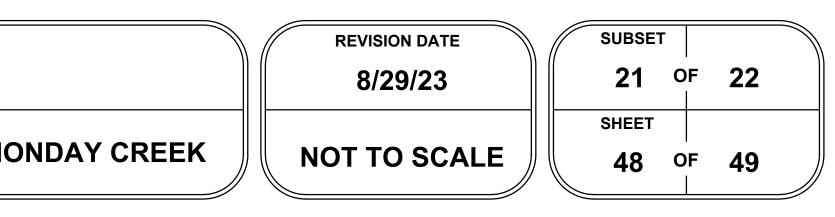

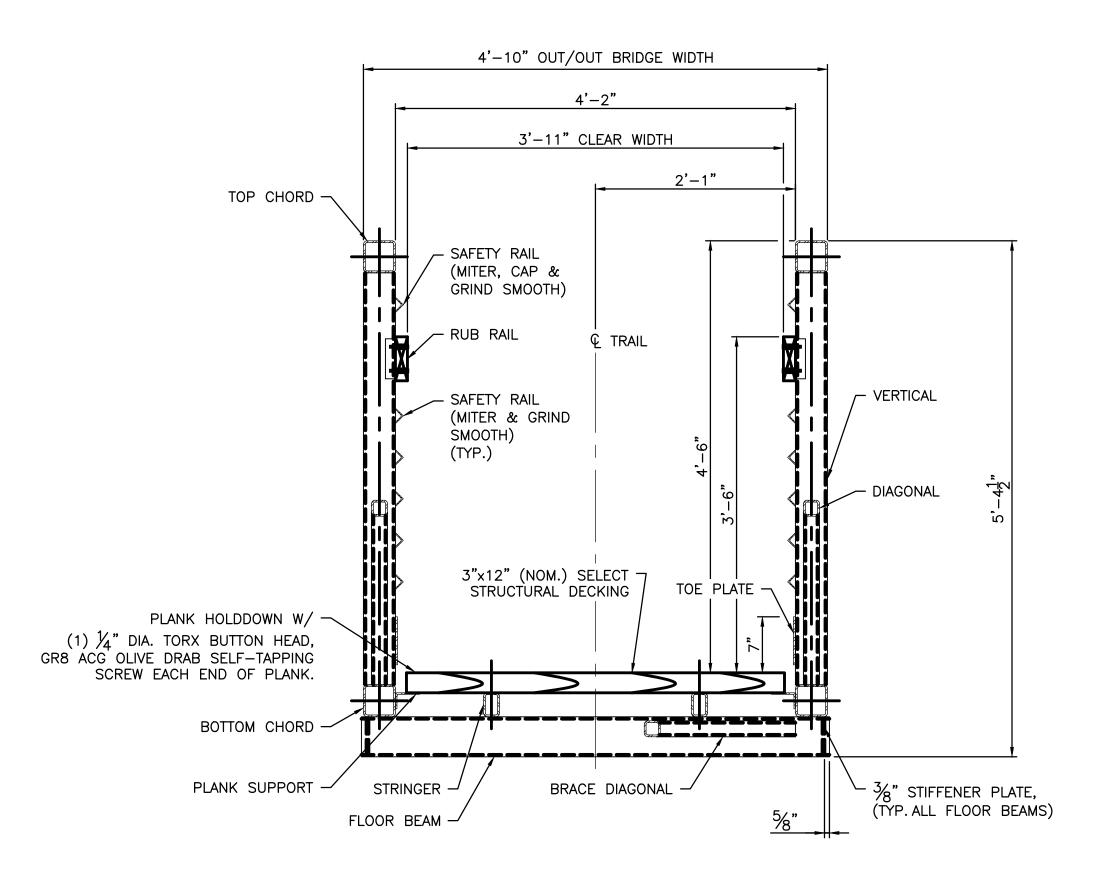

# **TRANSVERSE SECTION**

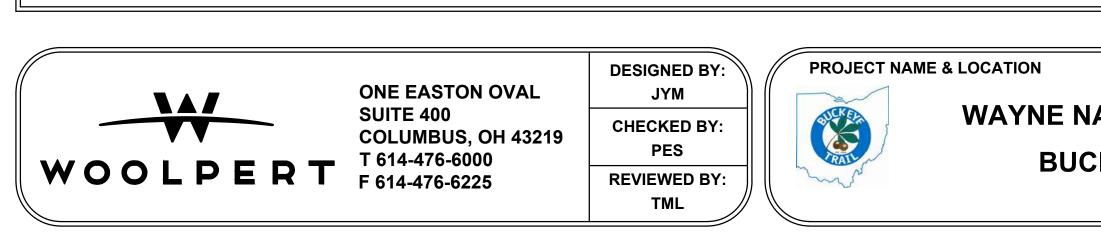

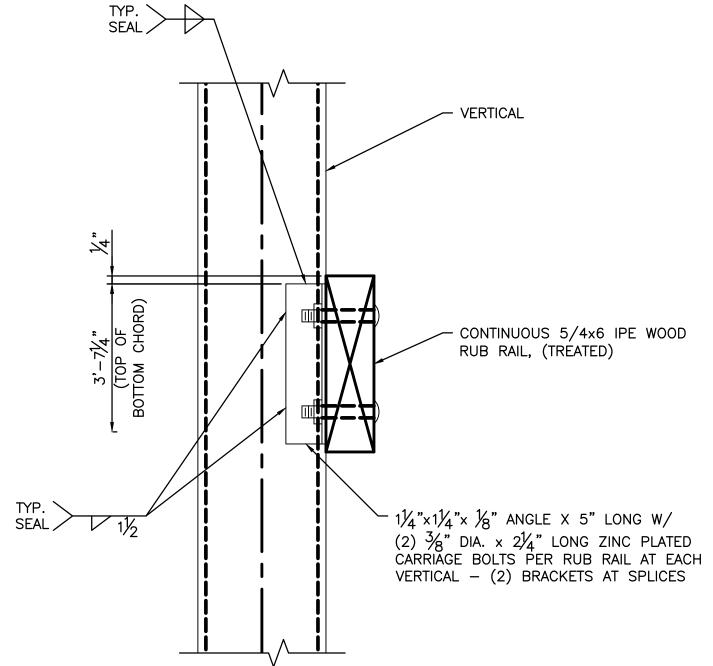

### **RUB RAIL DETAIL**

# WAYNE NATIONAL FOREST TRAIL BRIDGES **BUCKEYE TRAILS ASSOCIATION**

DRAWING NAME

BRIDGE

**TRANSVERSE SECTION** 

SITE G - NCT ATHENS CENTRAL #5 OVER MONDAY CREEK

- 1. SPACING OF SAFETY RAILS, RUB RAIL, AND TOE PLATE PRODUCE MAXIMUM OPENINGS OF LESS THAN 4", UP TO A HEIGHT OF 54".
- 2. REFER TO USFS STD-964-10-2A FOR ADDITIONAL DETAILS.

